


CERTIFICATE of SURVEY

F. J. ARMSTRONG
Civil Engineer and Surveyor
ST. PAUL, MINN.

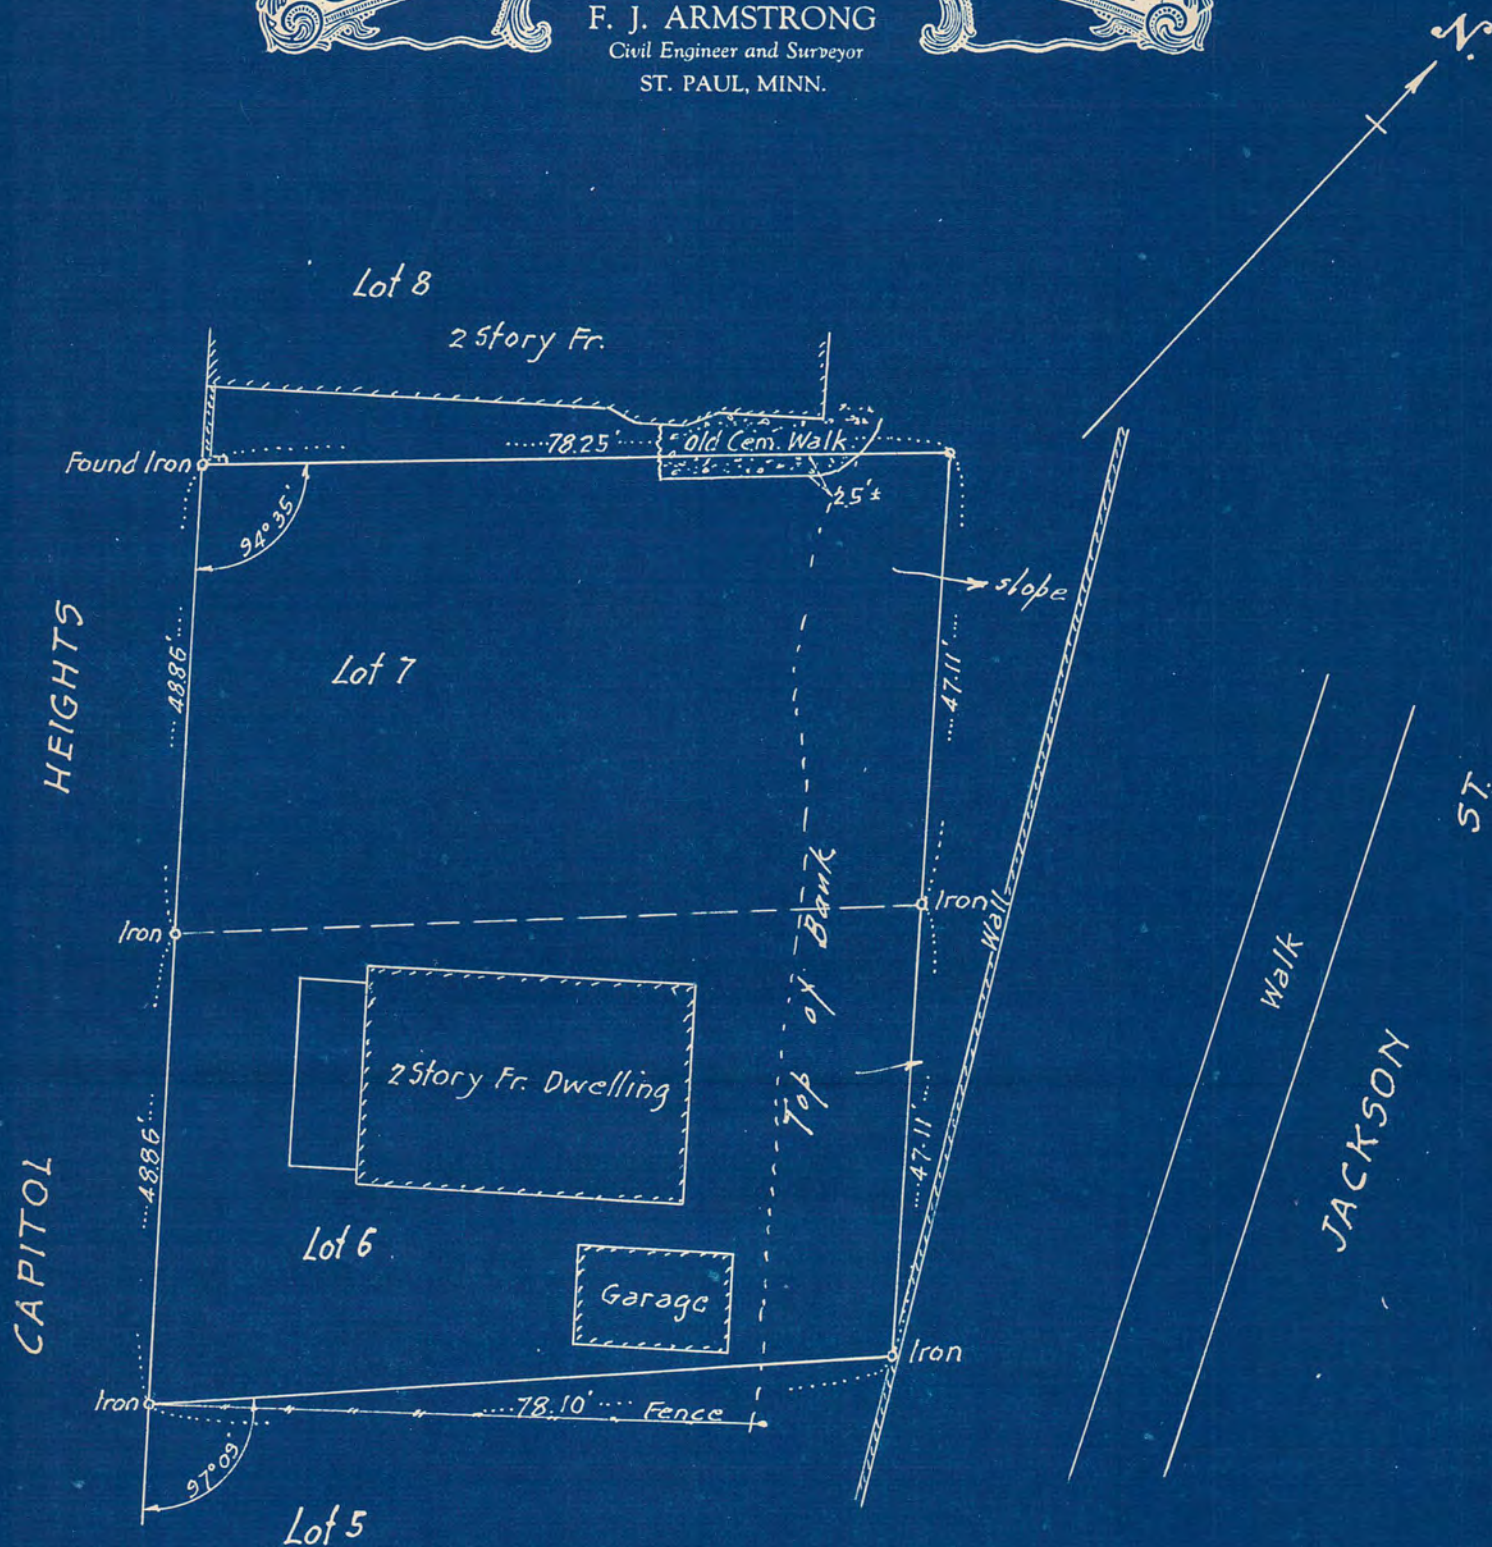

Scale 1" = 20'

5173

I HEREBY CERTIFY that on the 22nd day of August, A. D. 1946,
I made a survey of the following described property, to-wit: Lots 6 and 7 Bass'
Rearrangement of Blocks 19-20-21 and 23, Ashton and
Sherburne's Addition, St. Paul, Minn.
and the map hereon shown is a true and correct map of said survey and that the improvements thereon
indicated are correctly shown.

Subscribed and sworn to before me this
17th day of Sept., 1946
(Edward J. Mason)
Notary Public.

My Commission Expires July 7, 1948

F. J. Armstrong
Civil Engineer.