


SURVEY OF
W. 1/2 of N.E. 1/4 of N.W. 1/4 of N.E. 1/4 of
Section 27, T.29 N., R.22 W.

Blattogram
Registered Land Surveyor.

Sept., 1946.

Scale - 1 in. = 100 ft.

• Indicates Iron.

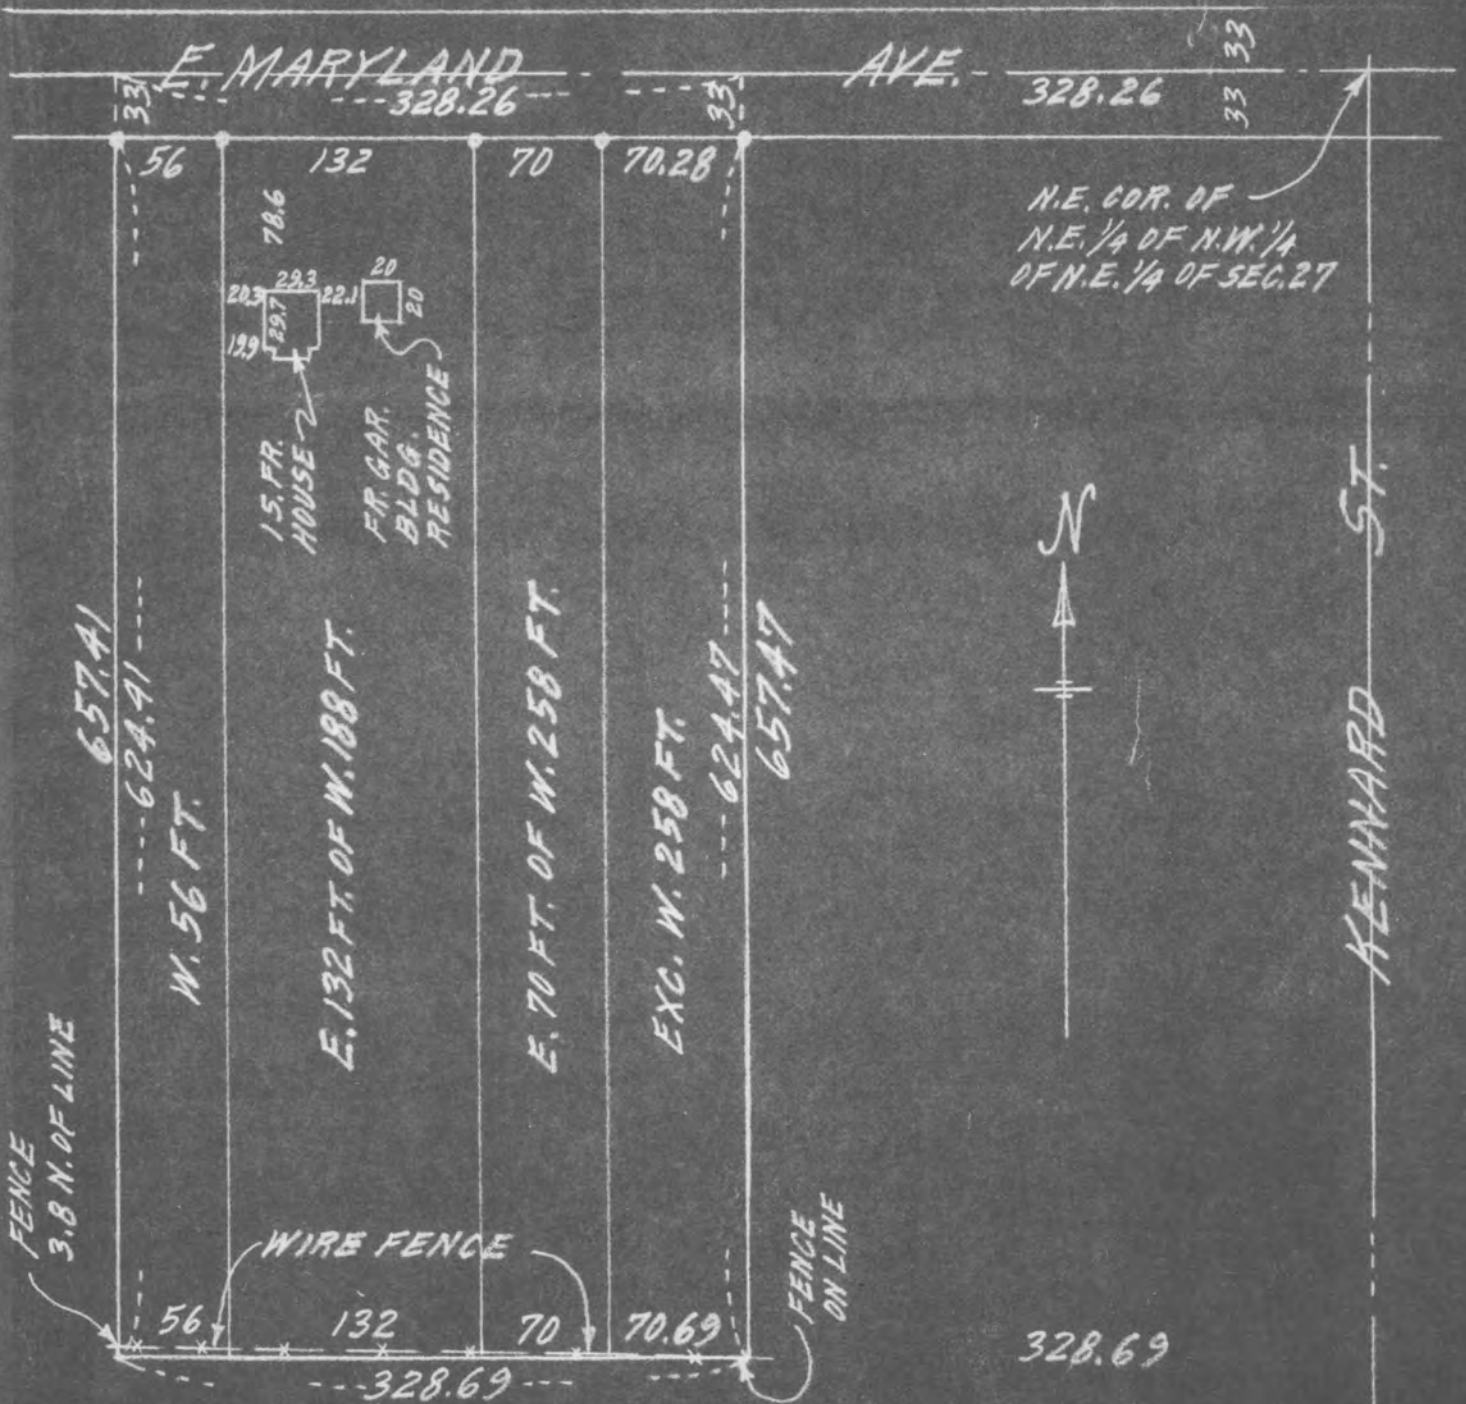

5244