

SURVEY OF

Lot 2, Block 3,

Mackubin & Marshall's Addition to St. Paul

except part thereof taken for University Ave. widenings.

Jan., 23, 1947.


R. E. Wolgram

Registered Land Surveyor.

Scale - 1 in. = 10 ft.

UNIVERSITY

AVE.

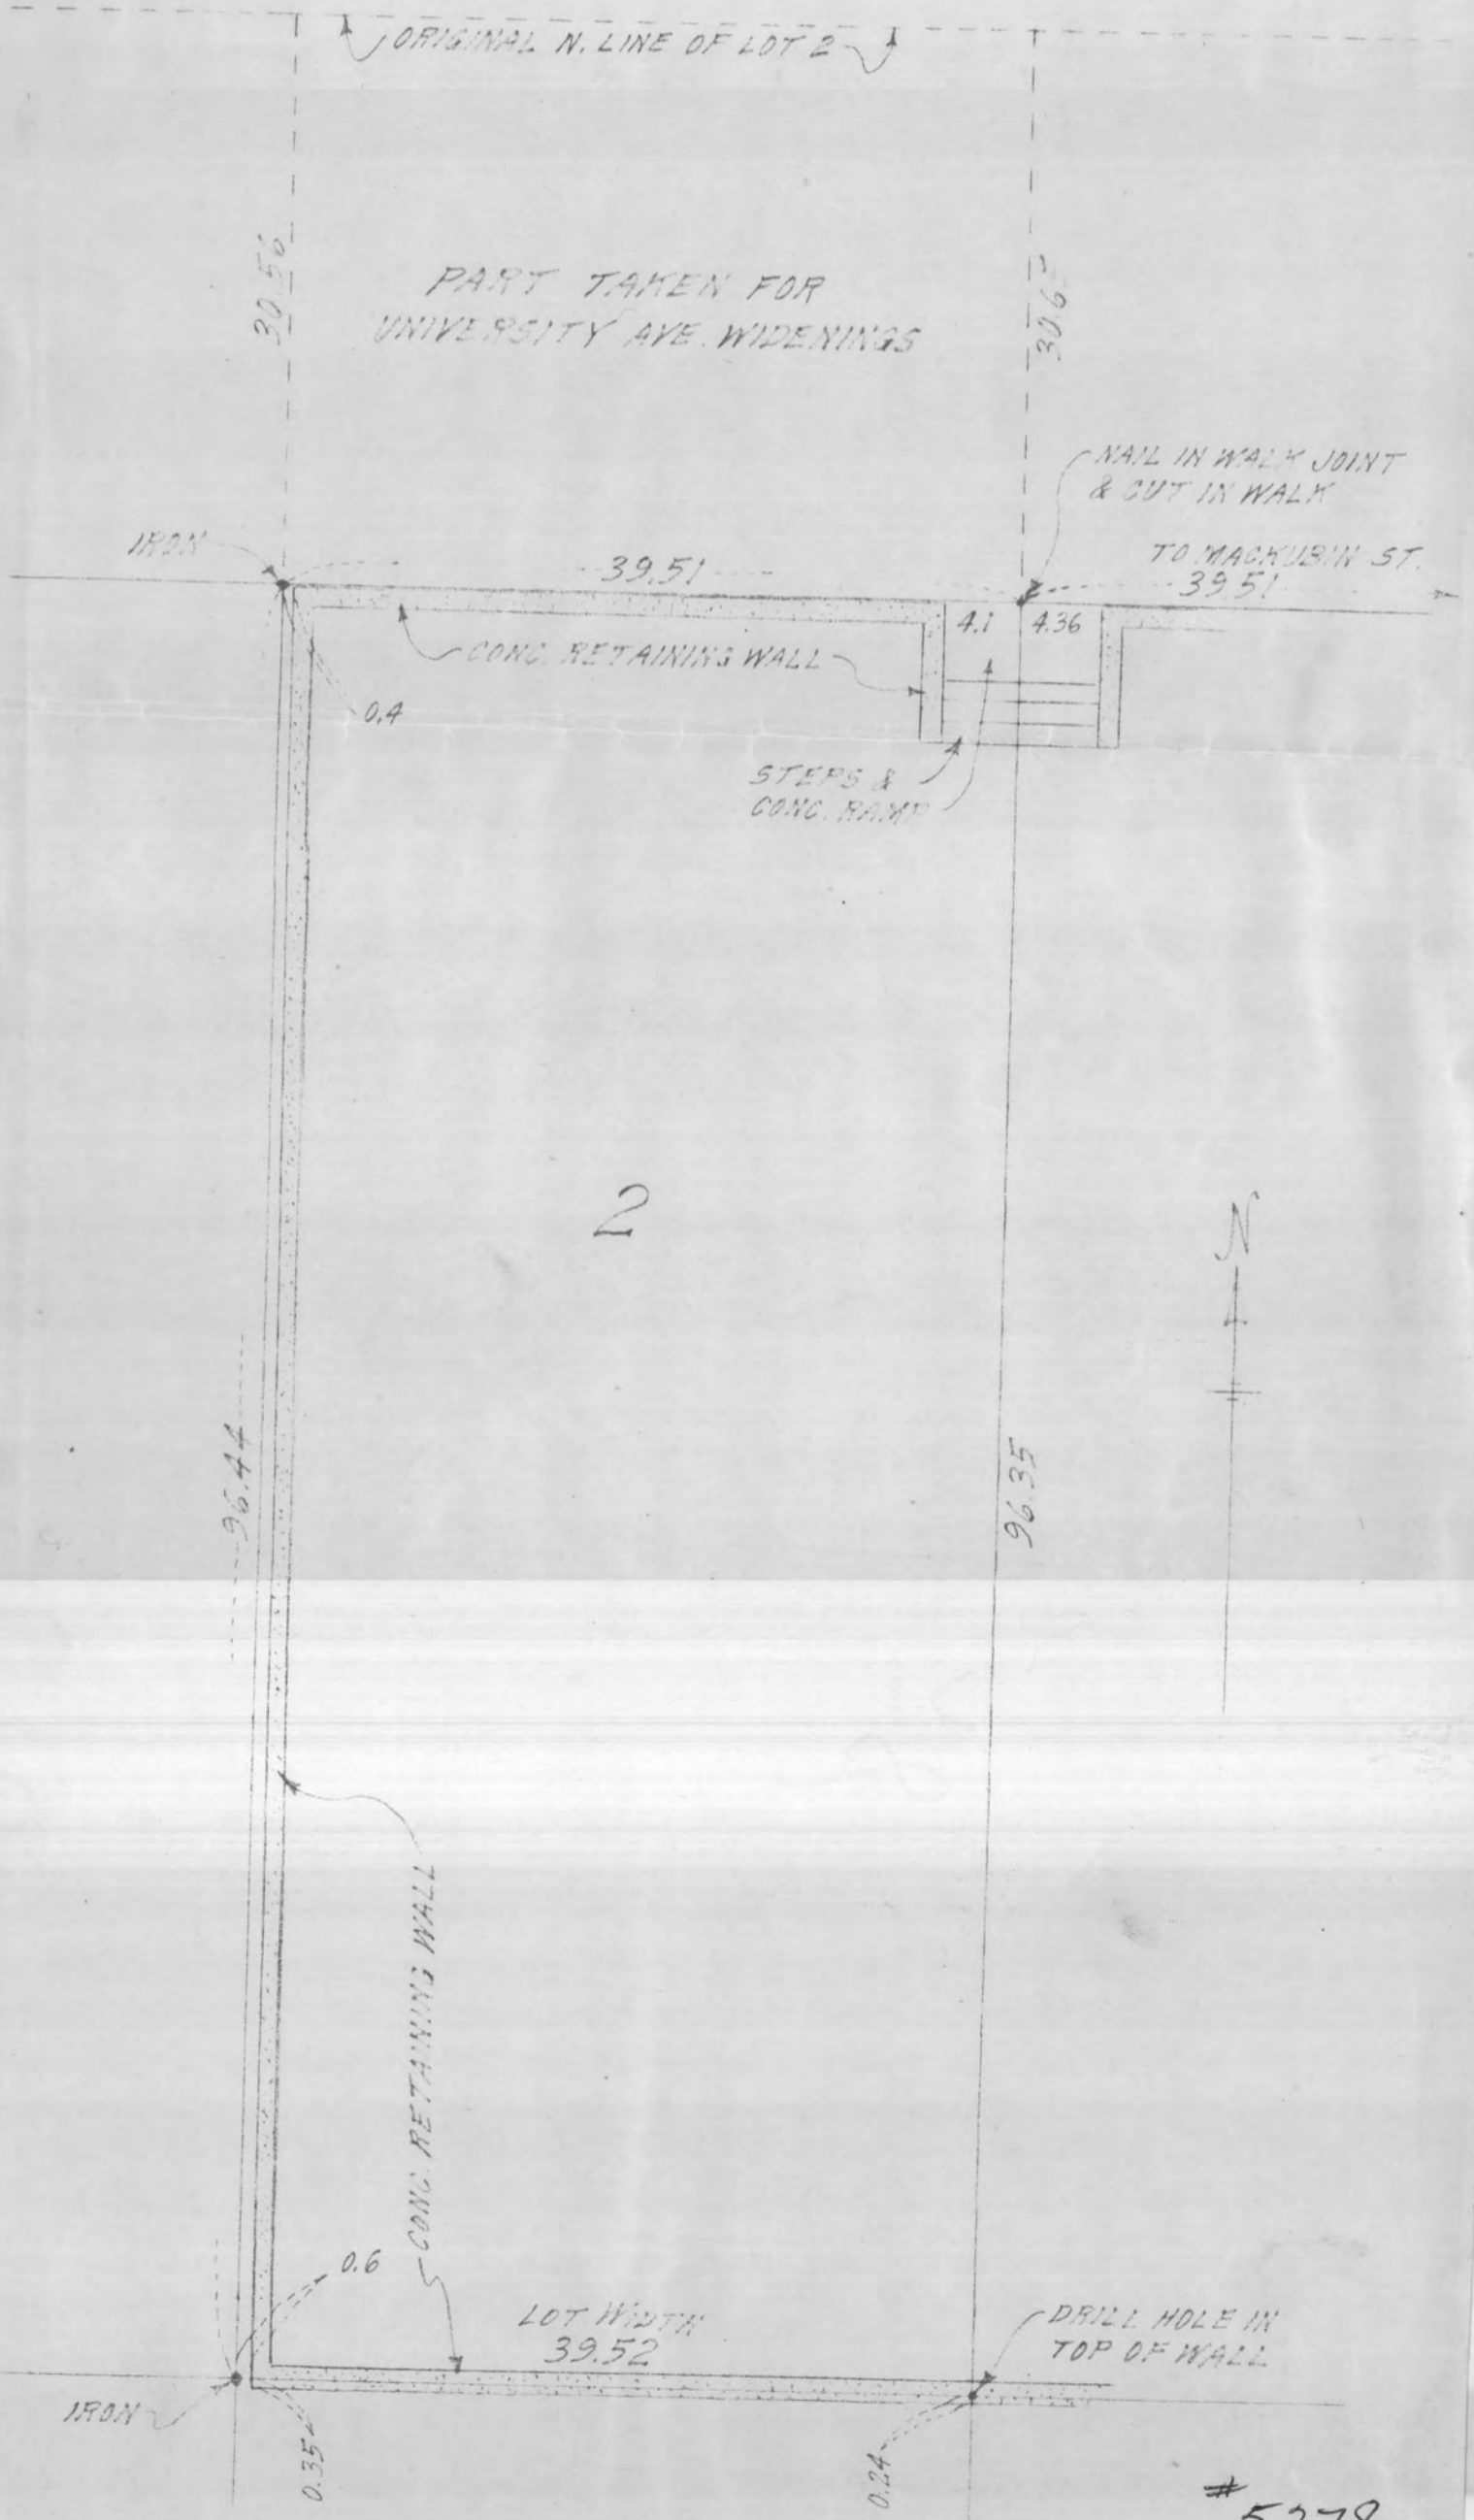

5278