


CERTIFICATE of SURVEY

F. J. ARMSTRONG
Civil Engineer and Surveyor
ST. PAUL, MINN.

FAUQUIER AVE.

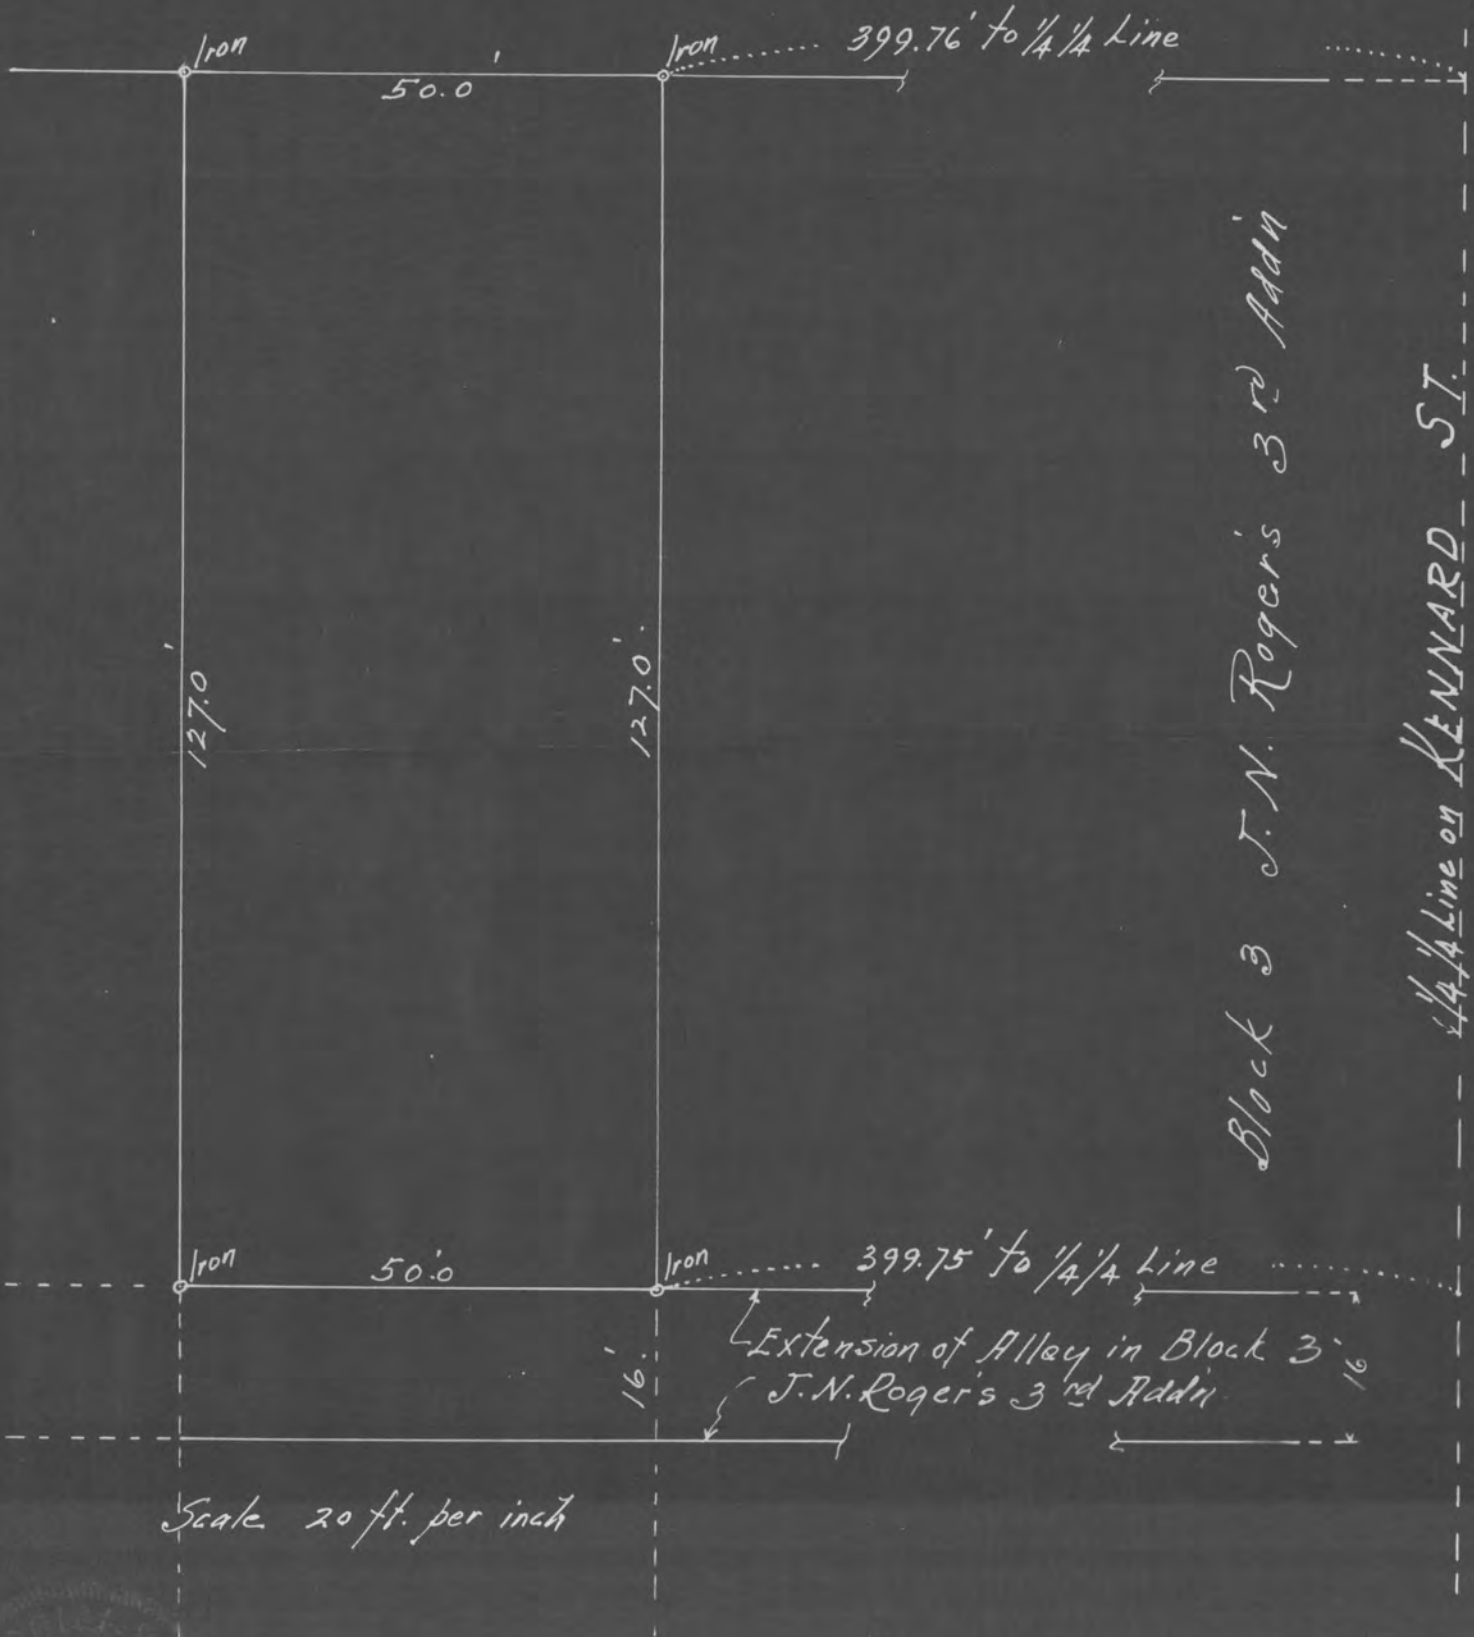

I HEREBY CERTIFY that on the 27th day of September, A. D. 1946

I made a survey of the following described property, to-wit: The west 50 ft. of the East 100 ft. of that part of Lot 4 Block 3 Cruickshank's Garden Lots lying north of Alley in Block 3 J.N. Rogers's 3rd Addn to St. Paul extended west and south of Fauquier Ave.

and the map hereon shown is a true and correct map of said survey and that the improvements thereon indicated are correctly shown.

Subscribed and sworn to before me this
30 day of Sept, 1946
Rayl Stauff
Notary Public.

My Commission Expires Sept 27 1947

F. J. Armstrong
Civil Engineer.

5295