

APPLICATION NO. _____

5379


TELEPHONES { CE 0731
AT 2364
MI 8414

PLAT OF SURVEY

OF PROPERTY OF RAY FARICY, 316 MARIA AVENUE, ST. PAUL, MINN

DESCRIBED AS FOLLOWS - (SEE BACK OF PRINT FOR COMPLETE LEGAL DESCRIPTION

SCALE: 1 INCH 30 FEET
O: INDICATES IRON

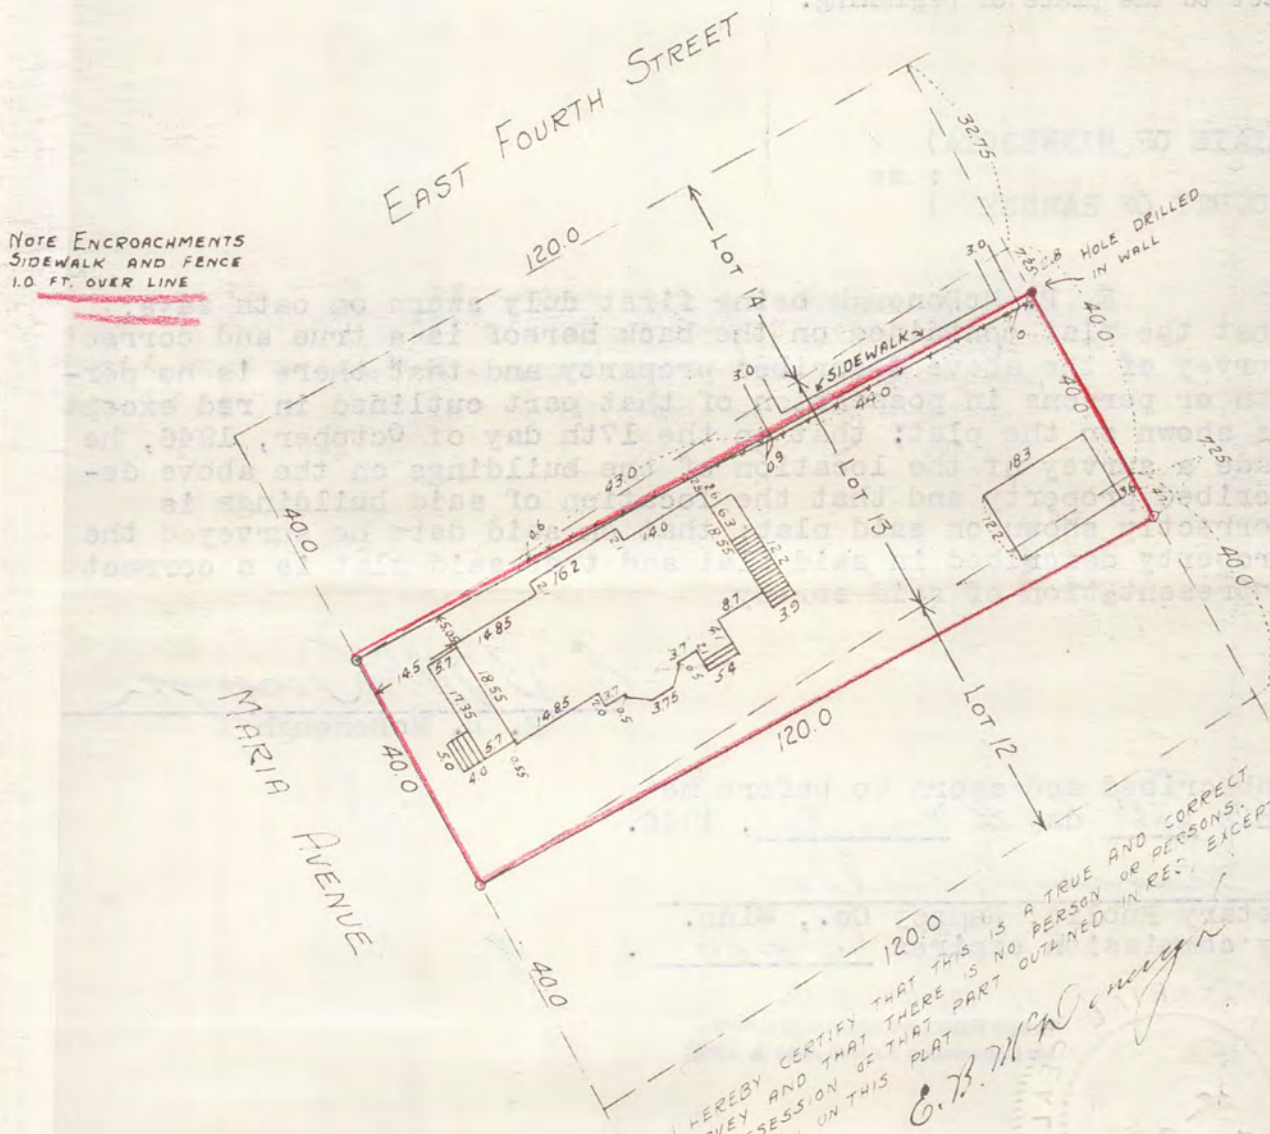

CERTIFICATE OF LOCATION OF BUILDING

CERTIFICATE OF SURVEY

I hereby certify that on 10-17 1946
I made a survey of the location of the building(s) on the above described property and that the location of said building(s) is correctly shown on the above plat.

I hereby certify that on 10-17 1946
I surveyed the property described above and that the above plat is a correct representation of said survey.

E. B. McDonough

E. B. McDonough

E. B. McDONOUGH, REGISTERED SURVEYOR, NO. 1990

PLAT OF SURVEY

That part of Lots twelve (12) and Thirteen (13), Block thirty-three (33), Lyman Dayton's Addition to the City of St. Paul, more particularly described as follows:

Beginning at a point on the northeasterly line of Maria Avenue, 40 feet southeasterly from the point of intersection of the Northeasterly line of Maria Avenue and the Southeasterly line of 4th Street; thence Southeasterly along said Northeasterly line of Maria Avenue, 40 feet; thence northeasterly and parallel to 4th Street, 120 feet; thence Northwesterly and parallel to Maria Avenue, 40 feet; thence Southwesterly and parallel to 4th Street, 120 feet to the place of beginning.

STATE OF MINNESOTA)
 : ss
COUNTY OF RAMSEY)

E. B. McDonough being first duly sworn on oath says, that the plat contained on the back hereof is a true and correct survey of the above described property and that there is no person or persons in possession of that part outlined in red except as shown on the plat; that on the 17th day of October, 1946, he made a survey of the location of the buildings on the above described property and that the location of said buildings is correctly shown on said plat; that on said date he surveyed the property described in said plat and that said plat is a correct representation of said survey.

E. B. McDonough

E. B. McDonough

Subscribed and sworn to before me this 30th day of November, 1946.

Frances Miller

Notary Public, Ramsey Co., Minn.
My commission expires 6-3-50.

FRANCES MILLER,
Notary Public, Ramsey County, Minn.
My Commission Expires June 3, 1950

FILED
JAN 22 1947

J. J. FITZGERALD, Clerk
By *R. W. Schmitt* Deputy

5379