


ST.

ORLEANS

GEORGE

ST.

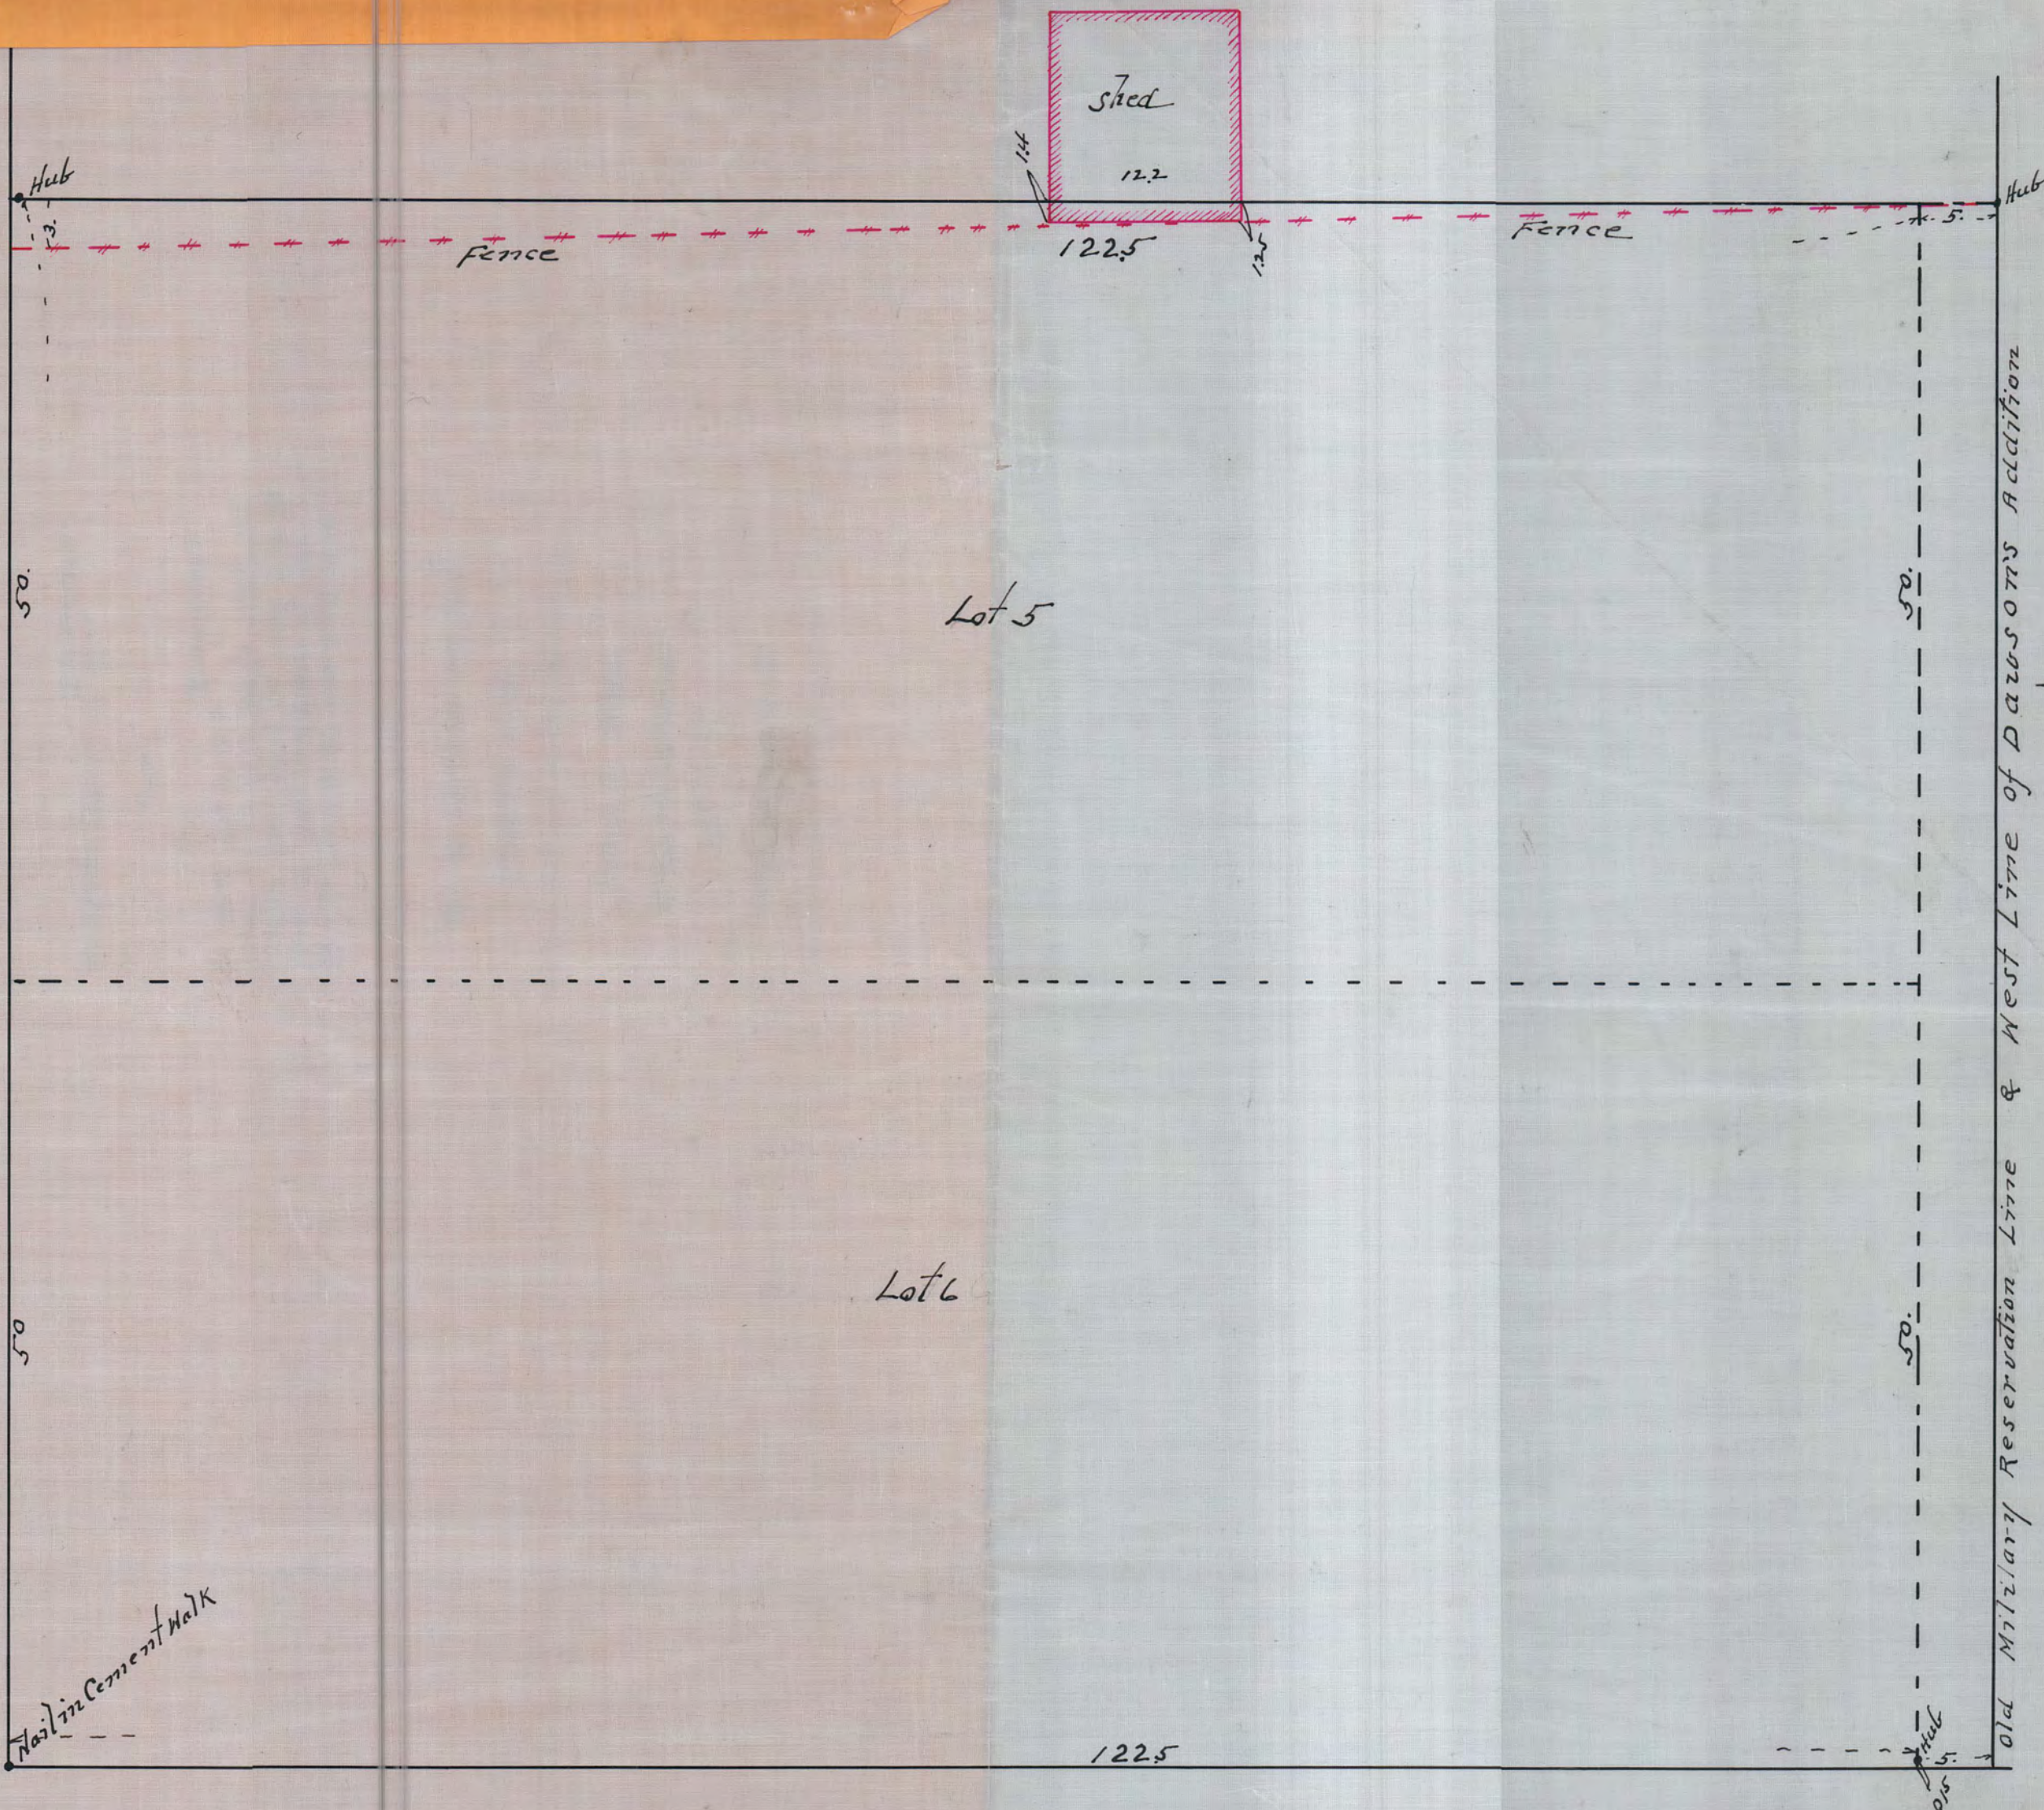

State of Minnesota } ss
 County of Ramsey }

J. H. Armstrong being first duly sworn doth depose and say that he is a resident of the City of St Paul County of Ramsey and State of Minnesota and a Civil Engineer by profession. He further deposes and says that on the 13th day of April A.D. 1905 he made a survey of the premises and real estate shown on the above diagram the same being Lots 5 & 6 Block 12 Oliver's Addition to West St Paul. He further deposes and says that the above diagram correctly represents said premises and is an accurate correct and complete survey and diagram thereof as the same was surveyed by him as aforesaid.

J. H. Armstrong, C.E.

scale 10' = 1.1" H.P.

541

Subscribed and sworn to before me
 this 5th day of July A.D. 1907

William S. White
 Notary Public
 Ramsey Co.
 Minn.

My Commission Expires Jan. 4, 1914.