

5423

APPLICATION NO. _____


TELEPHONES { CE 0731
AT 2364
MI 8414

PLAT OF SURVEY

OF PROPERTY OF MAYNARD THOELKE,

DESCRIBED AS FOLLOWS LOTS-18, 19, AND 20, BLOCK 1, FARRAR'S ADDITION
TO ST. PAUL

SCALE: 1 INCH ³⁰ FEET
O INDICATES IRON

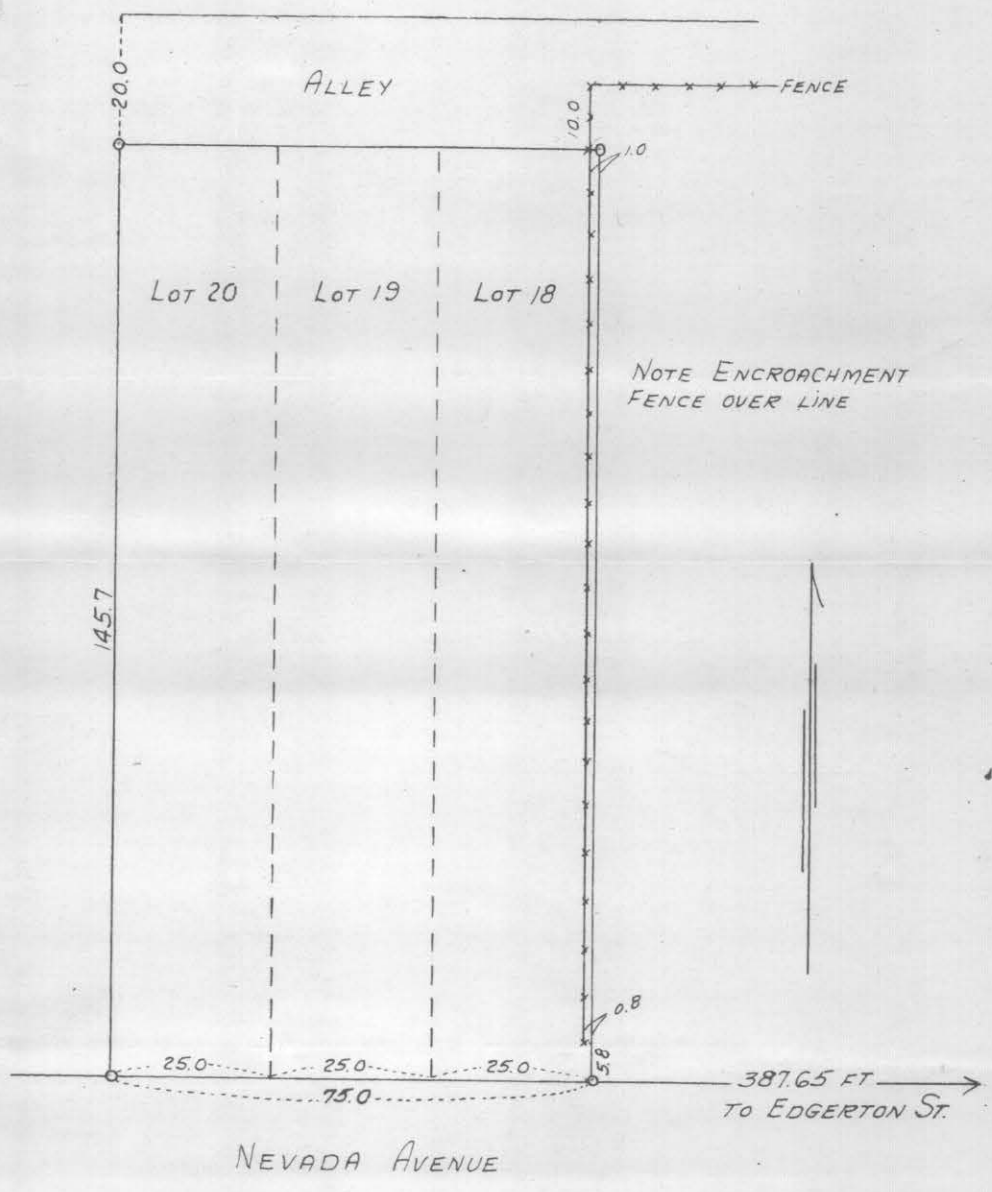

CERTIFICATE OF LOCATION OF BUILDING

I hereby certify that on _____ 19____
I made a survey of the location of the building(s) on the above
described property and that the location of said building(s) is
correctly shown on the above plat.

CERTIFICATE OF SURVEY

I hereby certify that on 9-16 1946
I surveyed the property described above and that the above
plat is a correct representation of said survey.

E. B. McDonough

E. B. McDONOUGH, REGISTERED SURVEYOR, NO. 1990

5423