


# CERTIFICATE of SURVEY

F. J. ARMSTRONG  
Civil Engineer and Surveyor  
ST. PAUL, MINN.

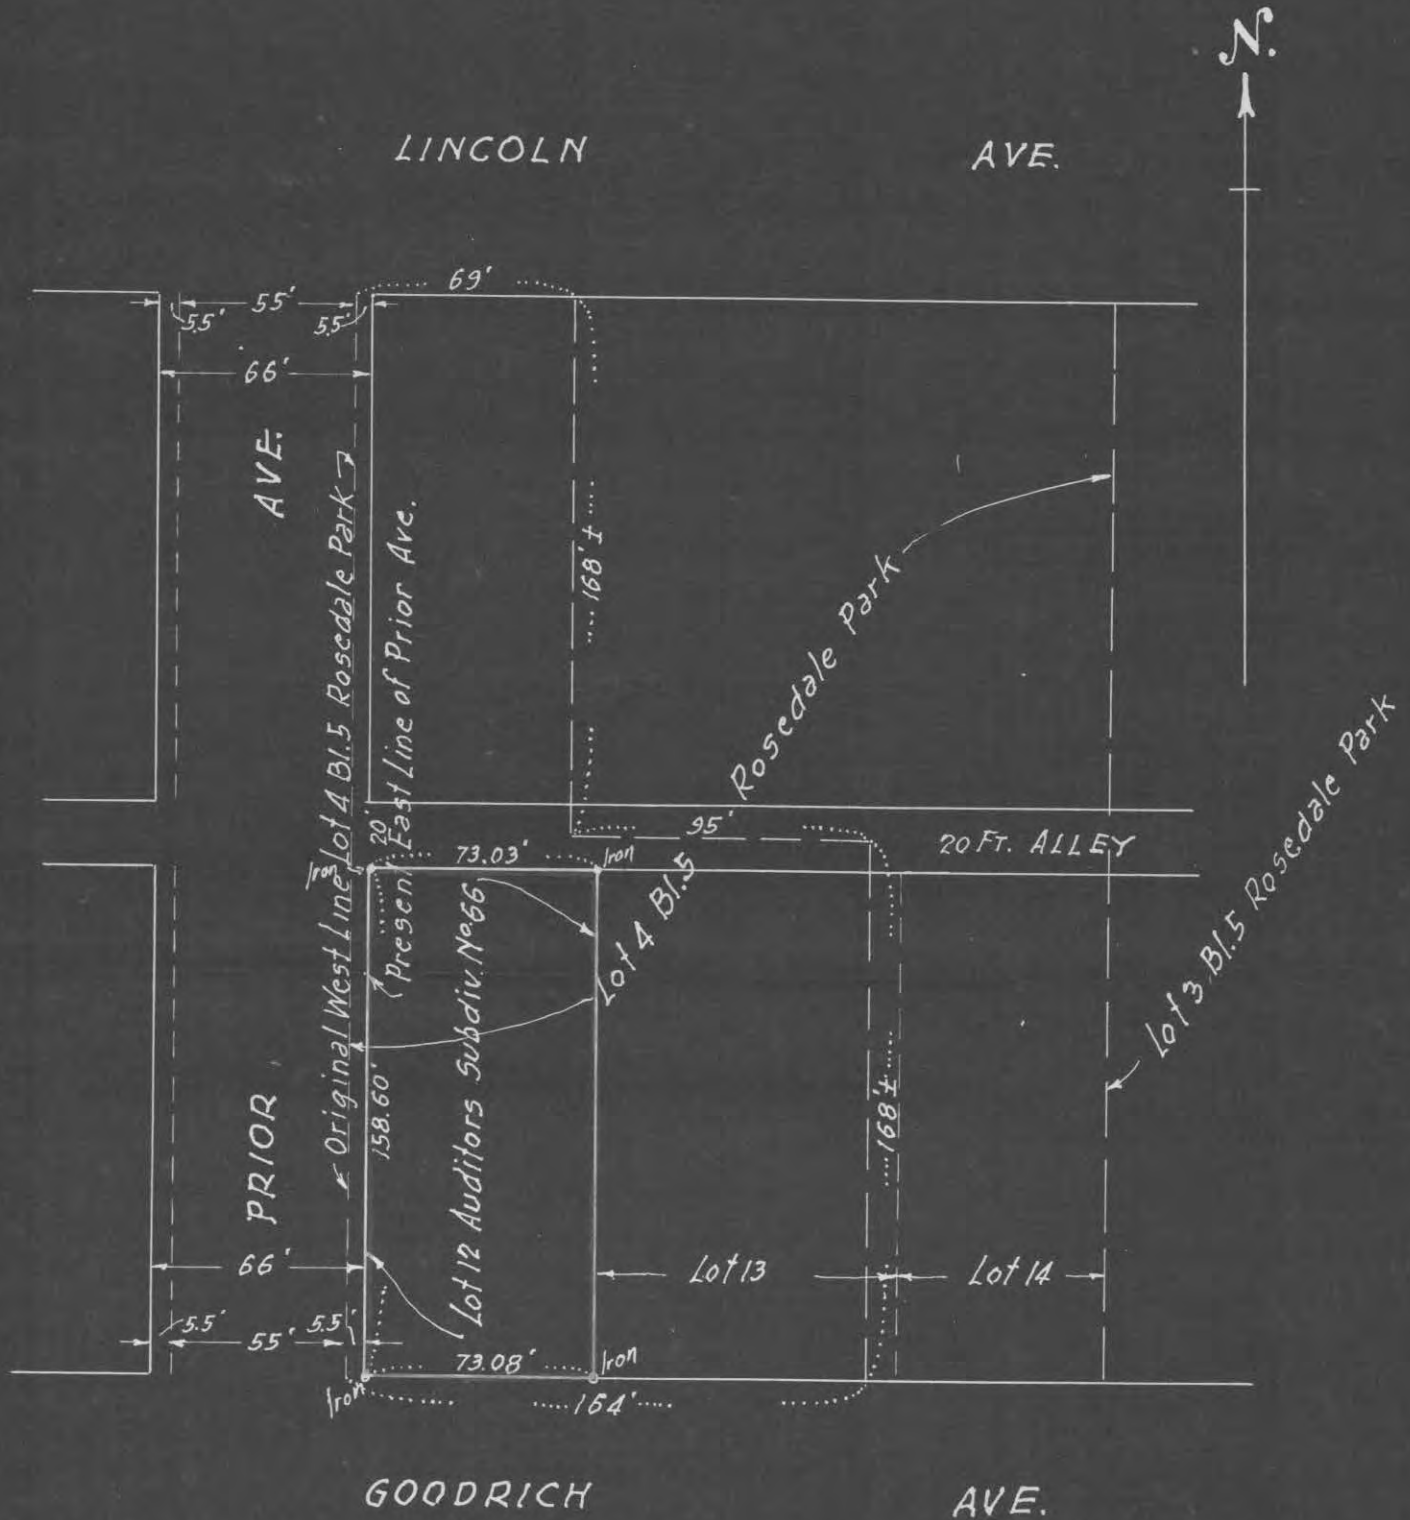

Scale 1" = 60'

I HEREBY CERTIFY that on the 22<sup>nd</sup> day of January, A. D. 1947,

I made a survey of the following described property, to-wit: Lot 12 Auditor's Subdiv. No. 66  
and that said Lot 12 lies entirely within the bounds of that part of Lot 4  
Block 5 Rosedale Park, as described in Book 593 Deeds page 309

and the map hereon shown is a true and correct map of said survey and that the improvements thereon  
indicated are correctly shown. and there are no encroachments

F. J. Armstrong Civil Engineer.

Subscribed and sworn to before me this  
22<sup>nd</sup> day of January, 1947  
Ernest G. Bach  
Notary Public.

My Commission Expires 10-29-49

#5458