


# PLAT OF SURVEY

DESCRIPTION... Lot 163 UNION PARK ADDITION

Scale 1 inch = 20 feet  
o indicates Iron.

W. F. Bretschneider Registered Surveyor  
1160 Charles Ave. St. Paul Minn  
1-25-47

Telephone Da. 5304

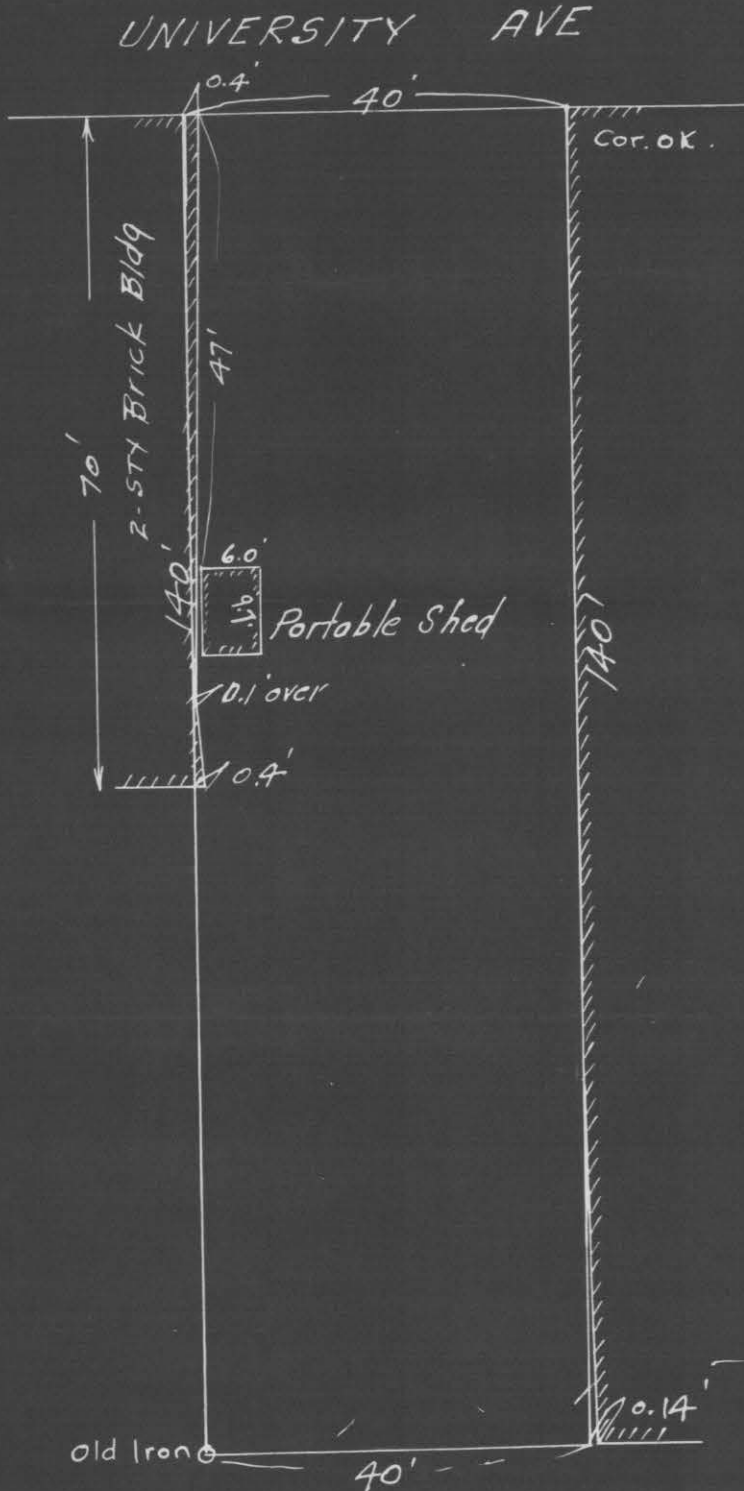

NORTH  
S

14 ft. Paved Alley

#  
5502