


PLAT OF SURVEY

OF PROPERTY OF _____

DESCRIBED AS FOLLOWS *Lot 13 in Block 2 of Forrest Lawn Addition*
No. 1765 Blair Ave. St. Paul, Minn.

SCALE: 1 INCH = 30 FEET
O INDICATES IRON

T. J. WELCH, REGISTERED SURVEYOR
738 SURREY AVENUE, ST. PAUL, MINN.

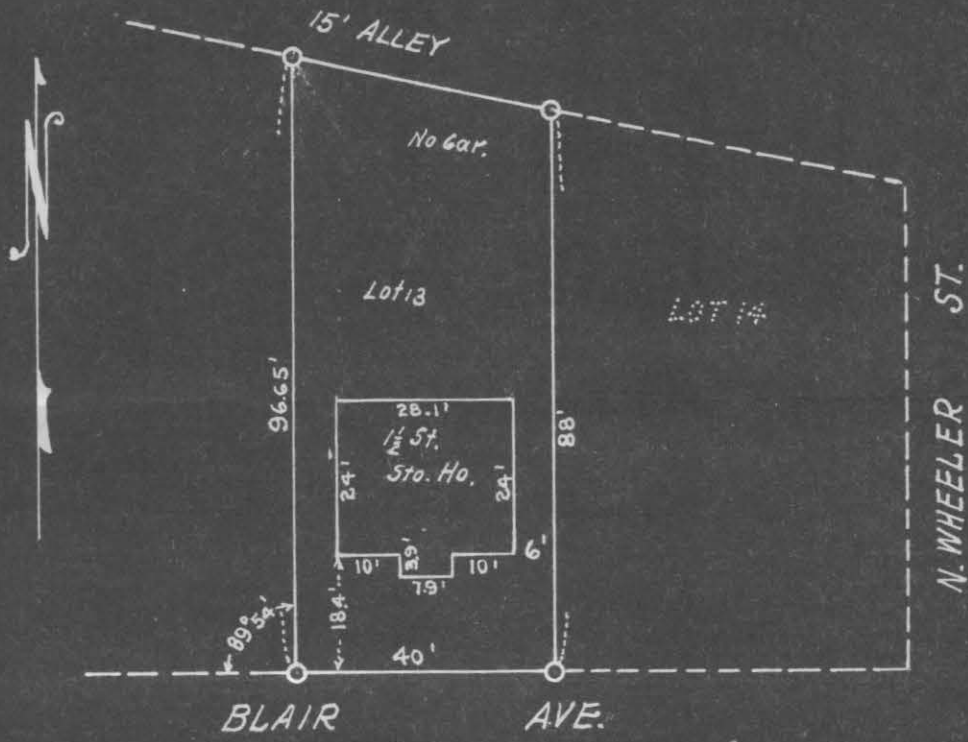

CERTIFICATE OF SURVEY

I hereby certify that on 11-29- 1946

I surveyed the property described above and that the above plat is a correct representation of said survey.

T. J. Welch

5535