


CERTIFICATE of SURVEY

F. J. ARMSTRONG
Civil Engineer and Surveyor
ST. PAUL, MINN.

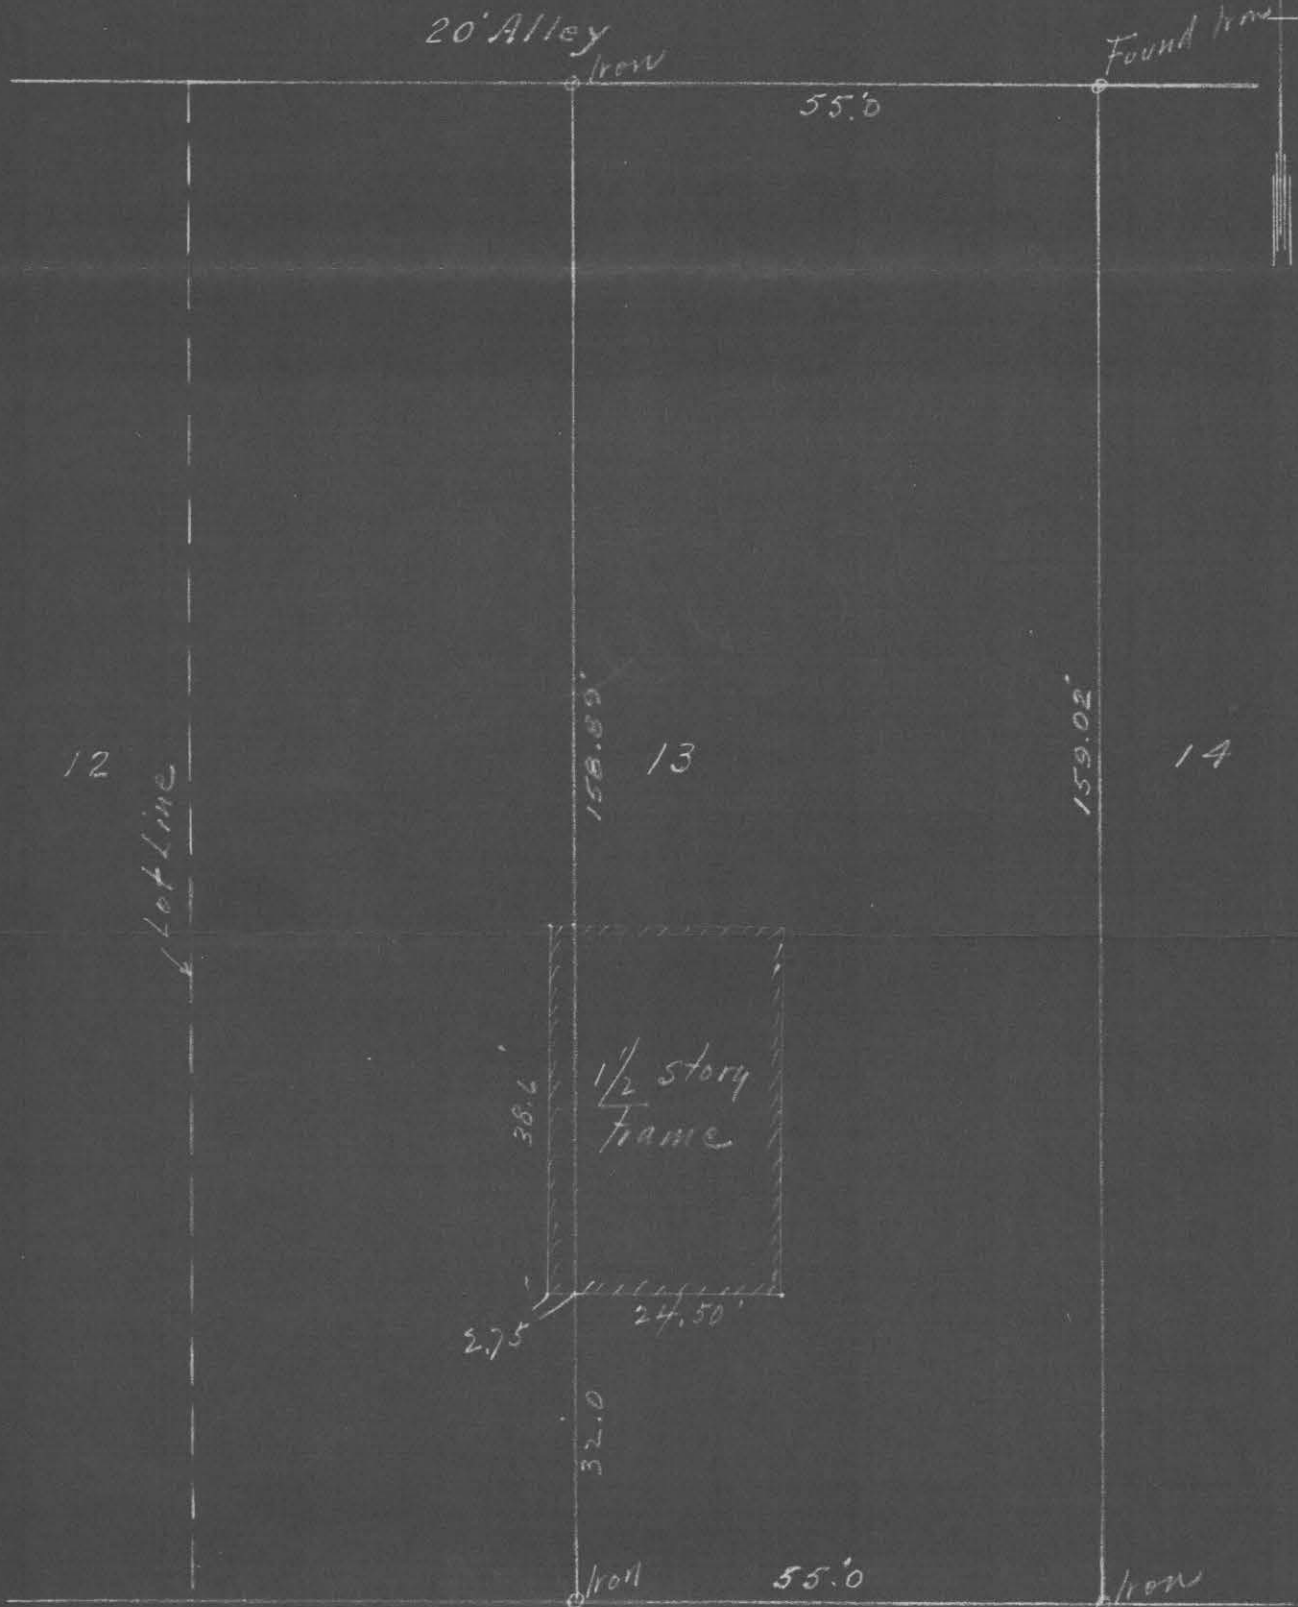

GOODRICH AVE.

Scale 20 ft. per inch

I HEREBY CERTIFY that on the 1st day of April, A. D. 1946,
I made a survey of the following described property, to-wit: East 55' of Lot 13
Auditor's Sub. Number 66
St. Paul Minn.

Subscribed and sworn to before me this
..... day of, 19.....

Notary Public.

and the map hereon shown is a true and correct map of said survey and that the improvements thereon
indicated are correctly shown.....

My Commission Expires.....

..... Civil Engineer.

5622