


CERTIFICATE of SURVEY

F. J. ARMSTRONG
Civil Engineer and Surveyor
ST. PAUL, MINN.

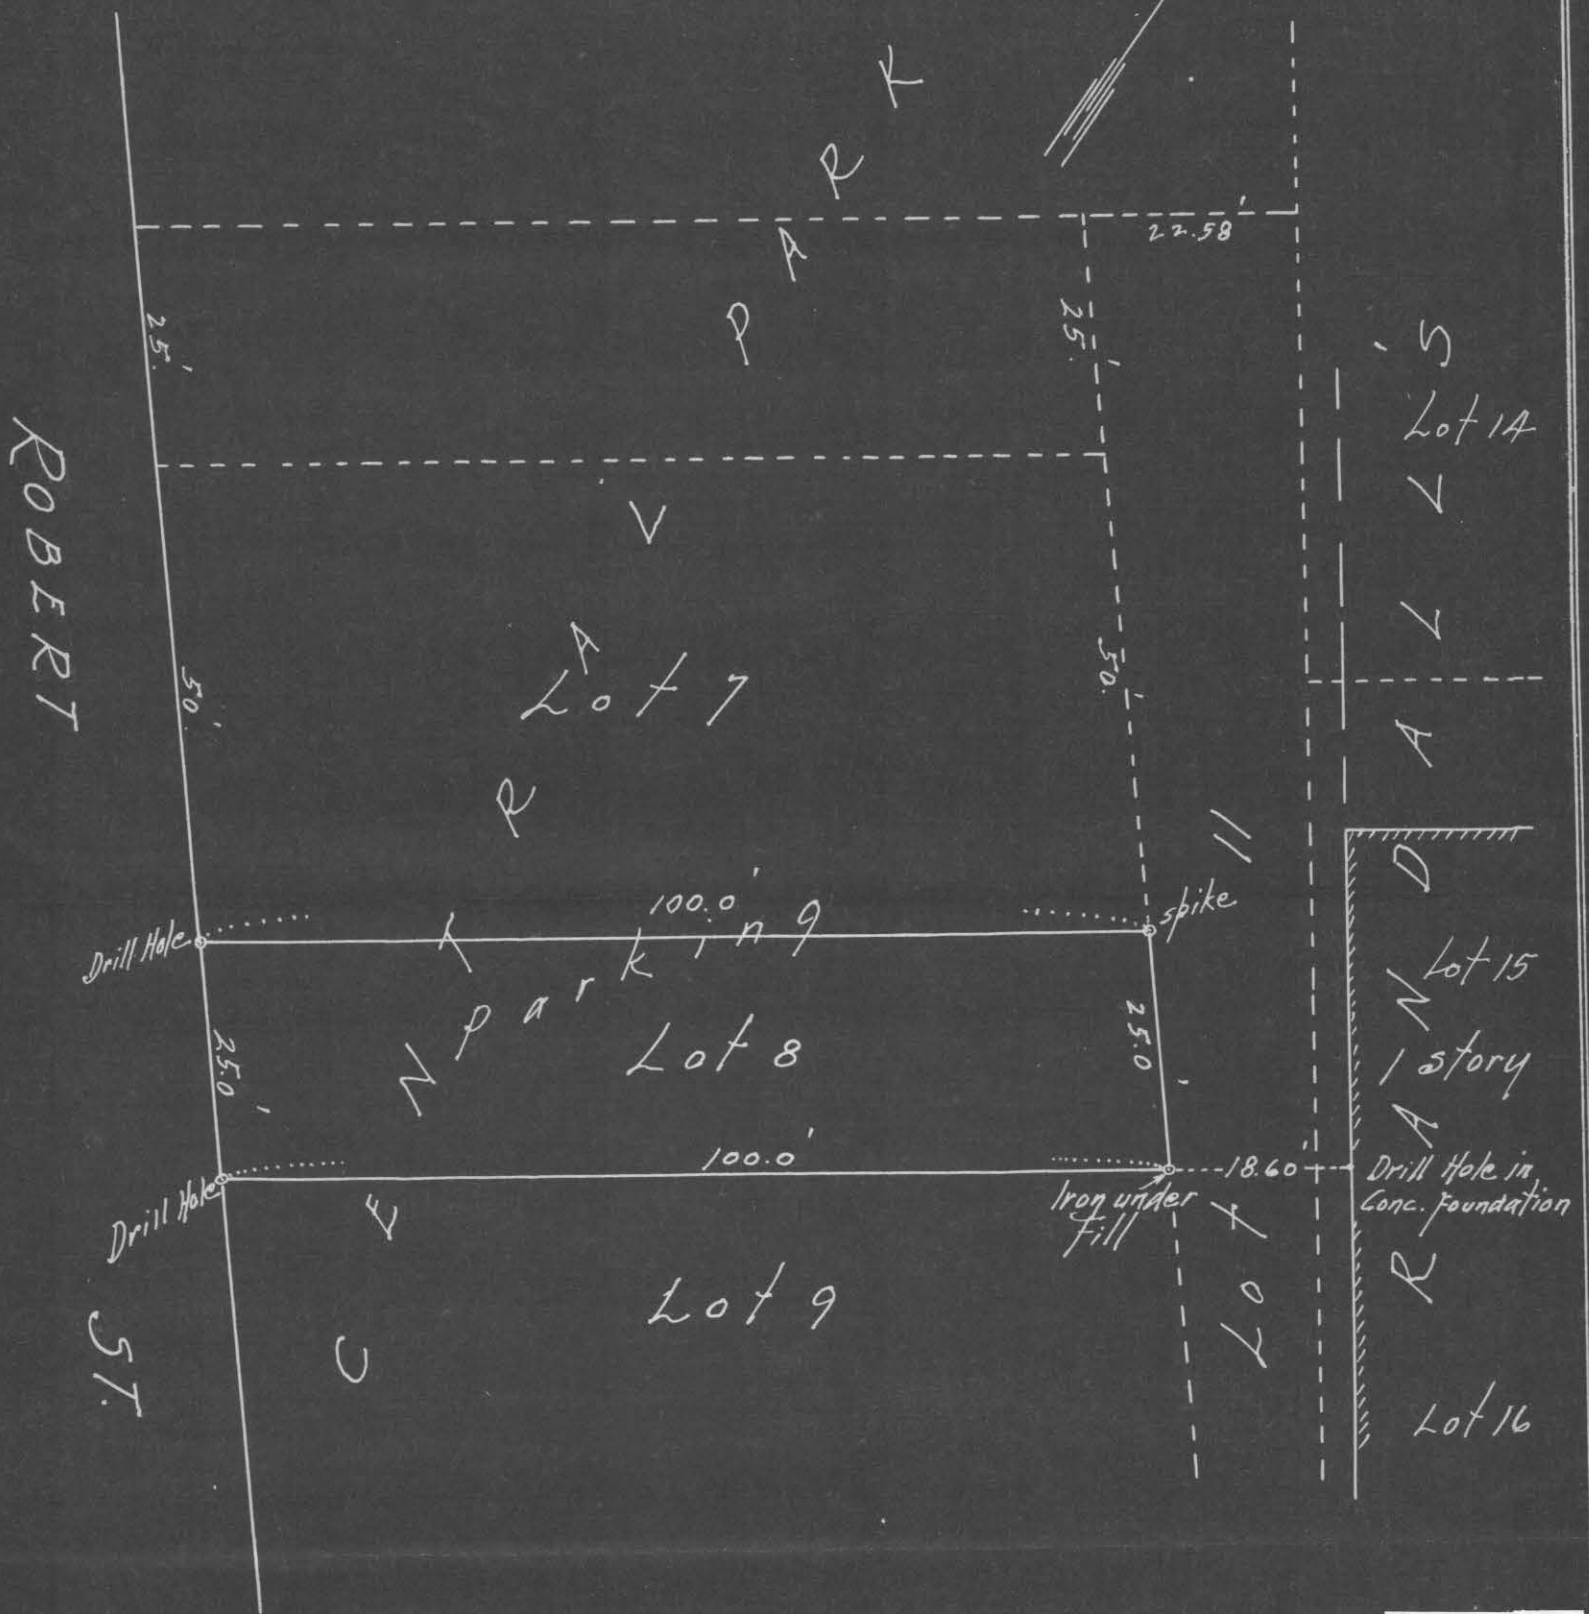

5630

Scale 20 ft. per inch

I HEREBY CERTIFY that on the 5th day of March, A. D. 1947,
I made a survey of the following described property, to-wit: Lot 8 in Block 10
Central Park Addn, St. Paul, Minn. being Auditor's Subm
No 3

Subscribed and sworn to before me this
1st day of March, 1947

Notary Public.

and the map hereon shown is a true and correct map of said survey and that the improvements thereon
indicated are correctly shown and there are no encroachments

My Commission Expires March 31, 1948

F. J. Armstrong Civil Engineer.