
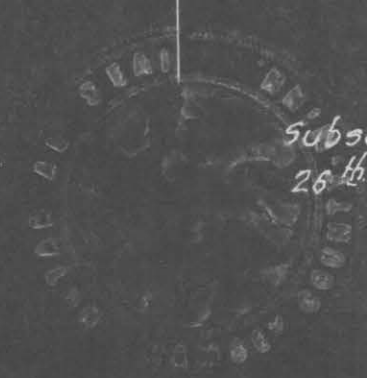


AVE.

FAIRVIEW

ST. CLAIR

ST.

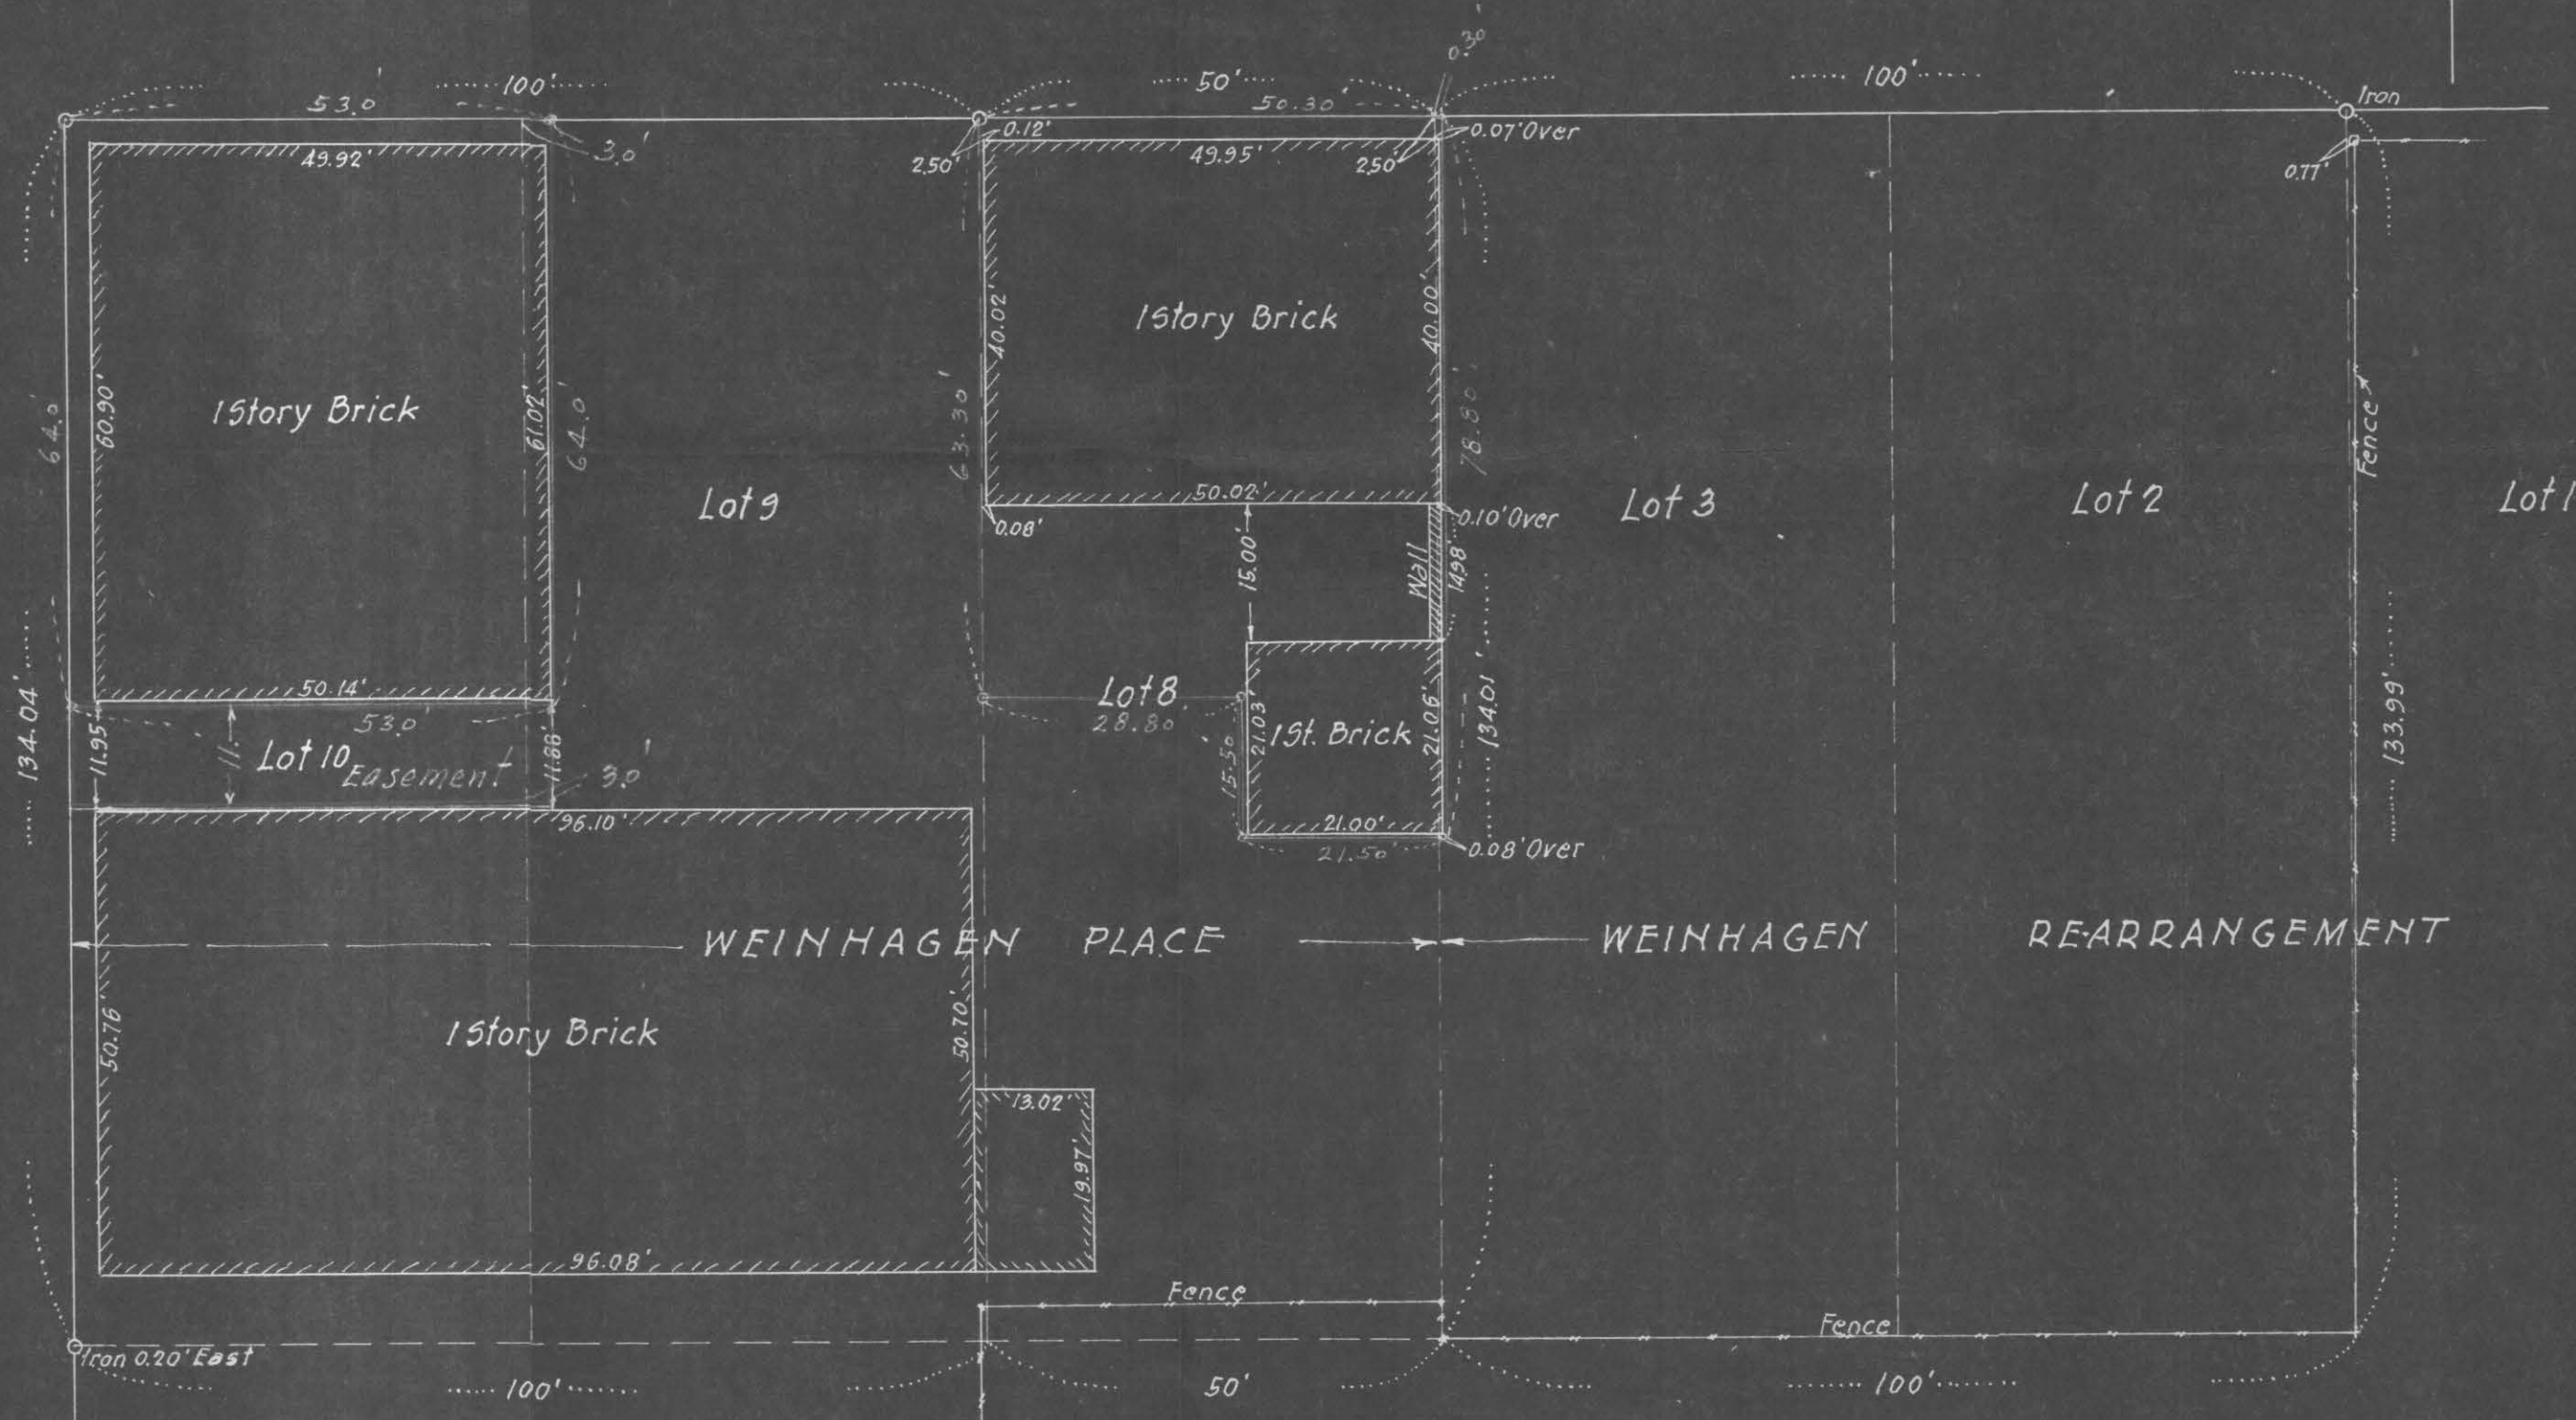

Subscribed and sworn to before me this 26th day of February 1948

Lorena B. Bach
Notary Public, Ramsey County, Minn.

My commission expires Oct. 29, 1949.

Thereby certify that this map correctly represents a
PLAT OF SURVEY OF LOTS 8, 9 AND 10 WEINHAGEN PLACE
ST. PAUL, MINN.

Scale 1" = 20' Surveyed by me June 2nd 1946 and Feb. 25th 1948.

F. J. Armstrong Civil Engr.

5692