

STATE OF MINNESOTA)
COUNTY OF RAMSEY.) SS.


J. H. Armstrong came before me personally and being duly sworn, deposes and says; That he the County Surveyor of the County of Ramsey and State aforesaid, that he made the plat attached hereto, and that the same is true and correct.

Subscribed and sworn to before me
this 19th day of January, 1905.

J. H. Armstrong

M. P. McFall
Notary Public, Ramsey County,
Minnesota.

580

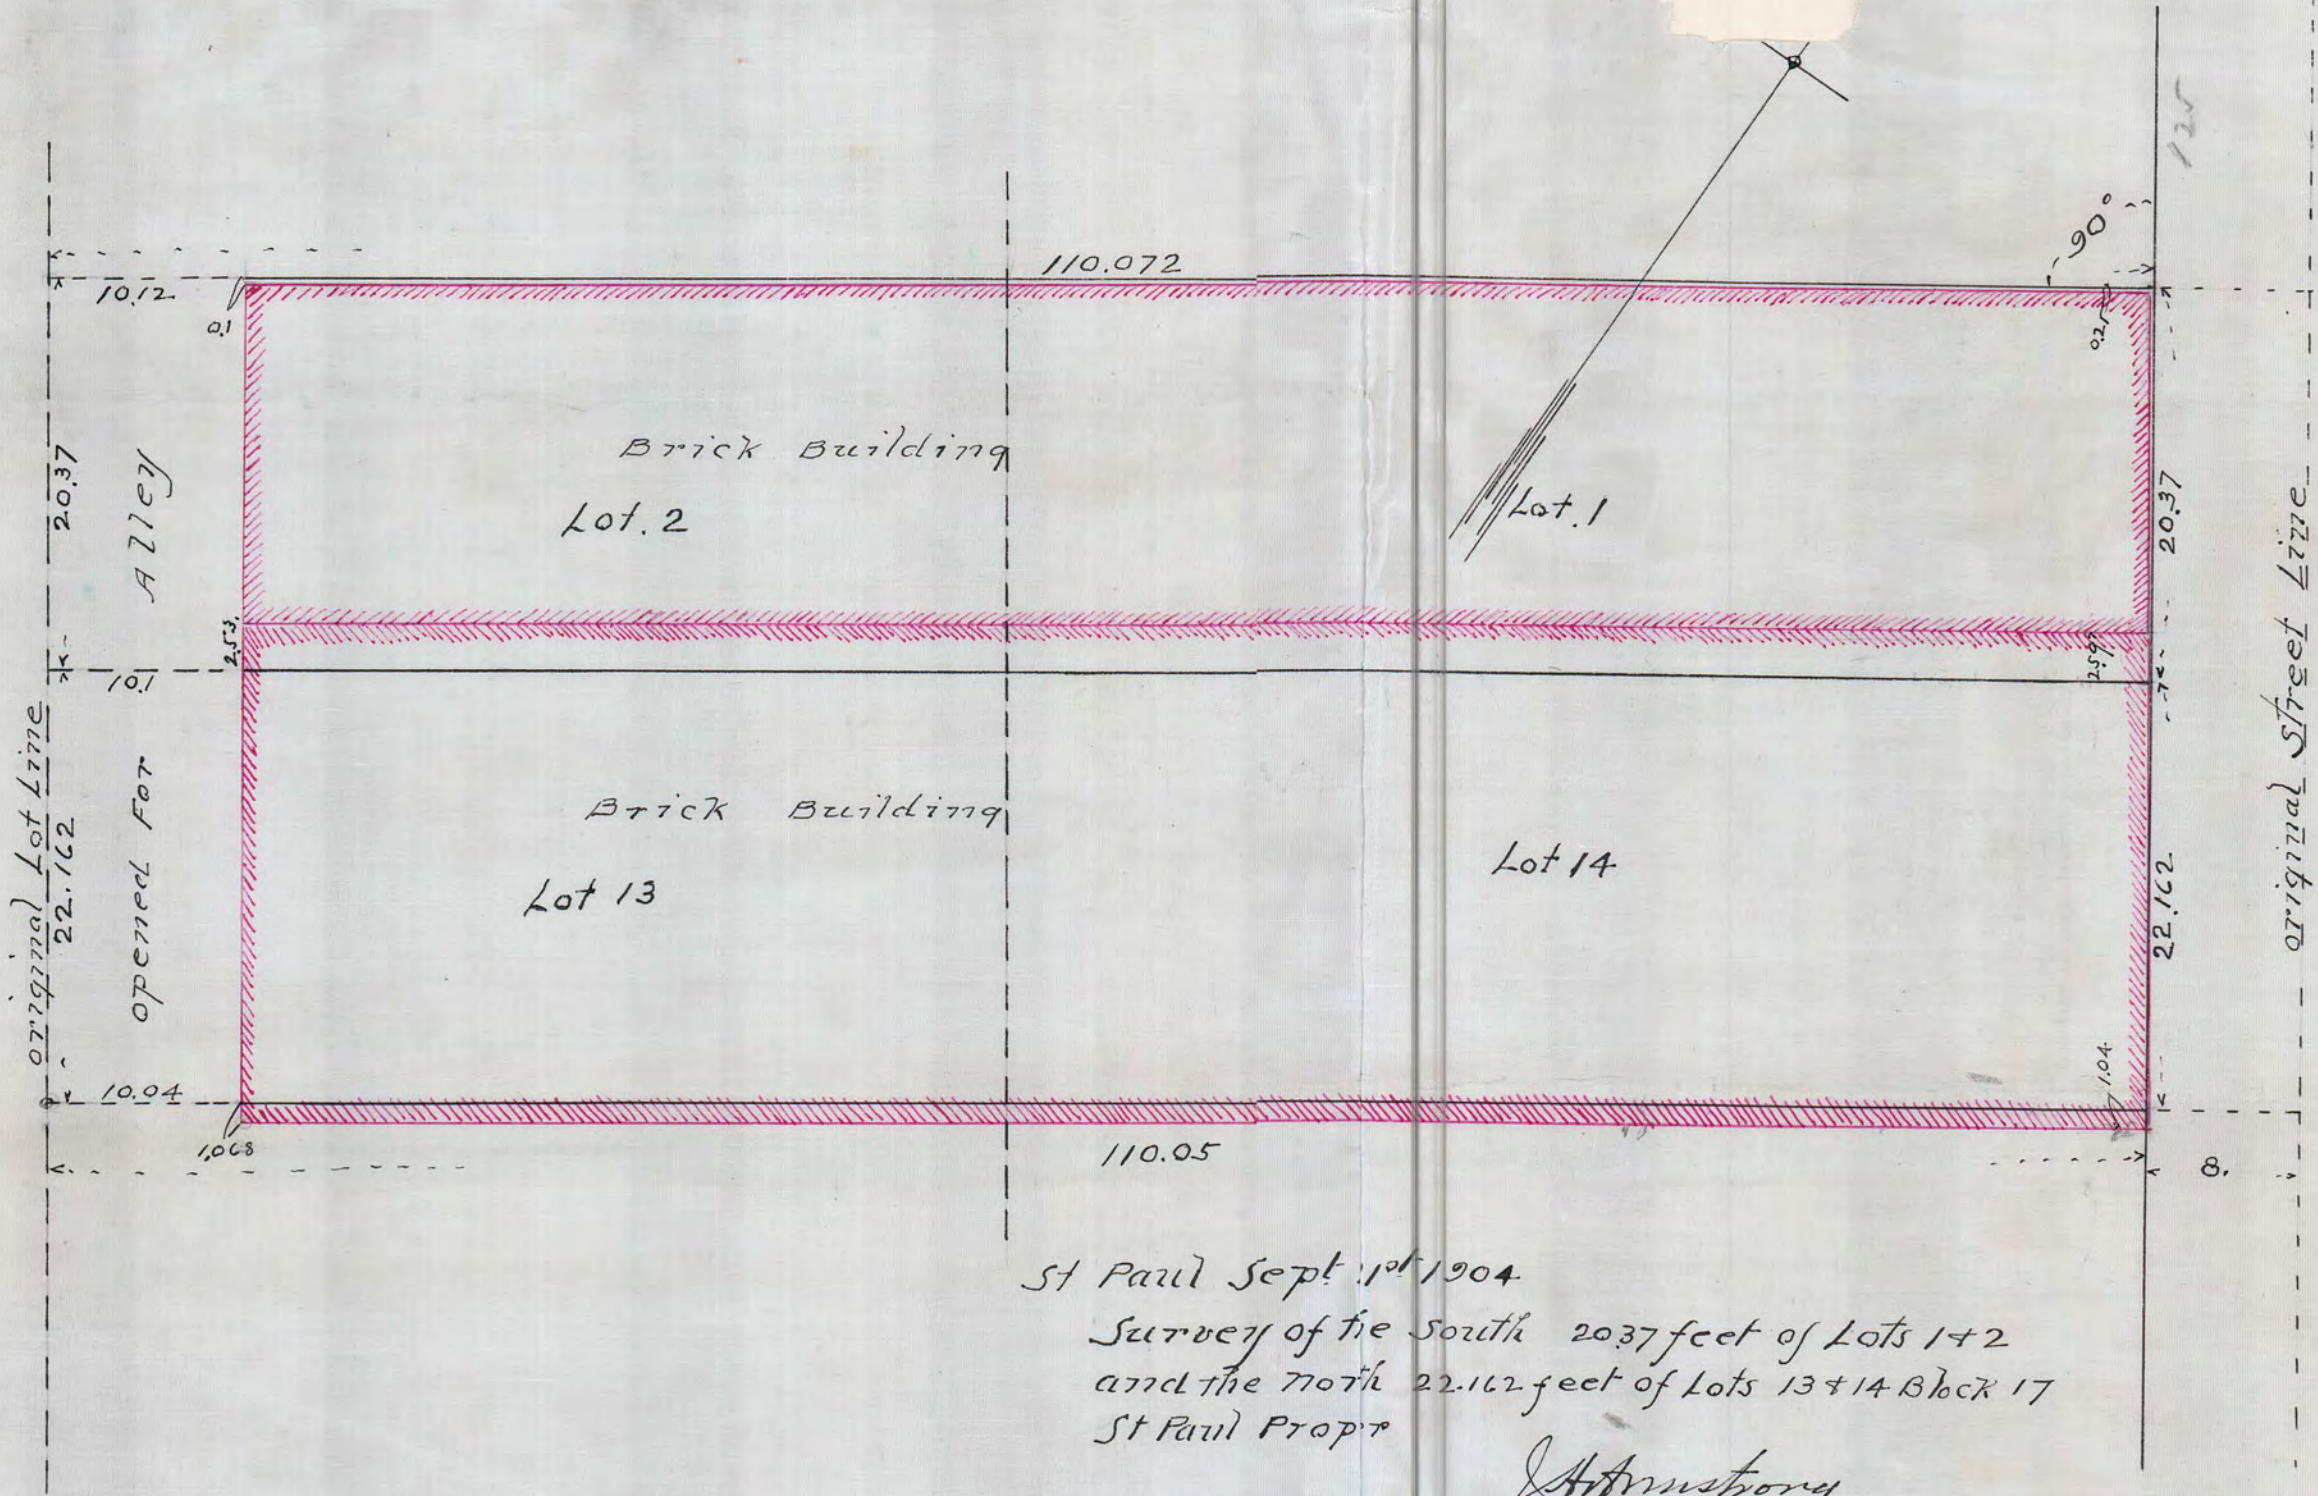

JACKSON ST.


St Paul Sept 1st 1904
 Survey of the south 2037 feet of Lots 1+2
 and the north 22.162 feet of Lots 13+14 Block 17
 St Paul Prop^r

J. Armstrong

580

LOTS 1, 2, 13 & 14 BLOCK 17
ST. PAUL PROPER.

FIFTH ST. 580

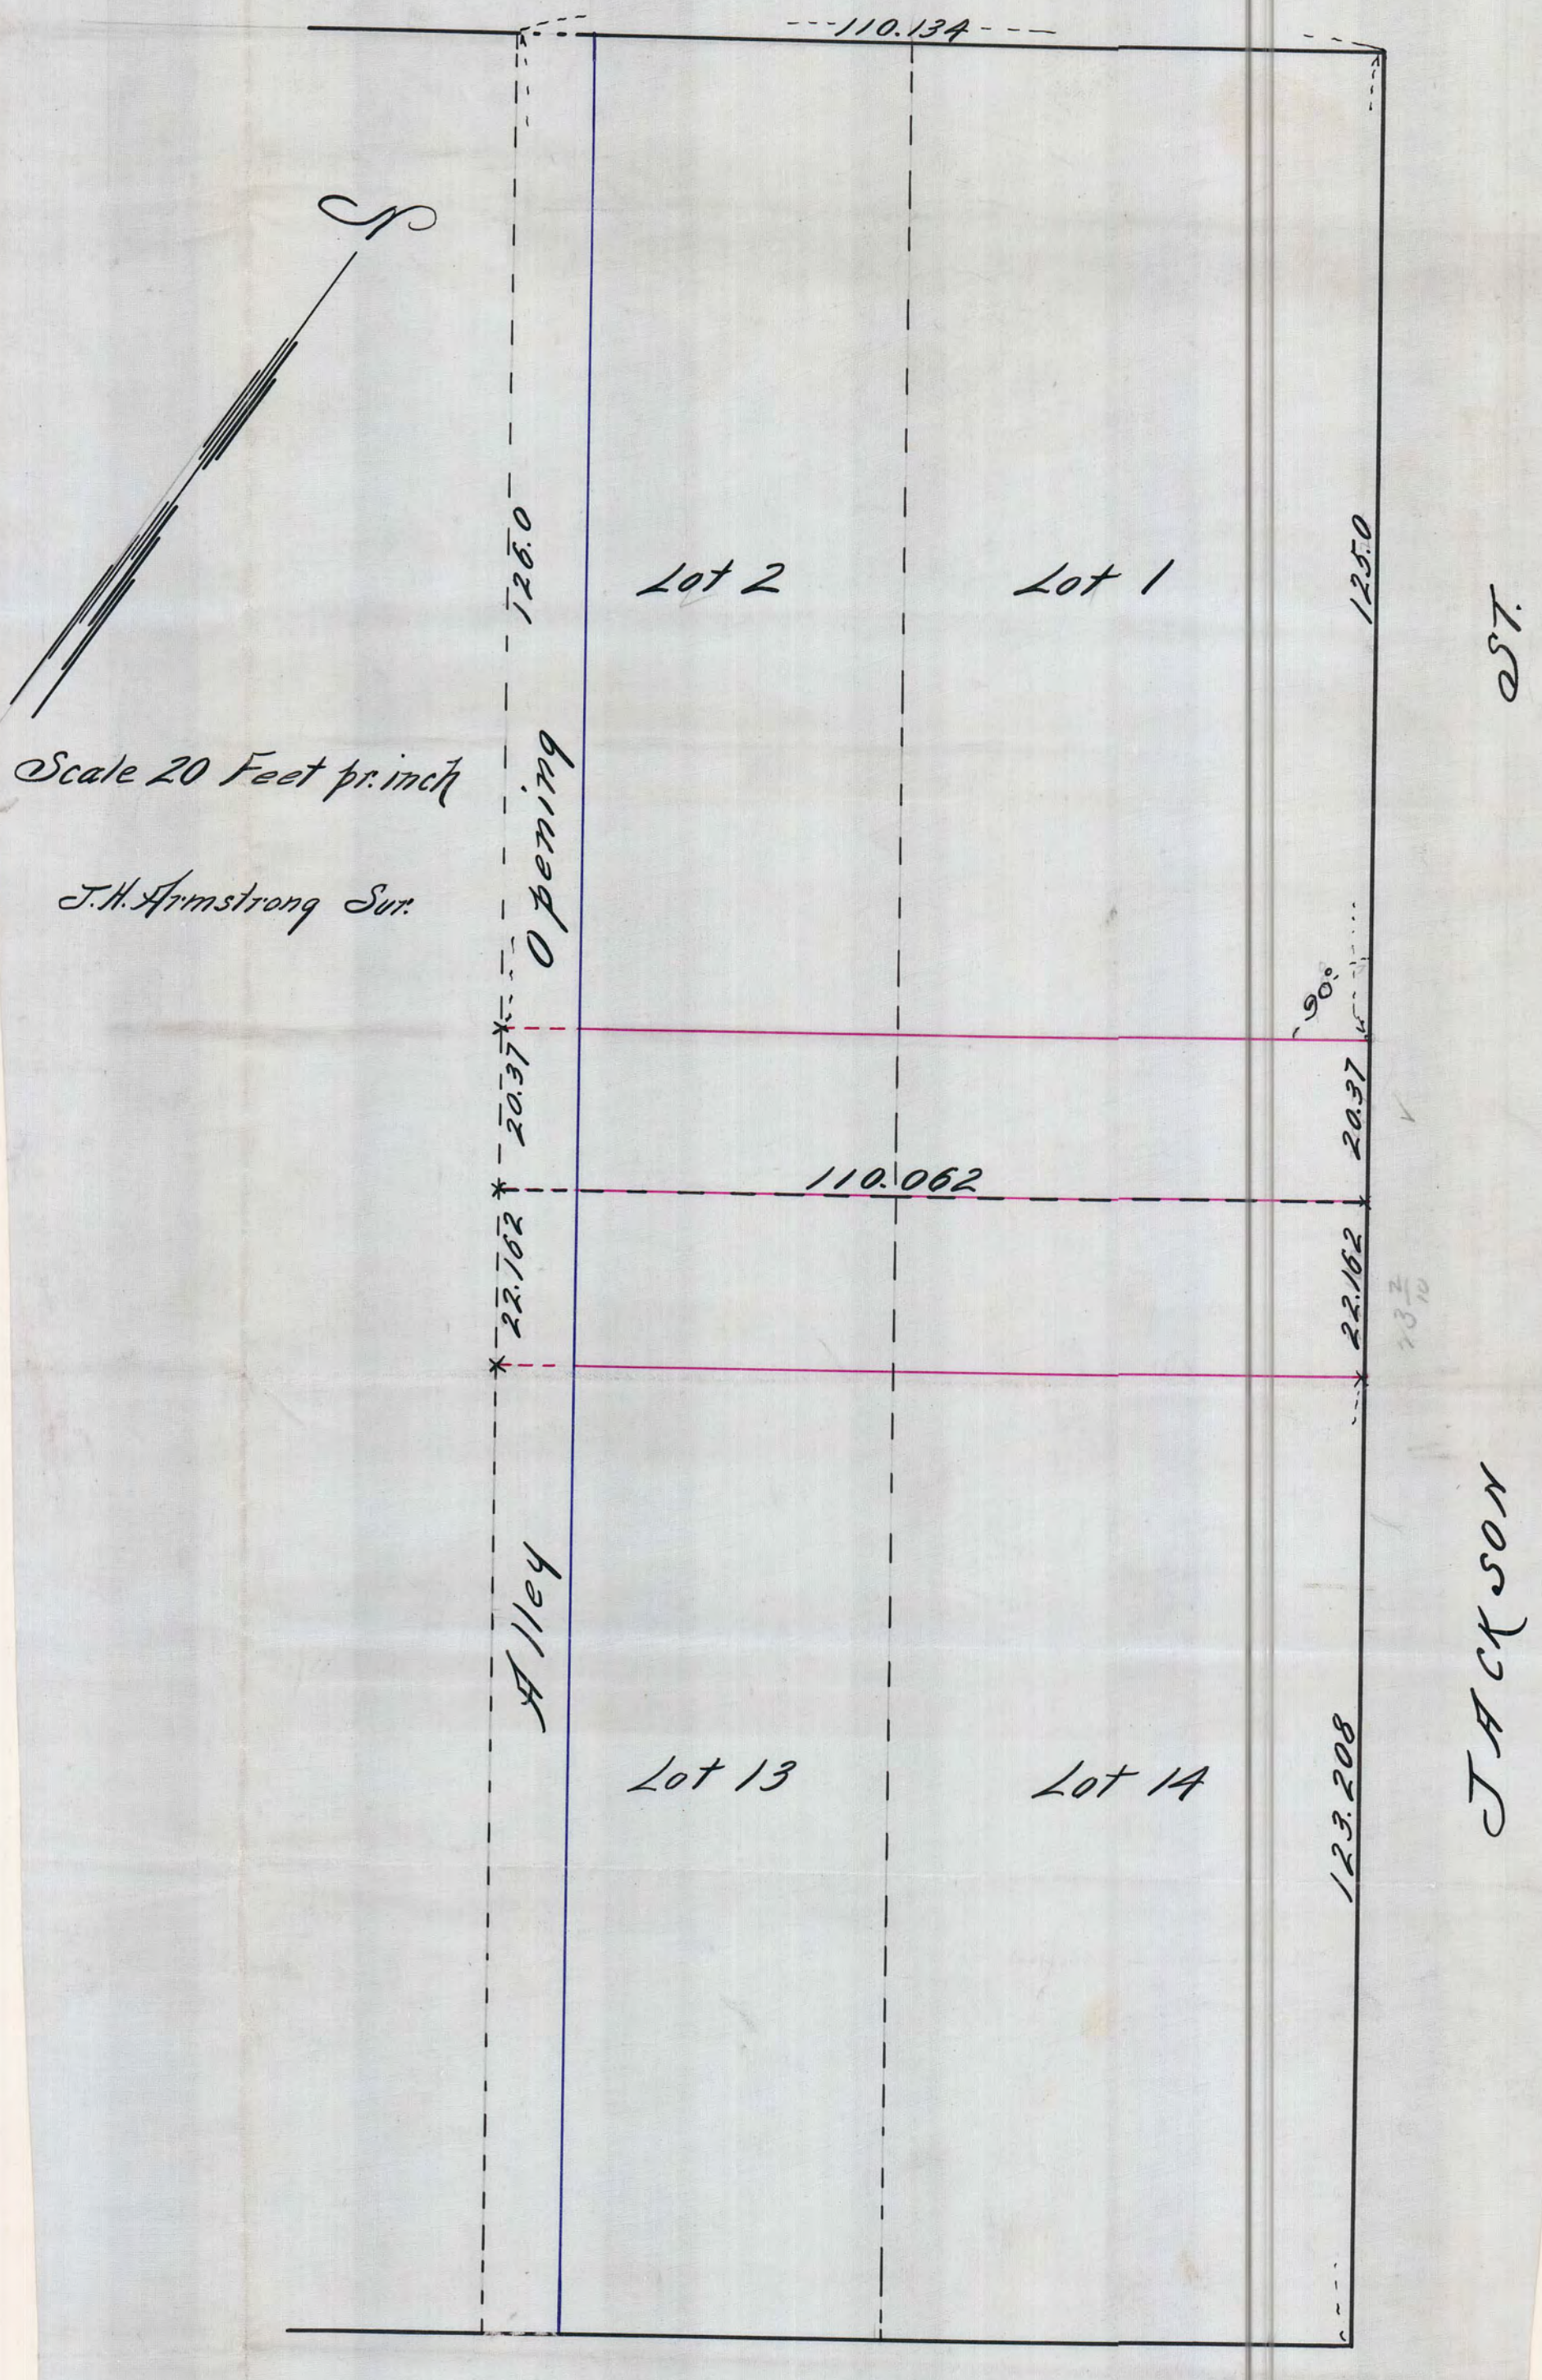

Scale 20 Feet pr. inch

J.H. Armstrong Sur.

JACKSON

FOURTH ST.

580