


ST.

ALBEMARLE

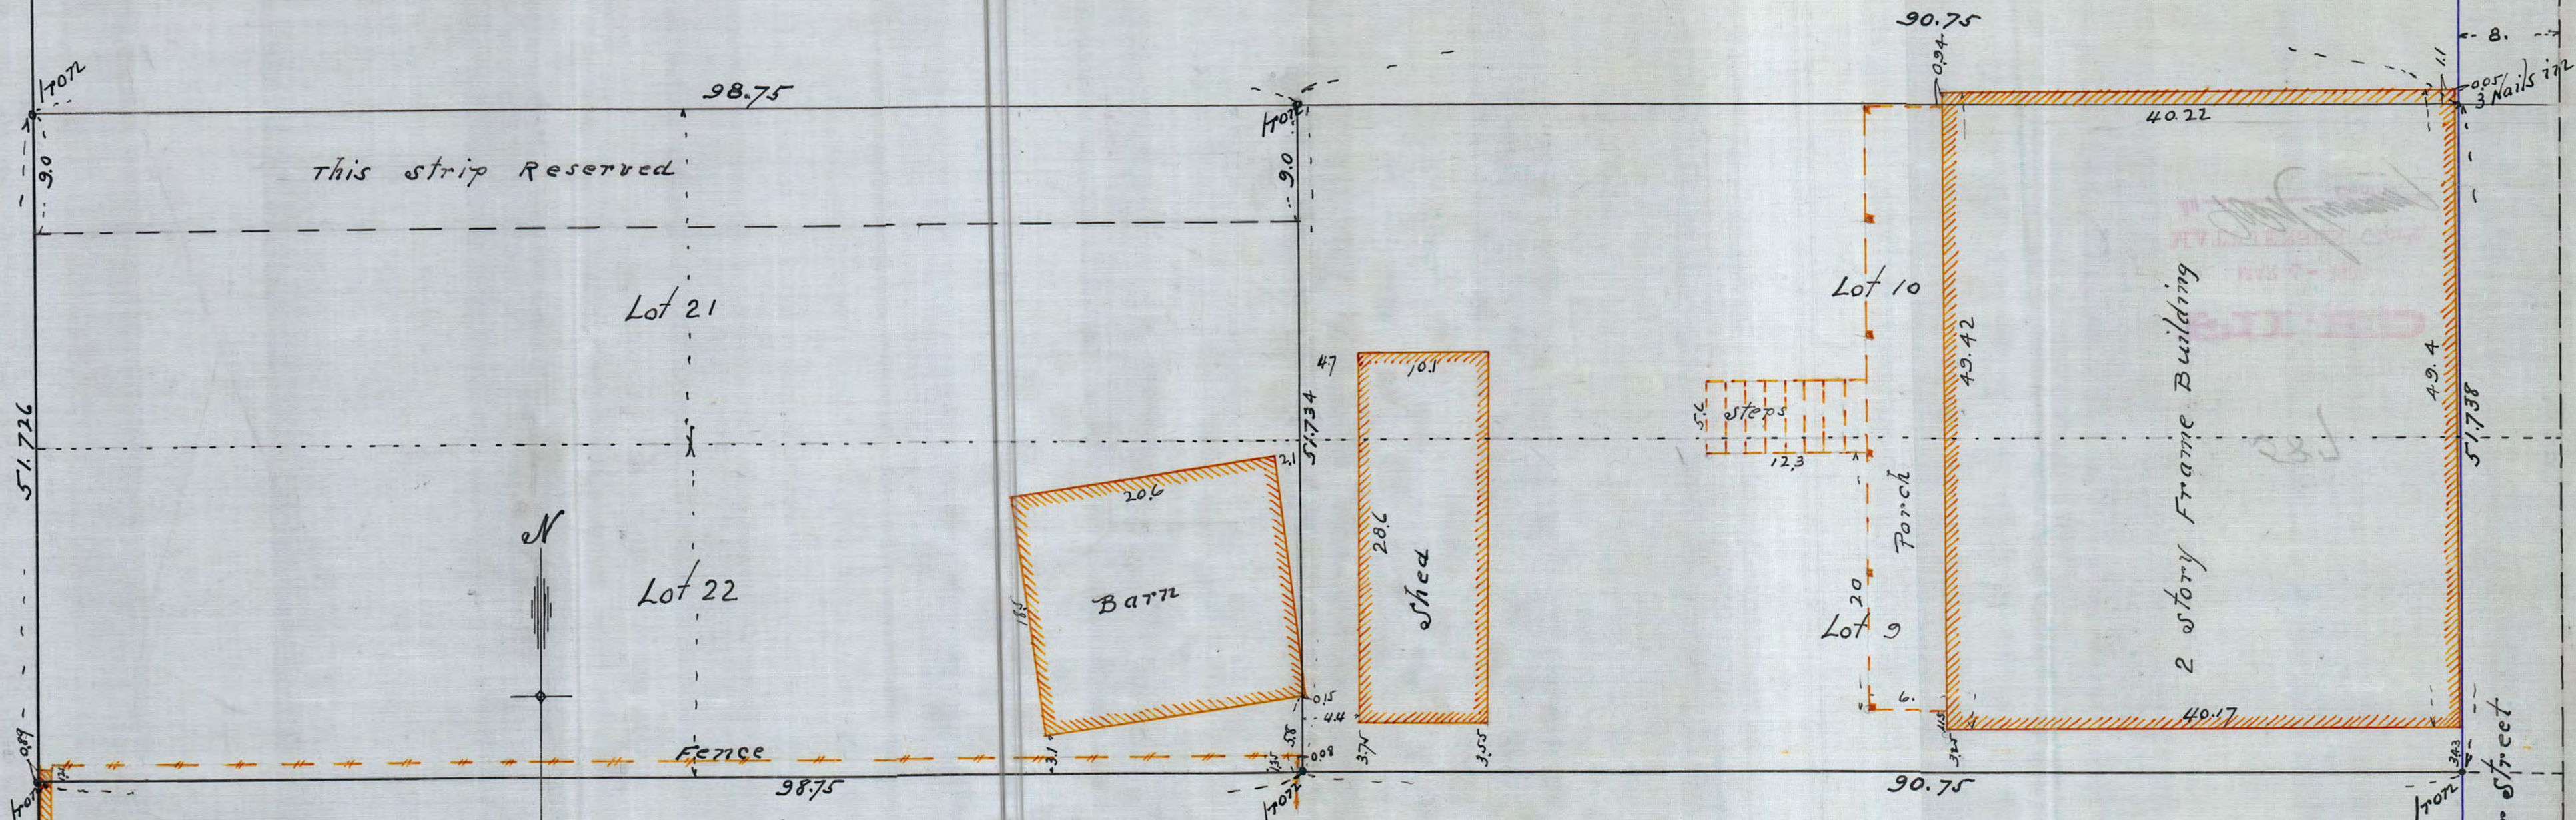

State of Minnesota } ss.  
 County of Ramsey }

J.H. Armstrong being first duly sworn doth depose and say that he is a resident of the City of St Paul County of Ramsey and state of Minnesota and a Civil Engineer by profession He further deposes and says that on the 14th & 15th days of February, A.D. 1908 he made a survey of the premises and real estate shown on the above diagram, the same being Lots 9-10-21 & 22 Block 3 McKenty's out Lots He further deposes and says that the above diagram correctly represents said premises and is an accurate correct and complete survey and diagram thereof, as the same was surveyed by him as aforesaid

Subscribed & Sworn to before me  
 this 1st day of February 1908  
 Notary Public Ramsey Co. Minn.

My Commission expires Jan. 2, 1915.  
 My Commission expires

Opened by City for Street

Original street line

ST.

RICE

# 587