

PLAT OF SURVEY

OF PROPERTY OF _____


DESCRIBED AS FOLLOWS *Lot 15, Auditor's Sub. No. 17.*

SCALE: 1 INCH 20 FEET

o Indicates Iron.

T. J. WELCH, REGISTERED SURVEYOR
738 SURREY AVENUE, ST. PAUL, MINN.

RICE ST.

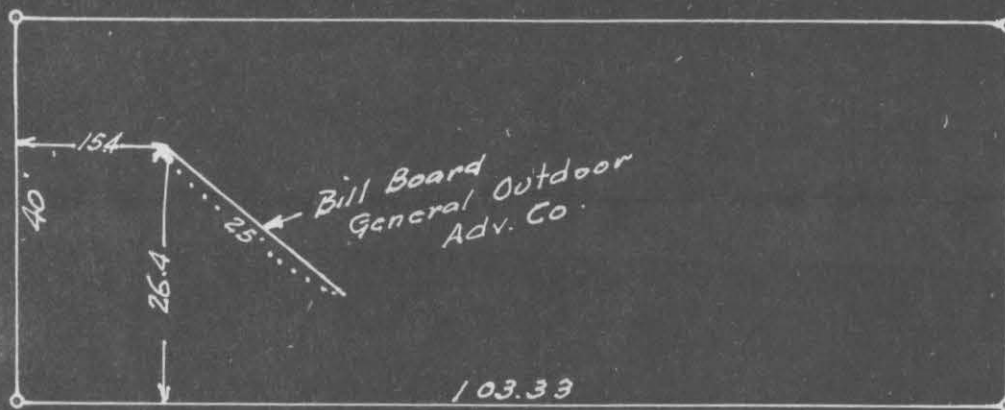

Note There are no encroachments on this vacant lot.

CERTIFICATE OF SURVEY

I hereby certify that on 7-26 1947

I surveyed the property described above and that the above plat is a correct representation of said survey.

T. J. Welch

#5906