


CERTIFICATE of SURVEY

F. J. ARMSTRONG
Civil Engineer and Surveyor
ST. PAUL, MINN.

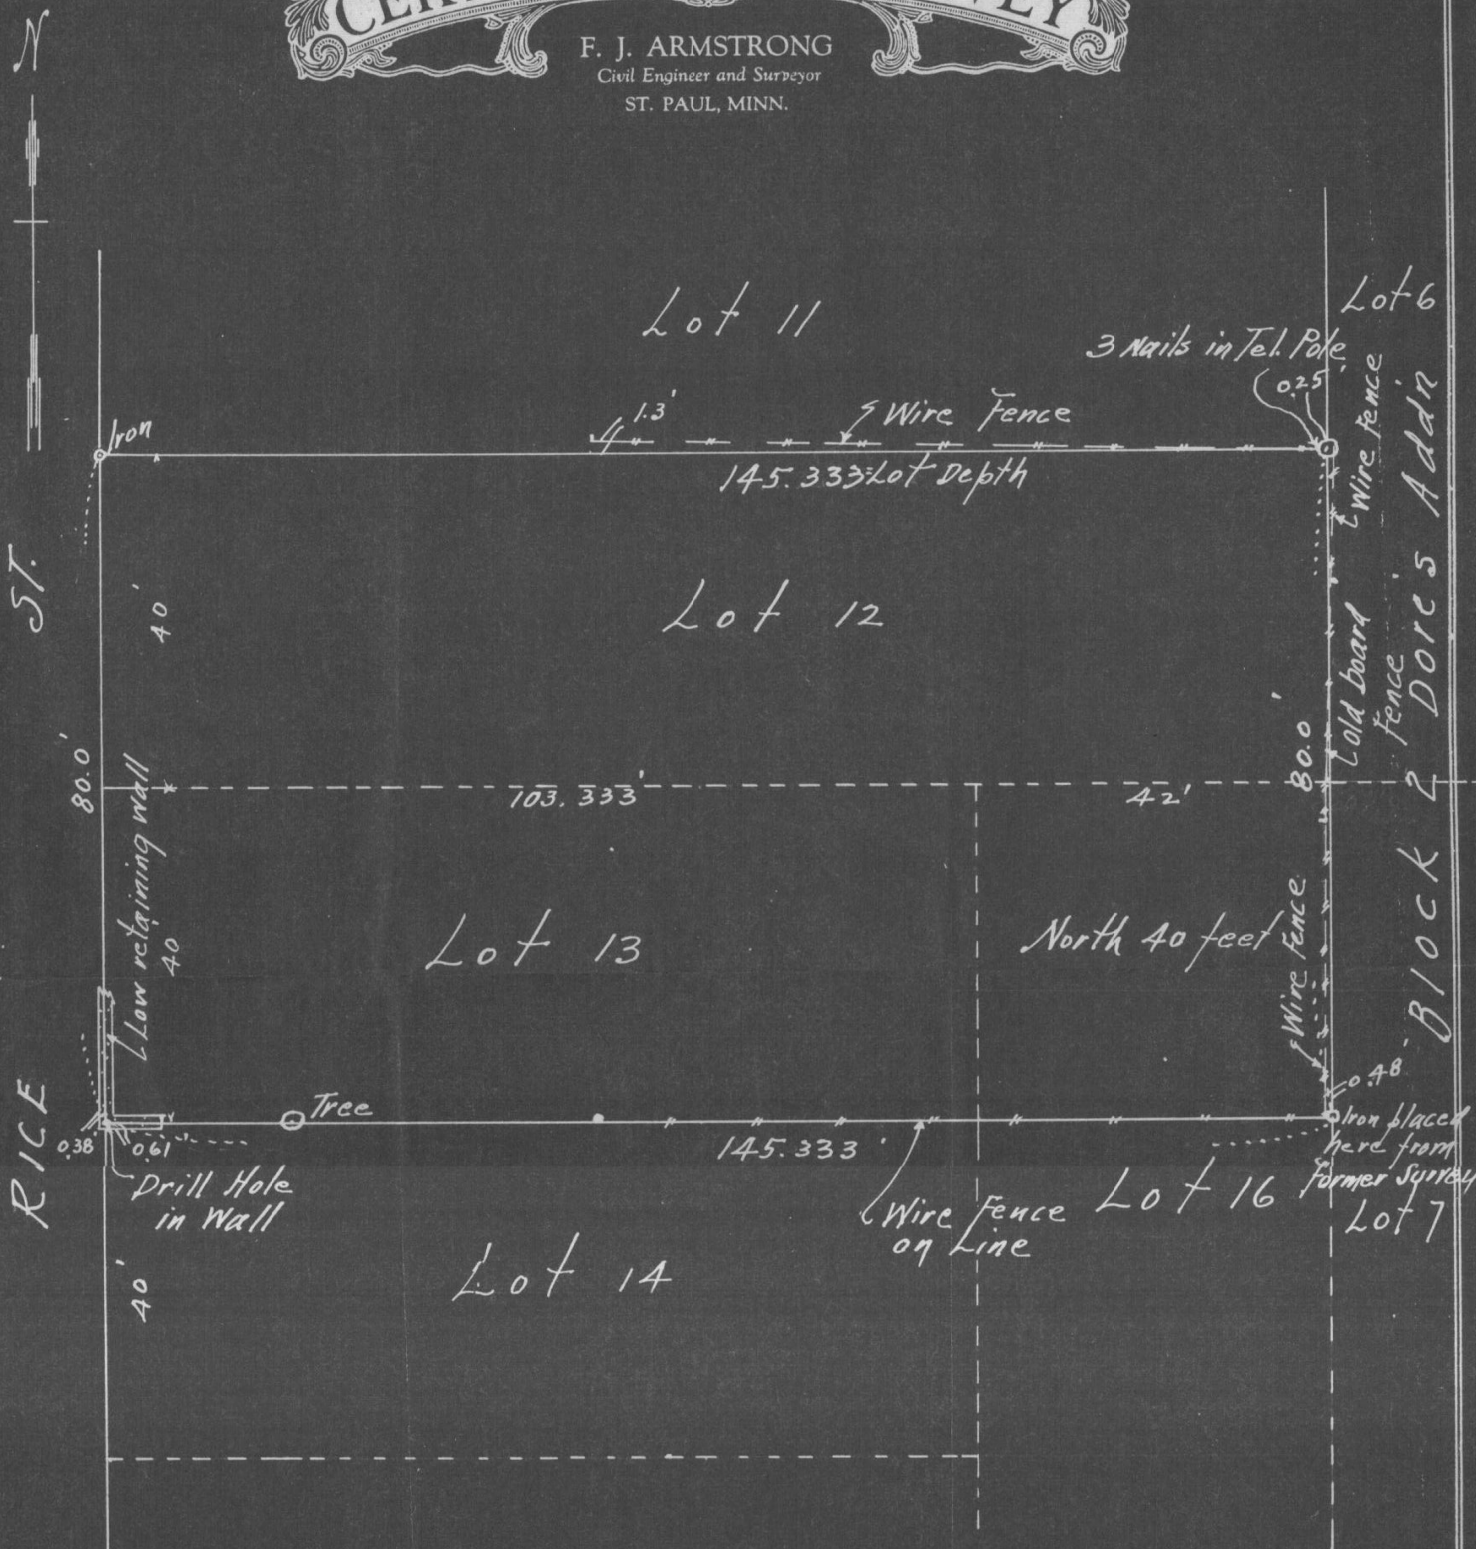

Scale 20 feet per inch

I HEREBY CERTIFY that on the 6th day of November, A. D. 1947
I made a survey of the following described property, to-wit: Lots 12 & 13 and the