

State of Minnesota } ss
County of Ramsey }


J. H. Armstrong
being first duly sworn doth depose and say that he is a resident of the City of St. Paul, County of Ramsey and State of Minnesota and a Civil Engineer by profession. He further deposes and says that on the 24th day of August, A. D. 1907, he made a survey of the premises and real estate shown on this diagram, the same being, The Westerly 20.0 feet of the Easterly 64.0 feet of Lots 14, 15 and 16 Block 23, St. Paul Proper.

He further deposes and says that this diagram correctly represents said premises and is an accurate, correct and complete survey and diagram thereof, as the same was surveyed by him, as aforesaid.

Subscribed and sworn to before me this 31st day of August, A. D. 1907.

William G. White
Notary Public,
Ramsey County,
Minnesota.

My Commission expires Jan. 14, 1914.

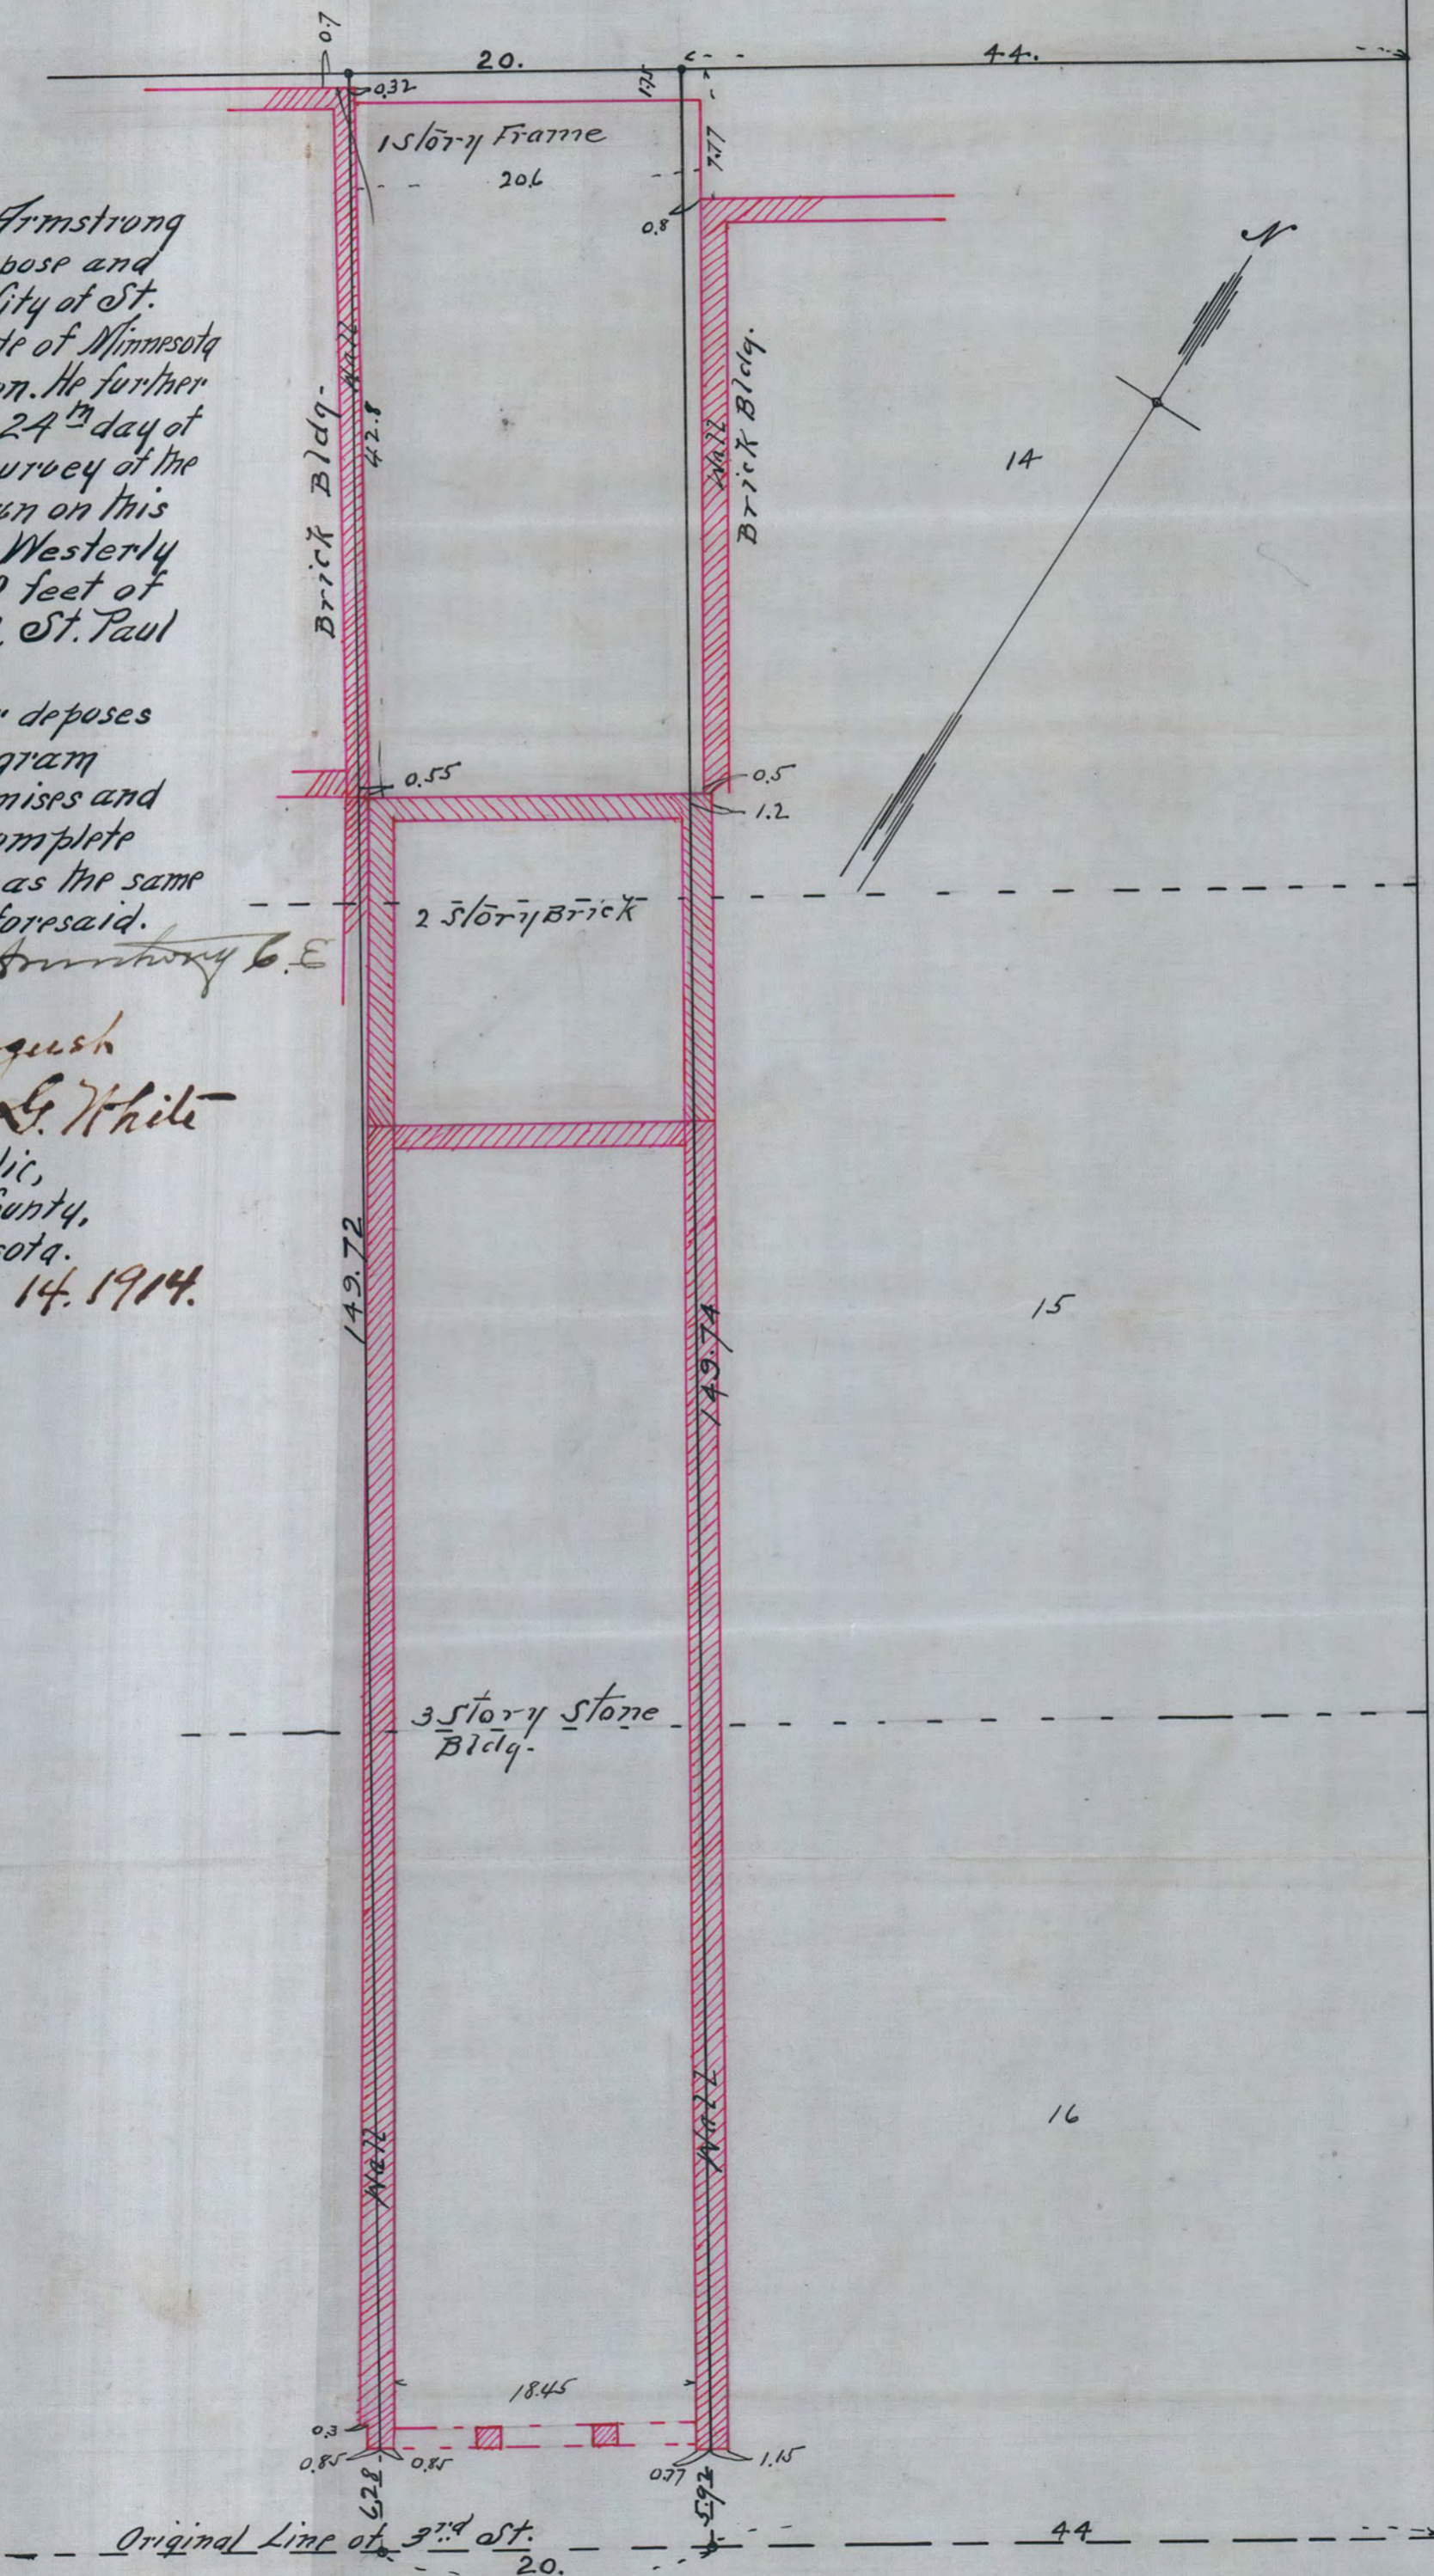

150

CEDEAR

THIRD

ST.