


595

WABASHA ST.

THIRD ST.

ST.

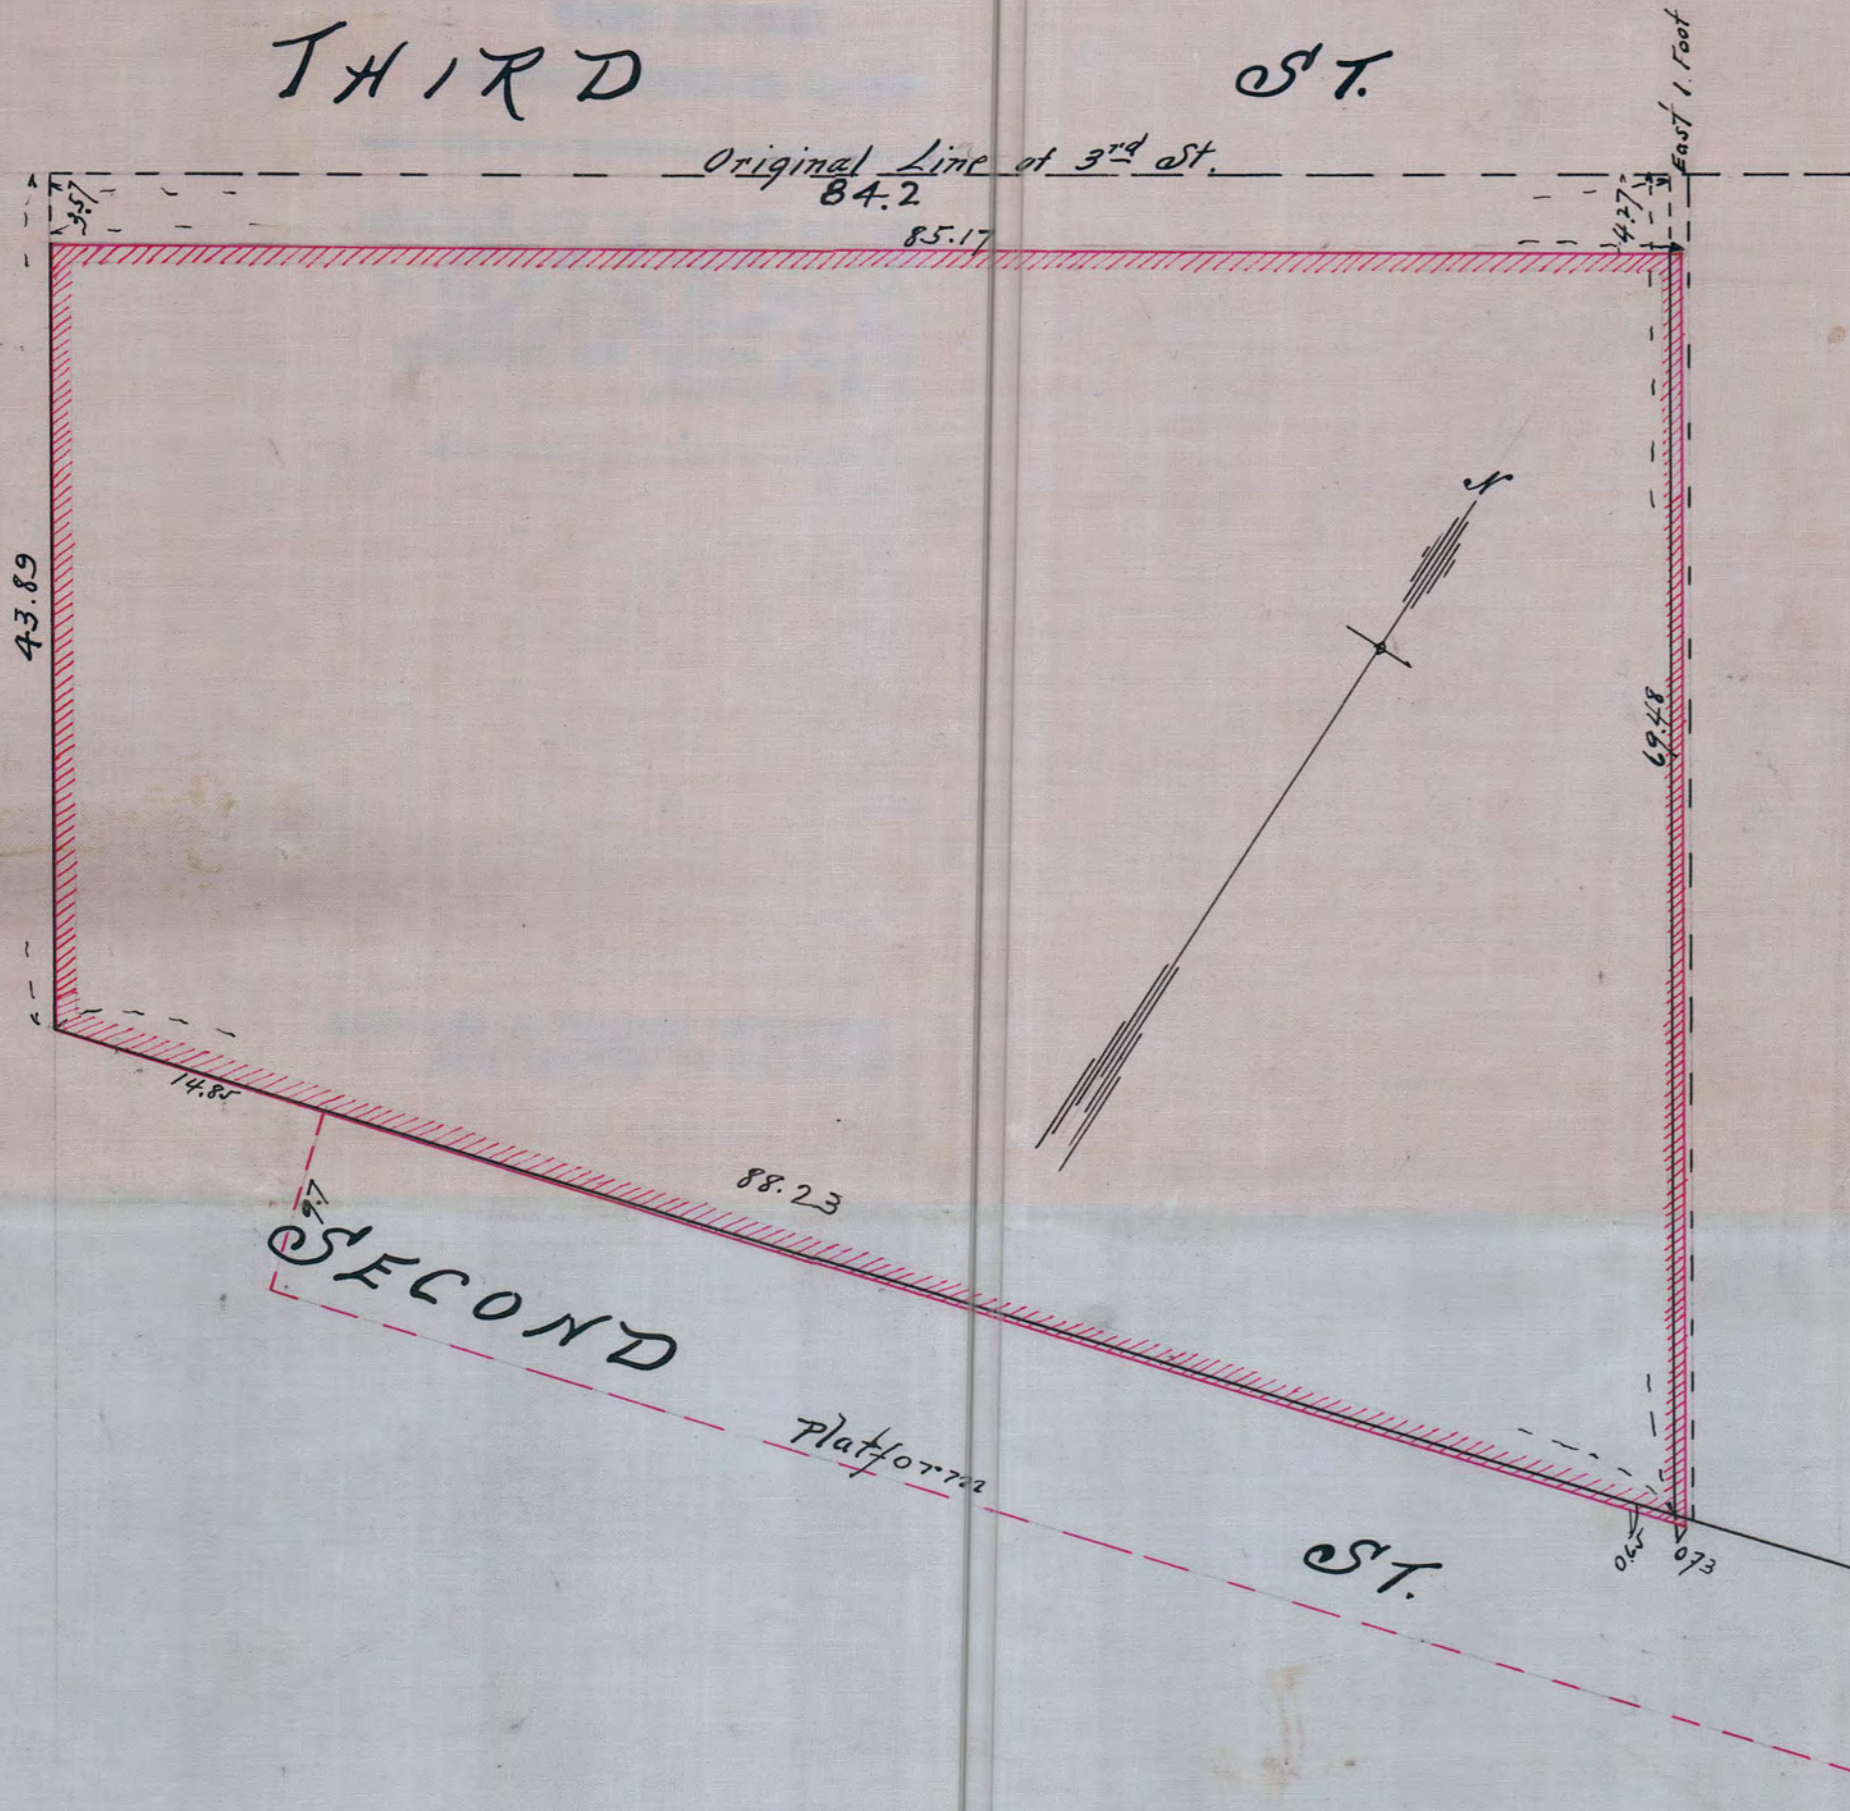

State of Minnesota } ss
County of Ramsey }

J. H. Armstrong being first duly sworn doth depose and say that he is a resident of the City of St. Paul, County of Ramsey and State of Minnesota and a Civil Engineer by profession. He further deposes and says that on the 23rd day of August A.D. 1907, he made a survey of the premises and real estate shown on this diagram, the same being, LOT 1, EXCEPT THE EASTERLY 1.0 FT, BLOCK 3A, ST. PAUL PROPER,

He further deposes and says that this diagram correctly represents said premises and is an accurate, correct and complete survey and diagram thereof, as the same was surveyed by him, as aforesaid.

J. H. Armstrong

Subscribed and sworn to before me
this 31st day of August, A.D. 1907.

William G. White
Notary Public,

Ramsey County,
Minnesota

My Commission Expires Jan 14, 1914

#595