

PLAT OF SURVEY

OF PROPERTY OF _____


DESCRIBED AS FOLLOWS *Lot 14, 15 and 16, Block 34, Rice & Irvine's Addition*

SCALE: 1 INCH *10* FEET
o Indicates Iron.

T. J. WELCH, REGISTERED SURVEYOR
738 SURREY AVENUE, ST. PAUL, MINN.

Note

There are no encroachments on this property.

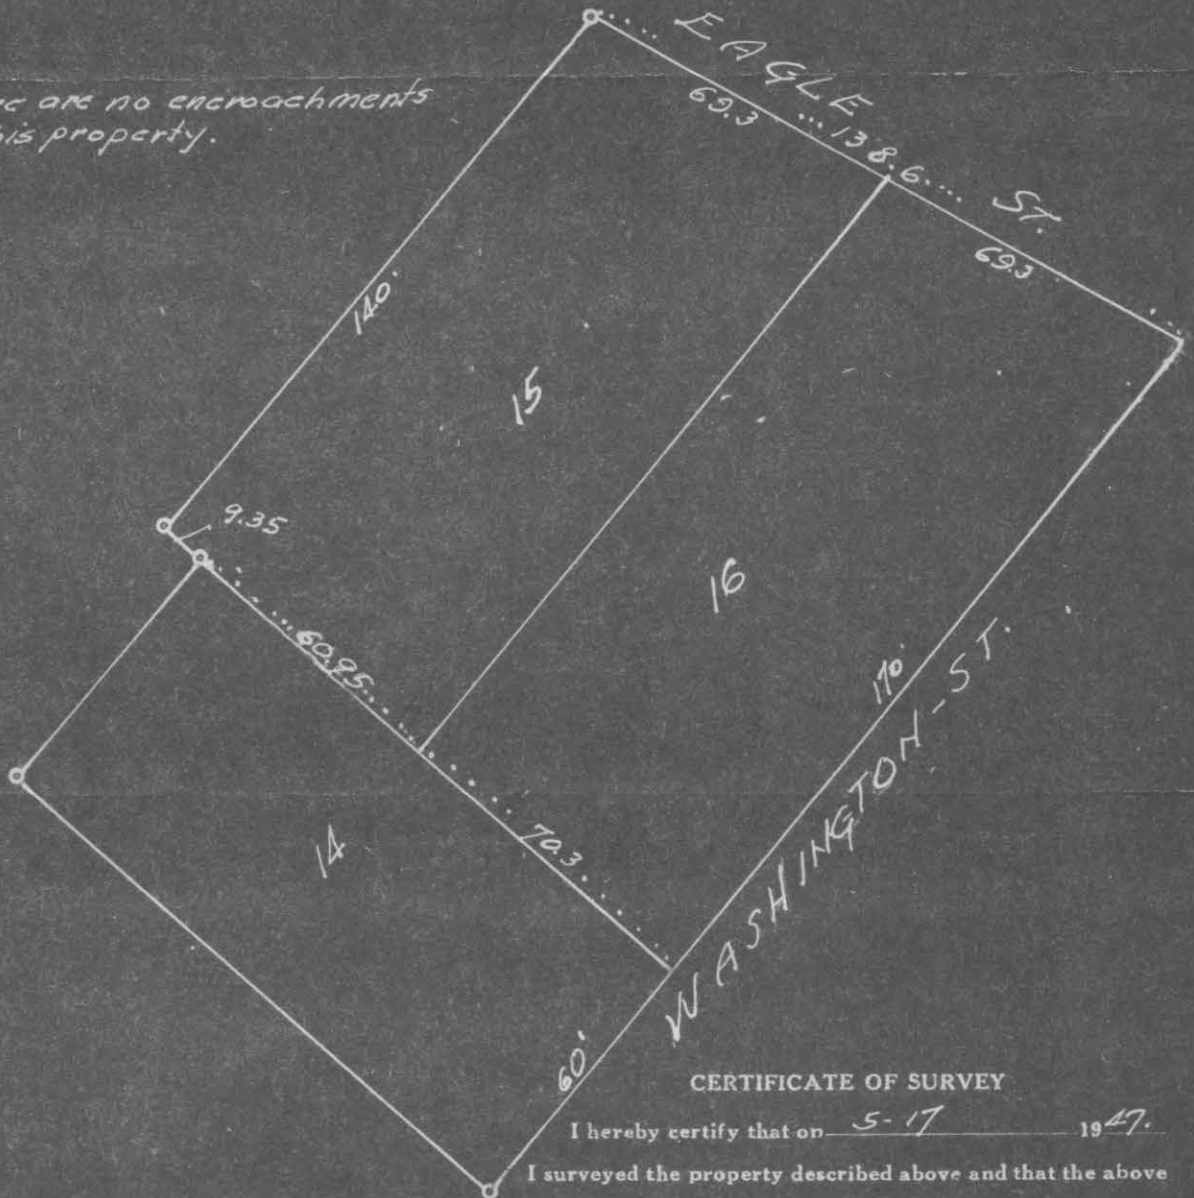

CERTIFICATE OF SURVEY

I hereby certify that on *5-17* 19*47*.

I surveyed the property described above and that the above plat is a correct representation of said survey.

T. J. Welch

#5974