


ROBERT AND RANDALL'S ADD

SURVEY OF

SLY 1/2 LOT 8 BL 7

SEPT 18 - 1906

JENS PEDERSEN
SURY.

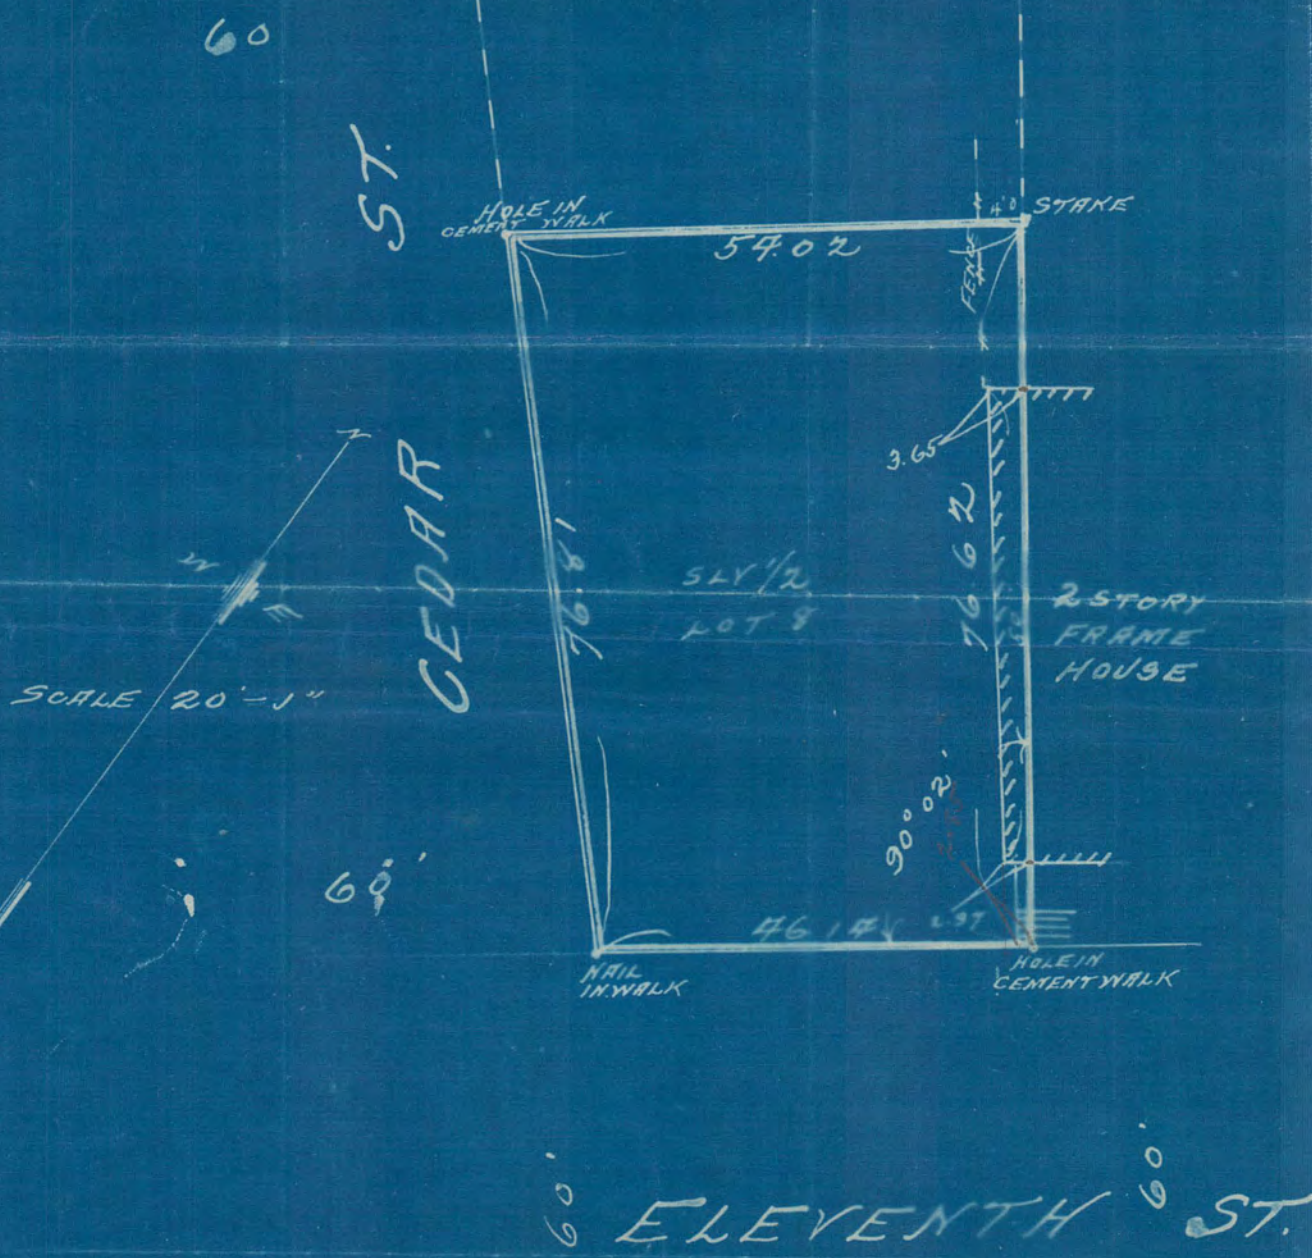

598