

BROOKLYND ADD

SURVEY OF

LOTS 4, 5 AND 6 BL 10

OCT 7-1907

JENS PEDERSEN
SURV.

SCALE 20'=1"


ST PAUL OCT 7-1907

HEREBY CERTIFY TO HAVING SURVEYED
LOTS 4, 5 & 6 BL 10 BROOKLYND ADD TO N. ST PAUL
AND HAVE PLACED STAKES AT THE CORNERS AS INDICATED
ON THIS PLAT AND DISTANCES MARKED HEREON ARE
CORRECT.

Jens Pedersen
SURV.

TENNESSEE

ST.

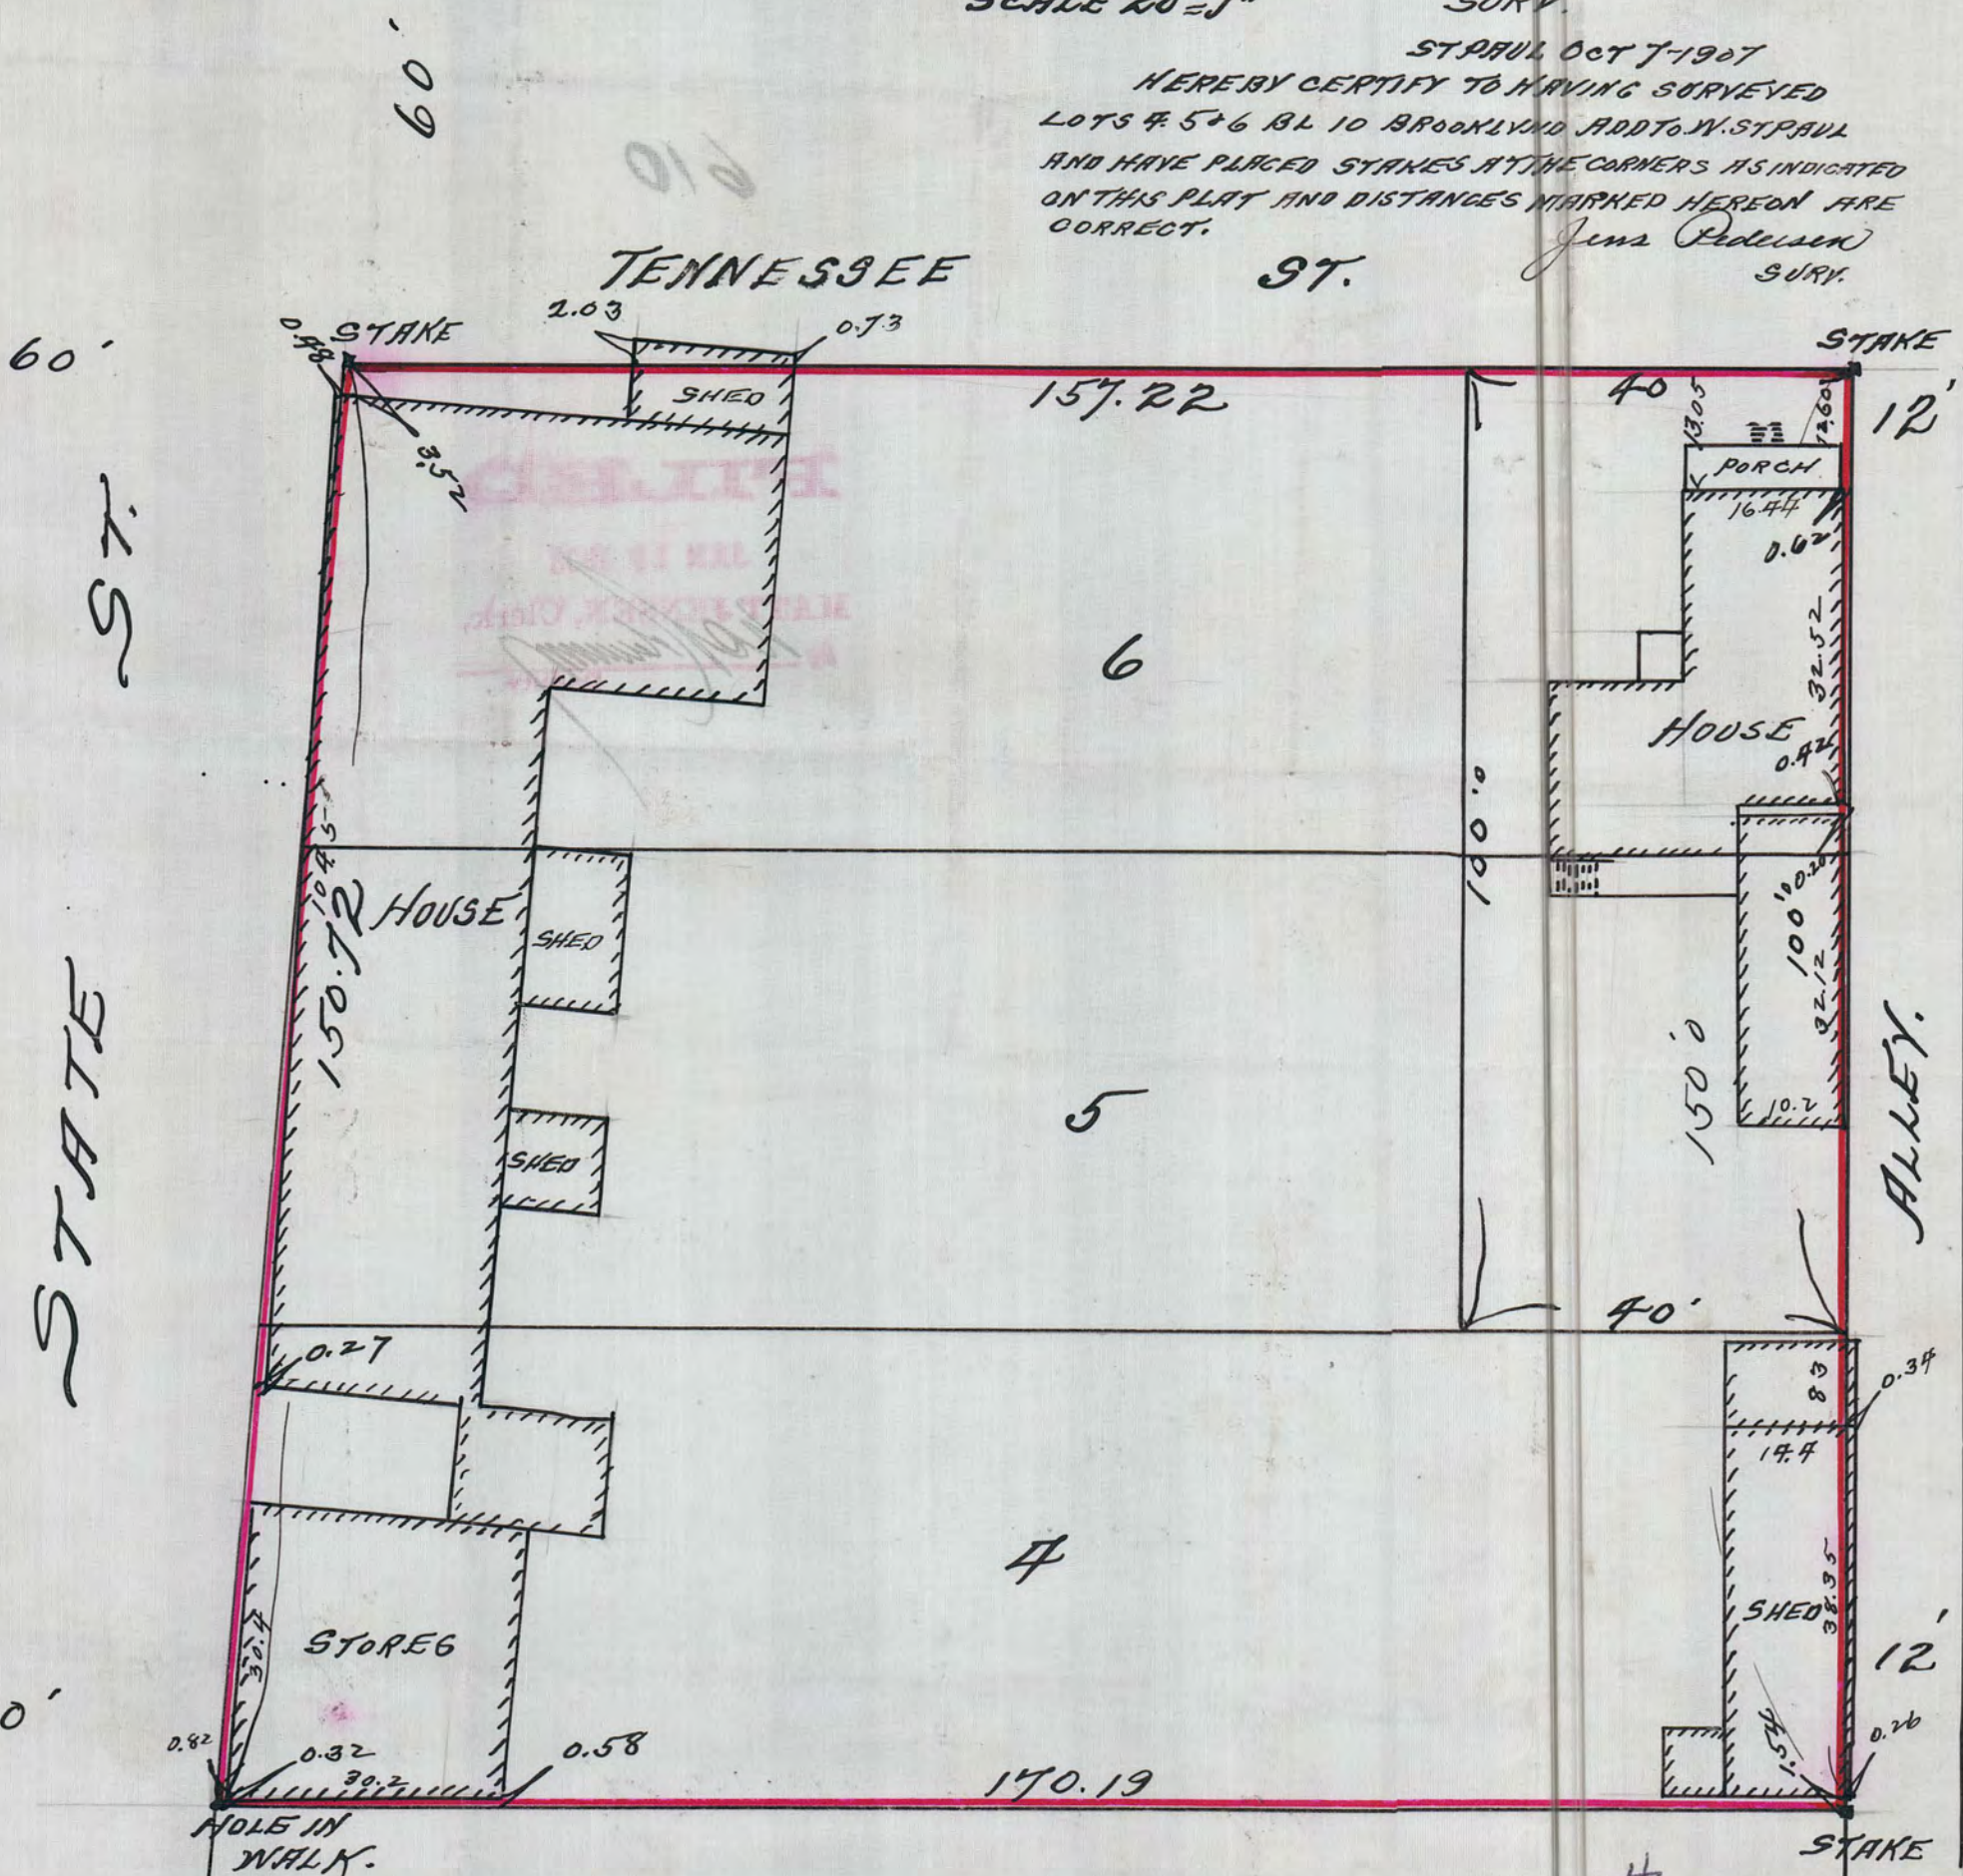

110