

OFFICE OF
RAMSEY COUNTY SURVEYOR
HARRY S. BRONSON

SURVEY OF

LOT 30, BLK. 1 AND LOT 31, BLK. 2 OF
THE NORTH ST. PAUL LAND CO'S RE. OF
THE EAST 120 FT. OF BLK. 7 AND THE
WEST 120 FT. OF BLK. 15 AND ALL OF
BLK. 10 OF NORTH ST. PAUL PROPER.

SCALE 1 IN. = 20 FT.

JAN. 30, 1948

o INDICATES IRON


SURVEYED BY

Wm. A. Anko

REGISTERED SURVEYOR

MINNESOTA CERTIFICATE No. 2042

6122

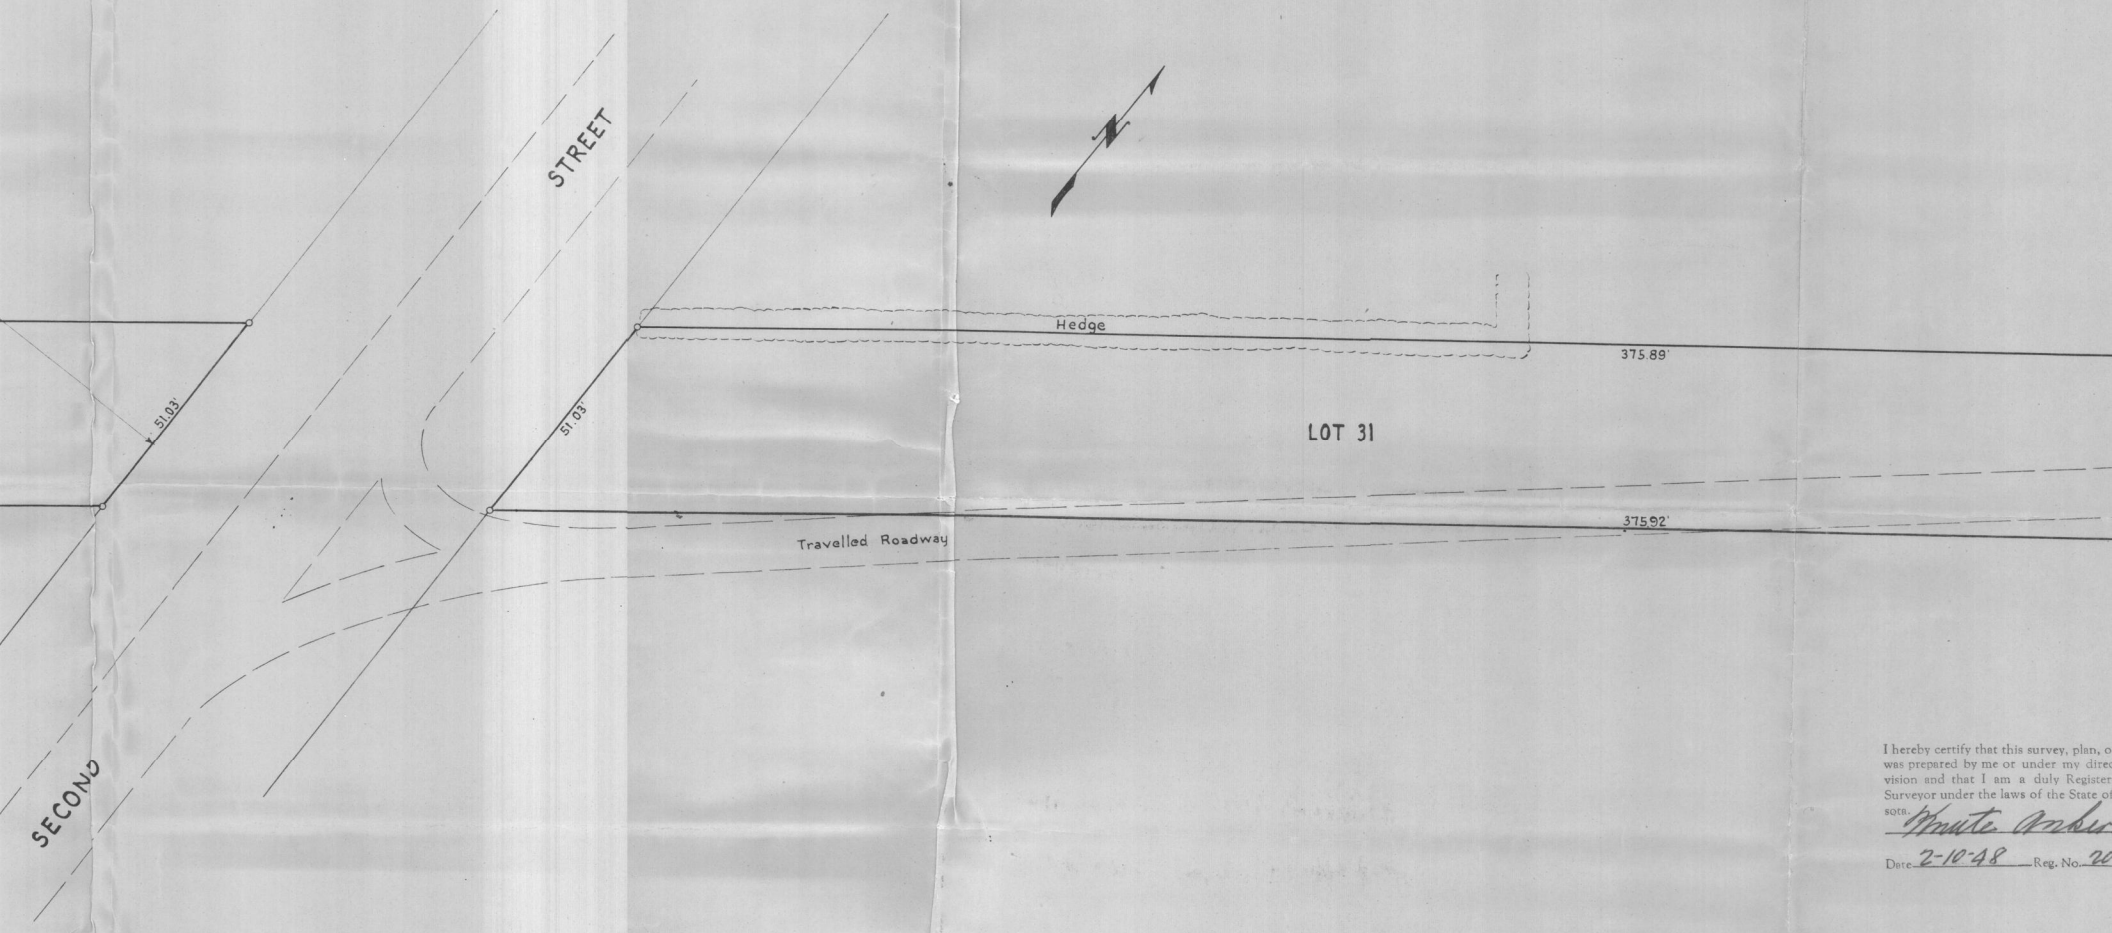

I hereby certify that this survey, plan, or map was prepared by me or under my direct supervision and that I am a duly Registered Surveyor under the laws of the State of Minnesota.

Wm. A. Anko

Date 2-10-48 Reg. No. 2042