


# CERTIFICATE of SURVEY

F. J. ARMSTRONG  
Civil Engineer and Surveyor  
ST. PAUL, MINN.

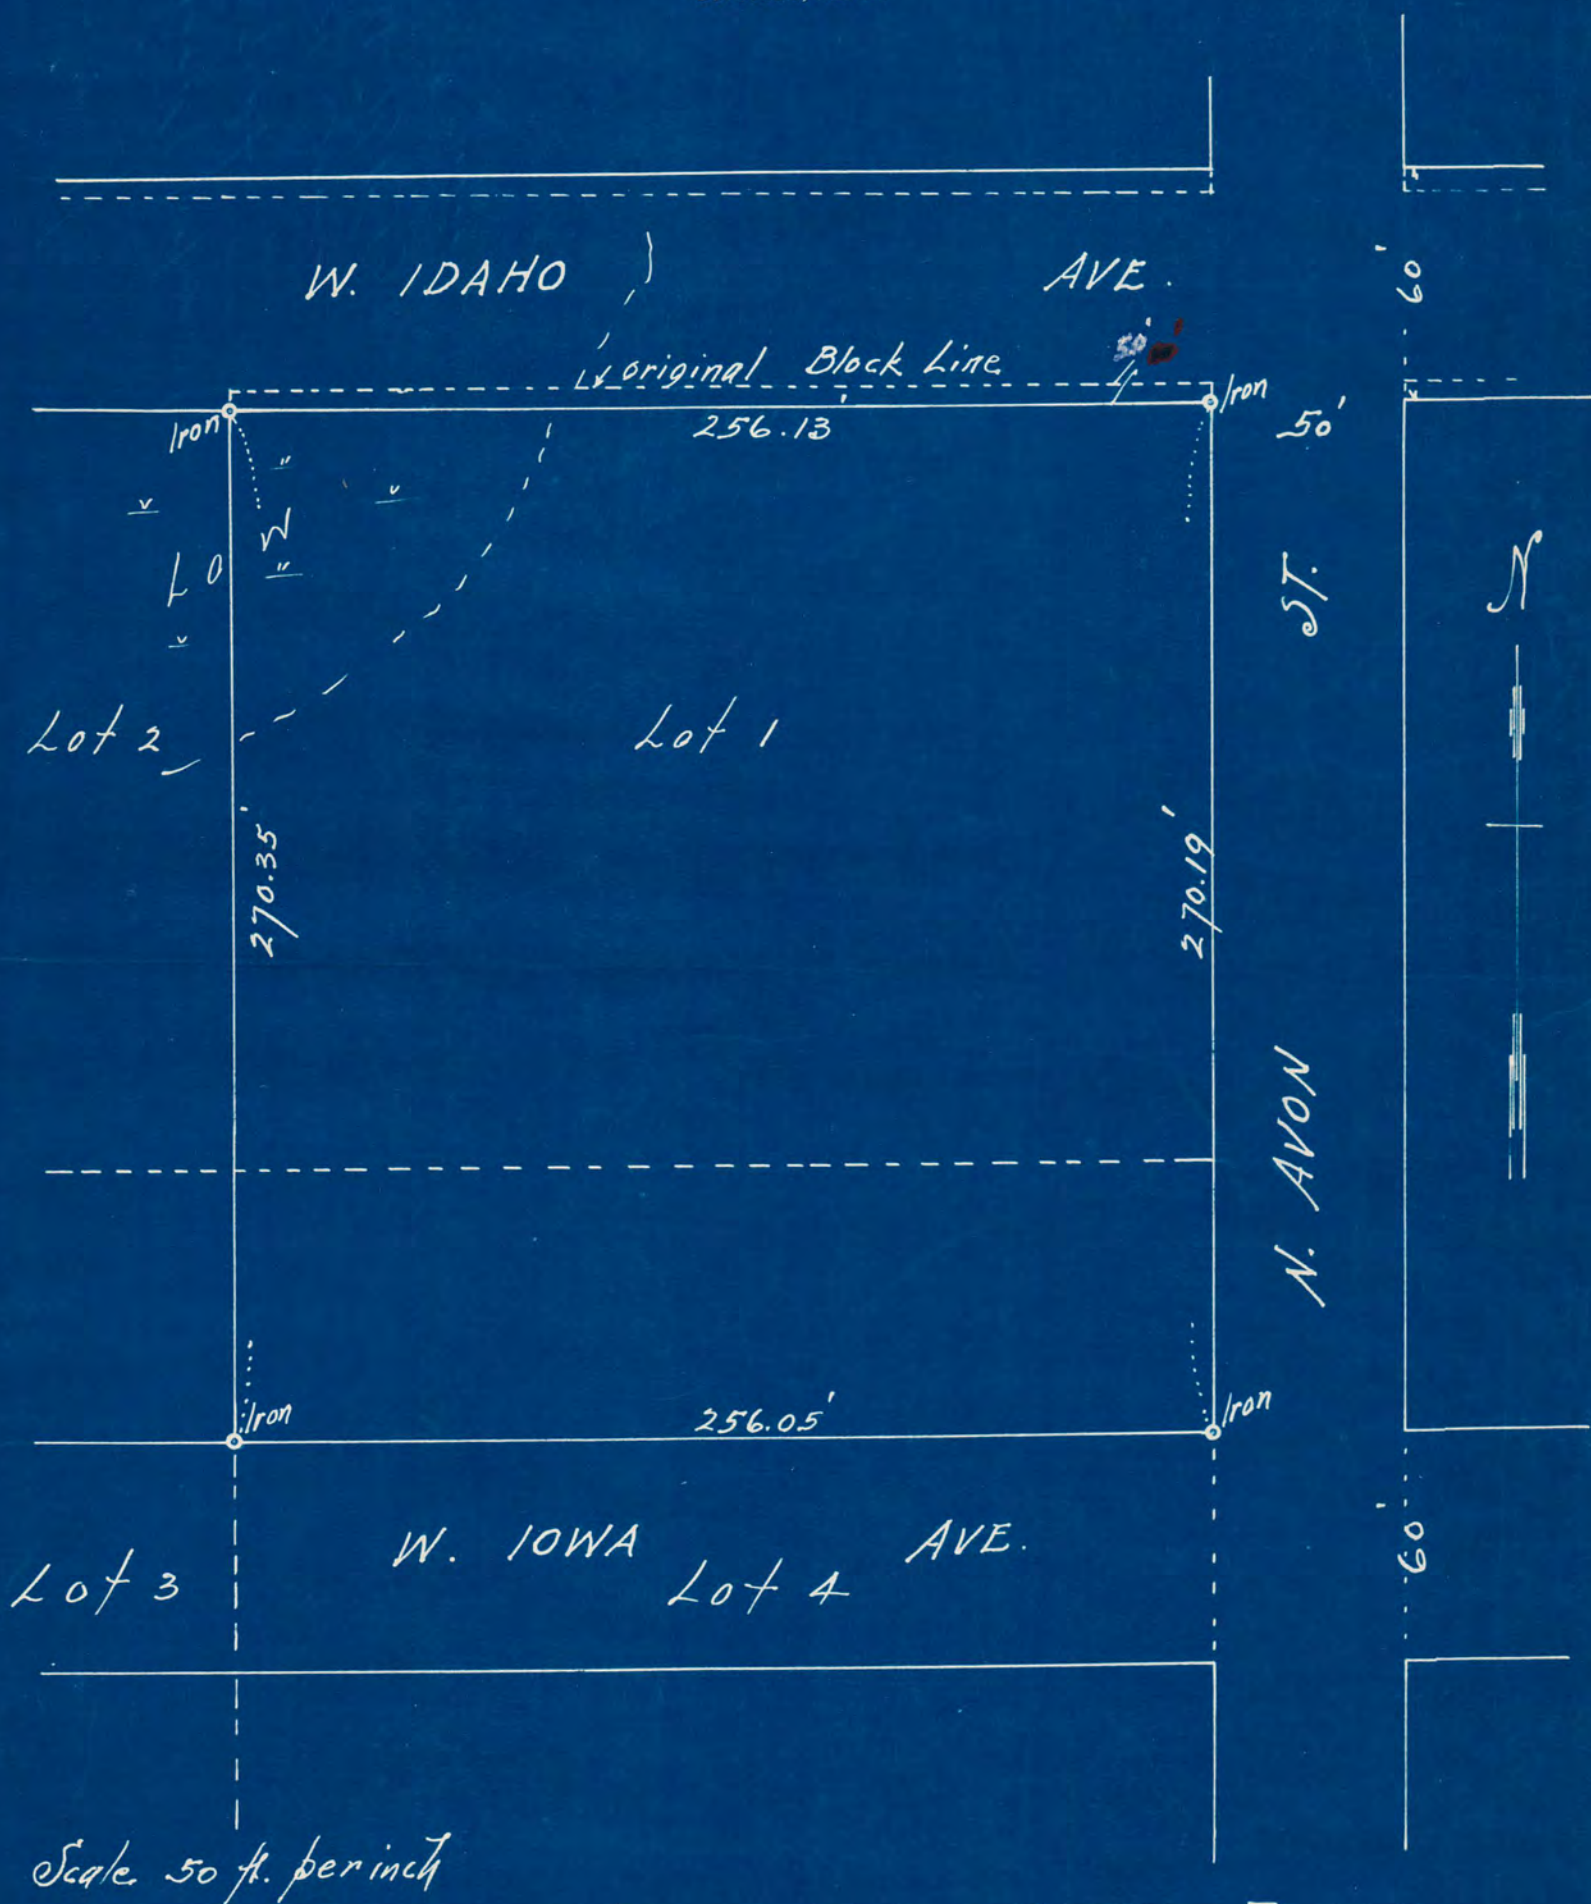

Scale 50 ft. per inch

I HEREBY CERTIFY that on the 22<sup>nd</sup> day of June, A. D. 1948  
 I made a survey of the following described property, to-wit: Lot 1 & that part of  
Lot 4 lying north of W. Iowa Ave. all in Block 13 Como  
St. Paul, Minn.  
 and the map hereon shown is a true and correct map of said survey and that the improvements thereon  
 indicated are correctly shown.

Subscribed and sworn to before me this \_\_\_\_\_ day of \_\_\_\_\_, 19\_\_\_\_  
 \_\_\_\_\_  
 Notary Public.

My Commission Expires \_\_\_\_\_

F. J. Armstrong Civil Engineer.

#6292