


SURVEY OF THE SOUTH 41.95 FT. OF THE NORTH 81.95 FT. OF LOTS
16-17 & 18, BLOCK 3, EASTVILLE HEIGHTS ADD. ST. PAUL, MINN.

ENGINEERING SERVICE CO.
W.G. Ramlow,
REG. SURVEYOR & ENGR.
700 COMMERCE BLDG.
ST. PAUL, MINN.
JUNE-16-48.

SCALE: 1 IN = 50 FT.
O INDICATES IRON.

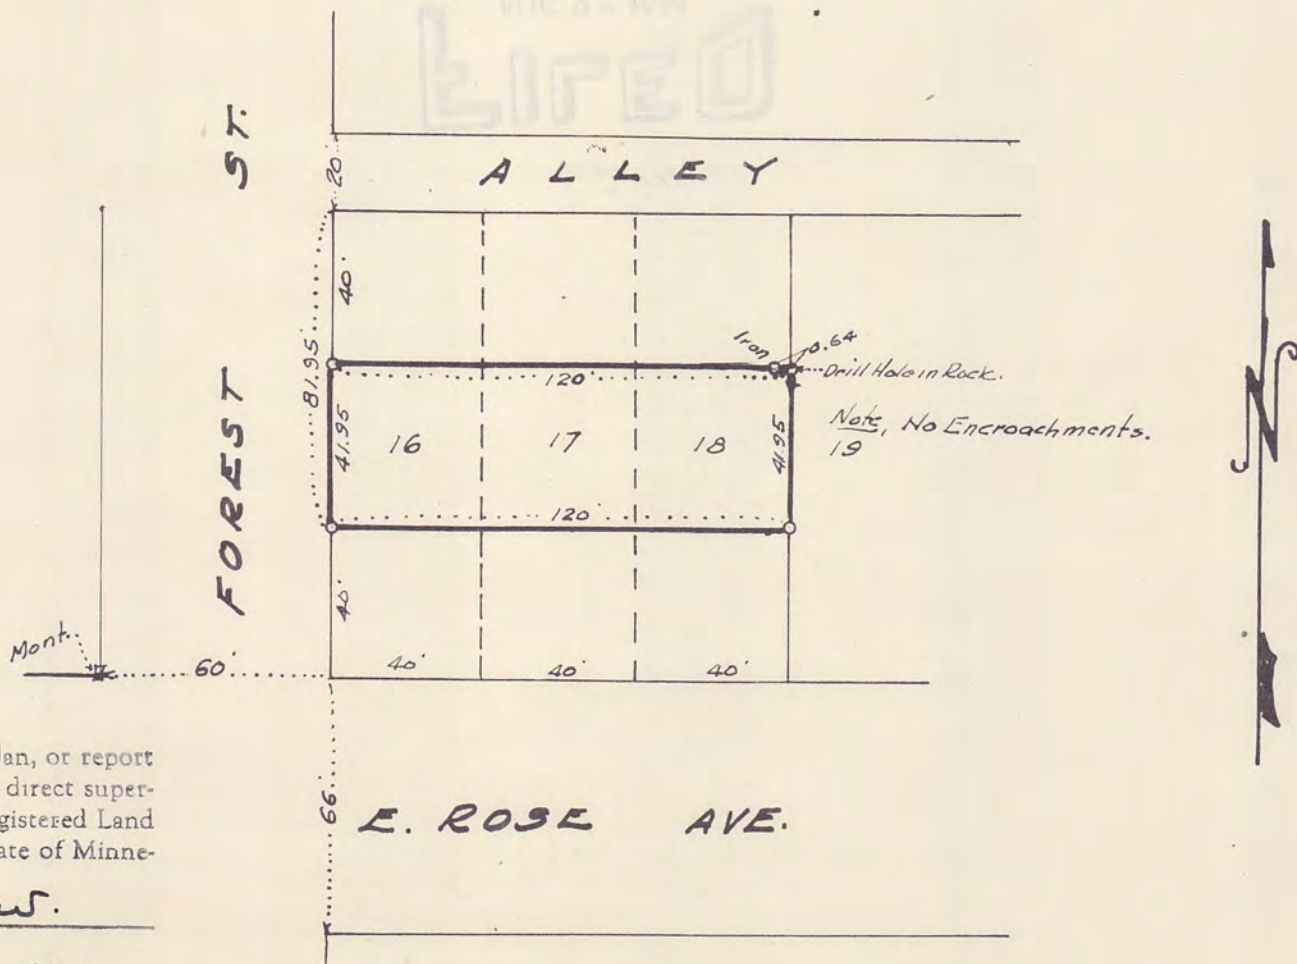

I hereby certify that this survey, plan, or report
was prepared by me or under my direct super-
vision and that I am a duly Registered Land
Surveyor under the laws of the State of Minne-
sota.

W.G. Ramlow.

Date 6-21-48. Reg. No. 1150

6294