


637

LOT 11 BLOCK 5  
WOODLAWN PARK.

Scale 20 Feet per inch

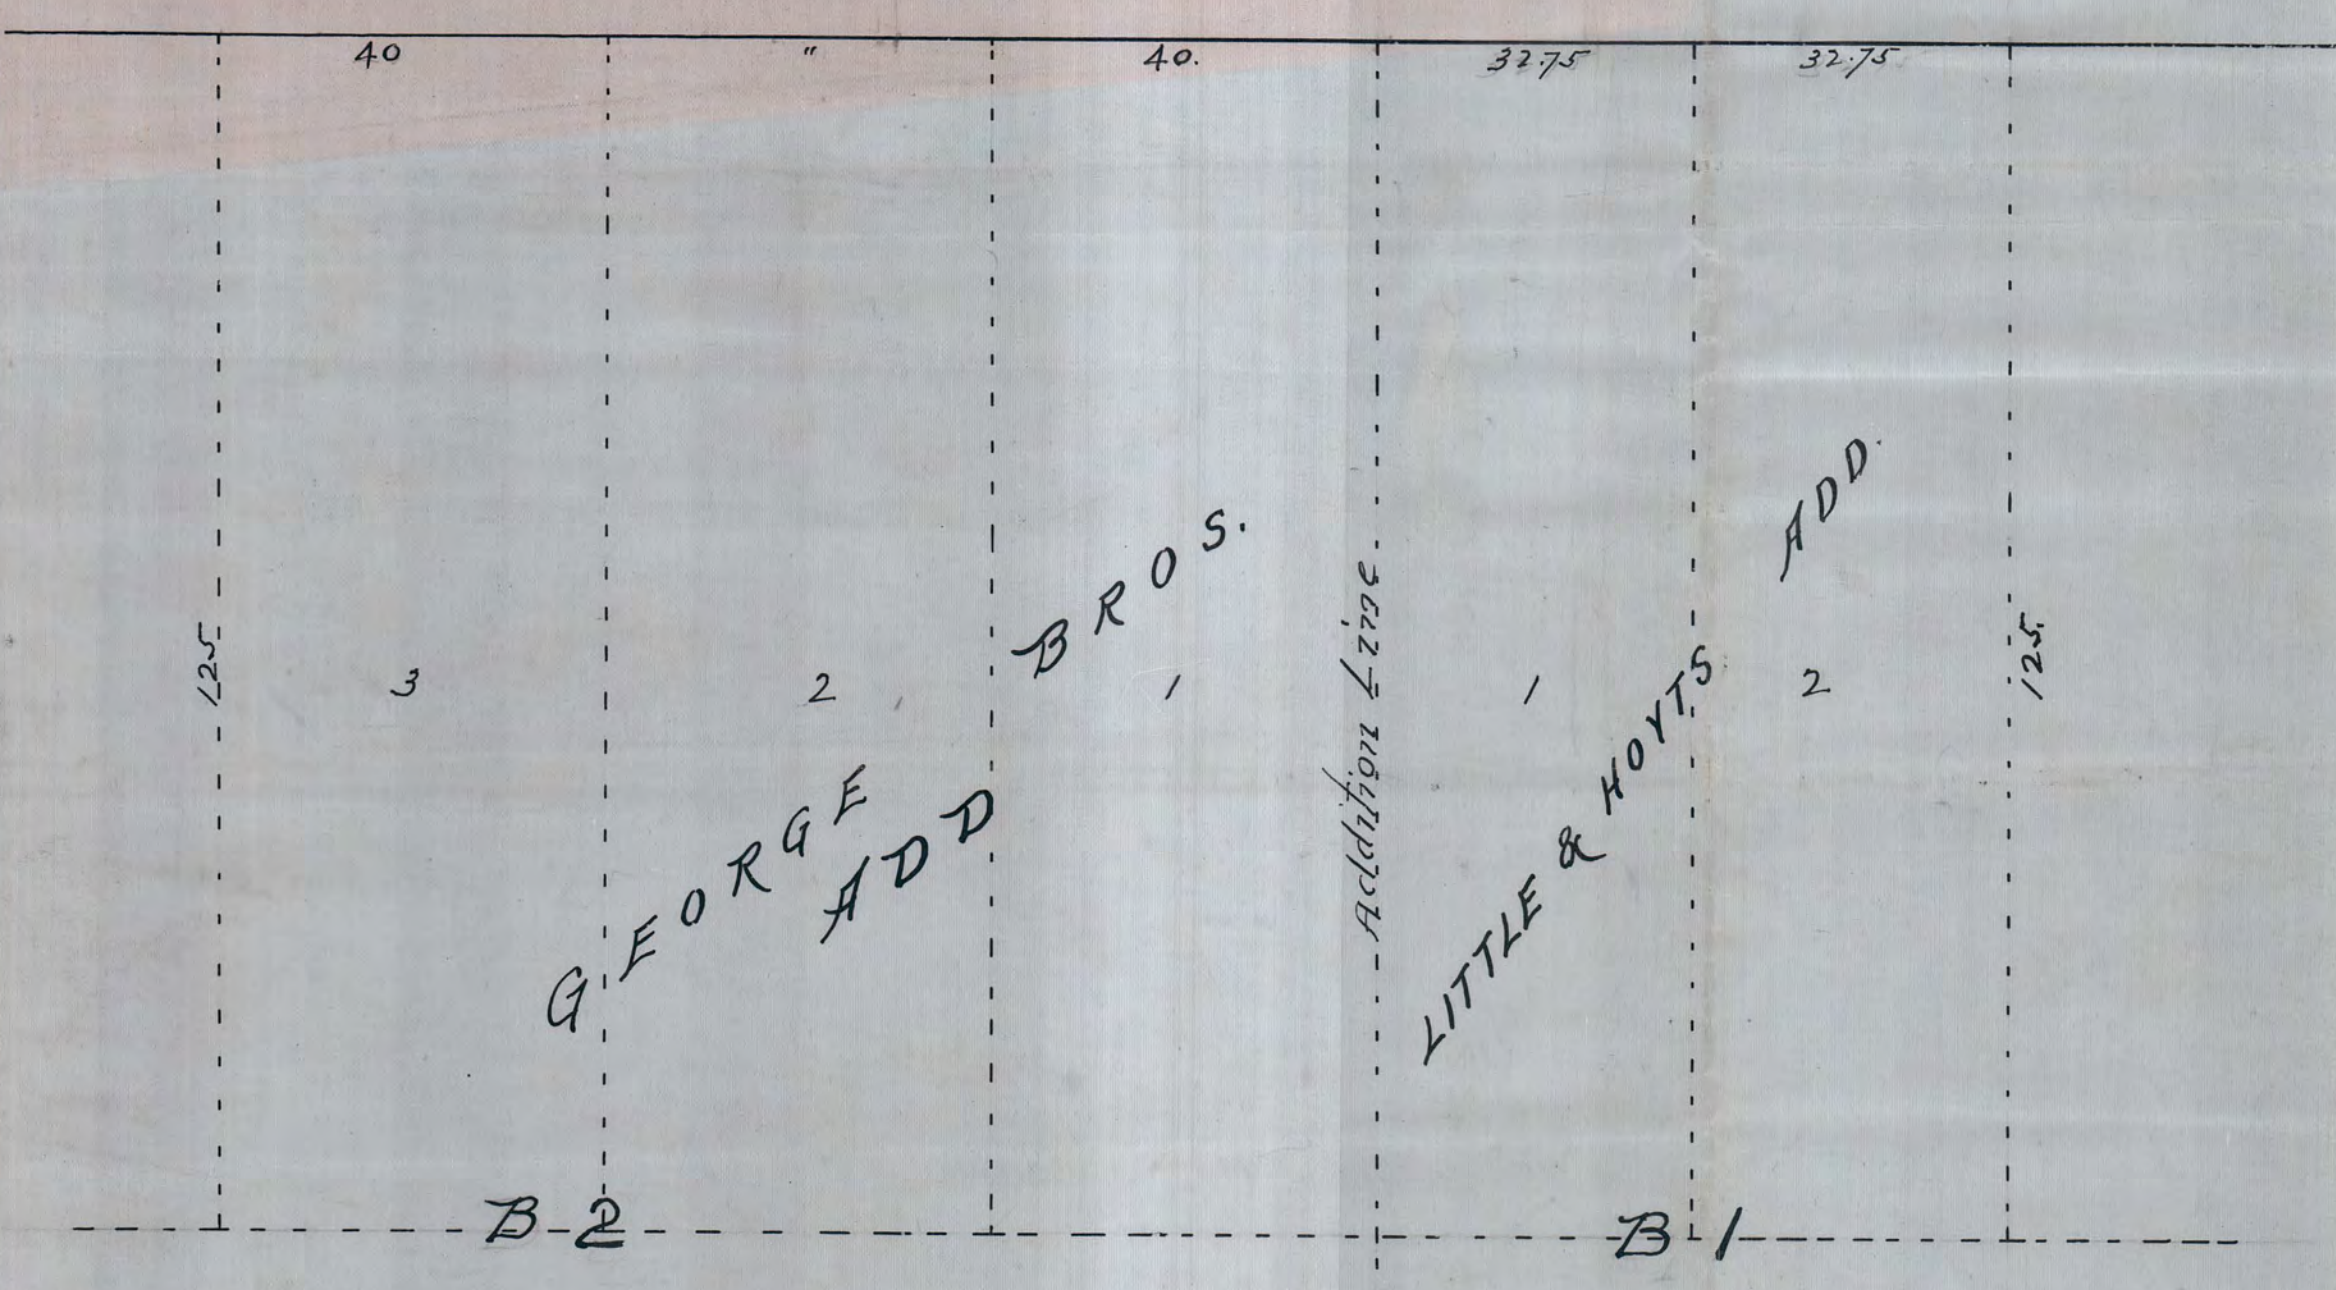

State of Minnesota }  
County of Ramsey } ss.

J.H. Armstrong being first duly sworn doth  
depose and say that he is a resident of the City of St. Paul, County of  
Ramsey and state of Minnesota and a Civil Engineer by profession.  
He further deposes and says that on the 5<sup>th</sup> & 6<sup>th</sup> days of  
December A.D. 1907 he made a survey of the premises and real estate  
shown on the above diagram the same being "Lot 11, Block 5  
WOODLAWN PARK ADD. & THE NORTHERLY 1/2 OF THE TERRI-  
TORIAL ROAD VACATED, LYING SOUTHERLY OF SAID LOT 11. He  
further deposes and says that the above diagram correctly  
represents said premises and is an accurate, correct and complete  
survey and diagram thereof, as the same was surveyed by him  
as aforesaid.

Subscribed & Sworn to before me  
this 9<sup>th</sup> day of December, 1907.

Notary Public Ramsey Co. Minn.

My Commission expires January 14, 1914.

# 637