

6421


SCALE: 1 INCH = 20 FEET

PLAT OF SURVEY

OF PROPERTY OF _____

DESCRIBED AS FOLLOWS Lots 7 and 8, Block 7, Bazille & Guerin's Add. to St. Paul Minn.

6421

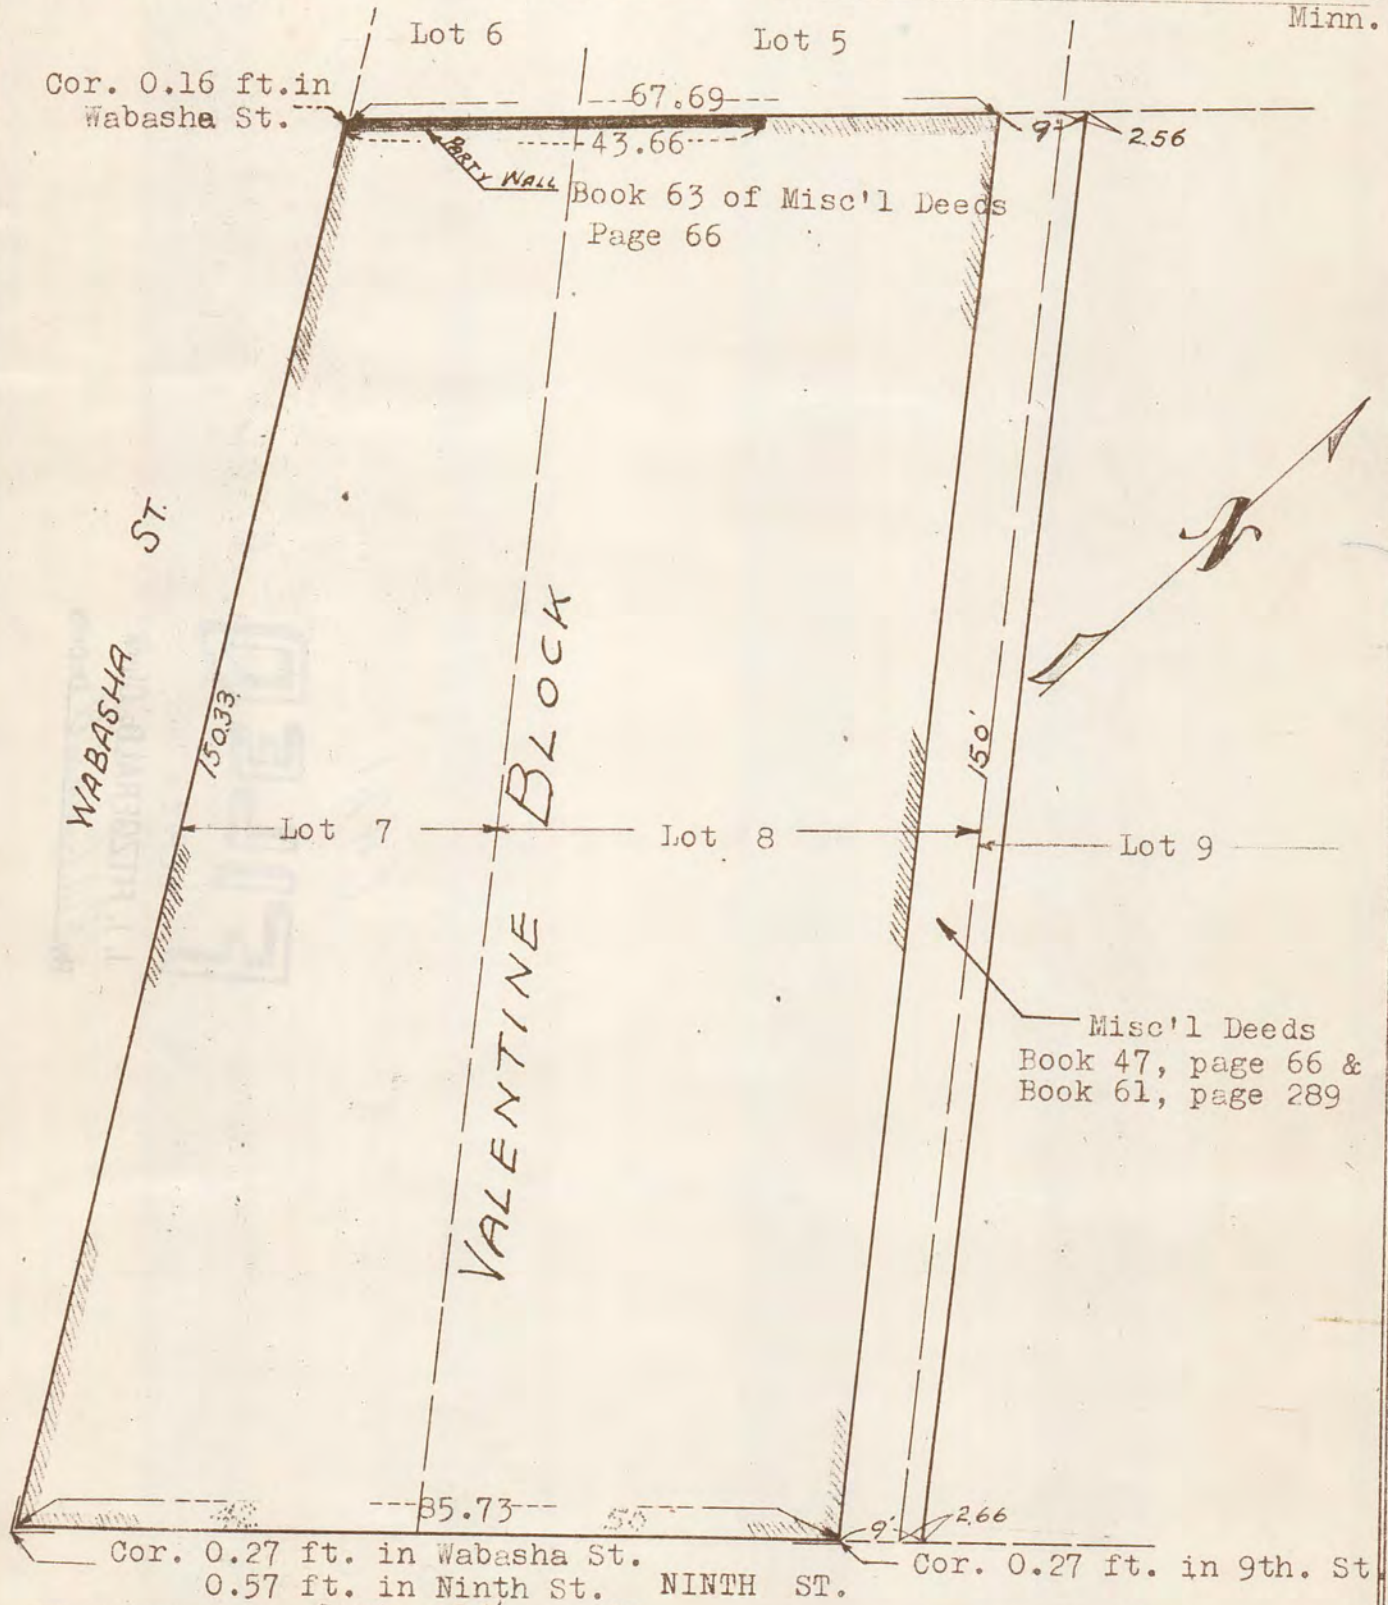

I hereby certify that on Sept. 13th 1948
 I made a survey of the location of the building(s) on the above
 described property and that the location of said building(s)
 is correctly shown on the above plat.

D.O. Weber
 D.O. Weber

I hereby certify that on Sept. 11th, 1948
 I surveyed the property described above and that the above
 plat is a correct representation of said survey.

D.O. Weber
 REGISTERED SURVEYOR, NO. 665

6421