


# PLAT OF SURVEY

OF PROPERTY OF *Dominick J. Palumbo & Patricia L. Palumbo.*

DESCRIBED AS FOLLOWS *Lot 1, and the East 30 feet of Lot 2, Block 17,  
Auditors Subdivision No. 62.*

SCALE: 1 INCH *30* FEET  
O Indicates Iron.

T. J. WELCH, REGISTERED SURVEYOR  
738 SURREY AVENUE, ST. PAUL, MINN.

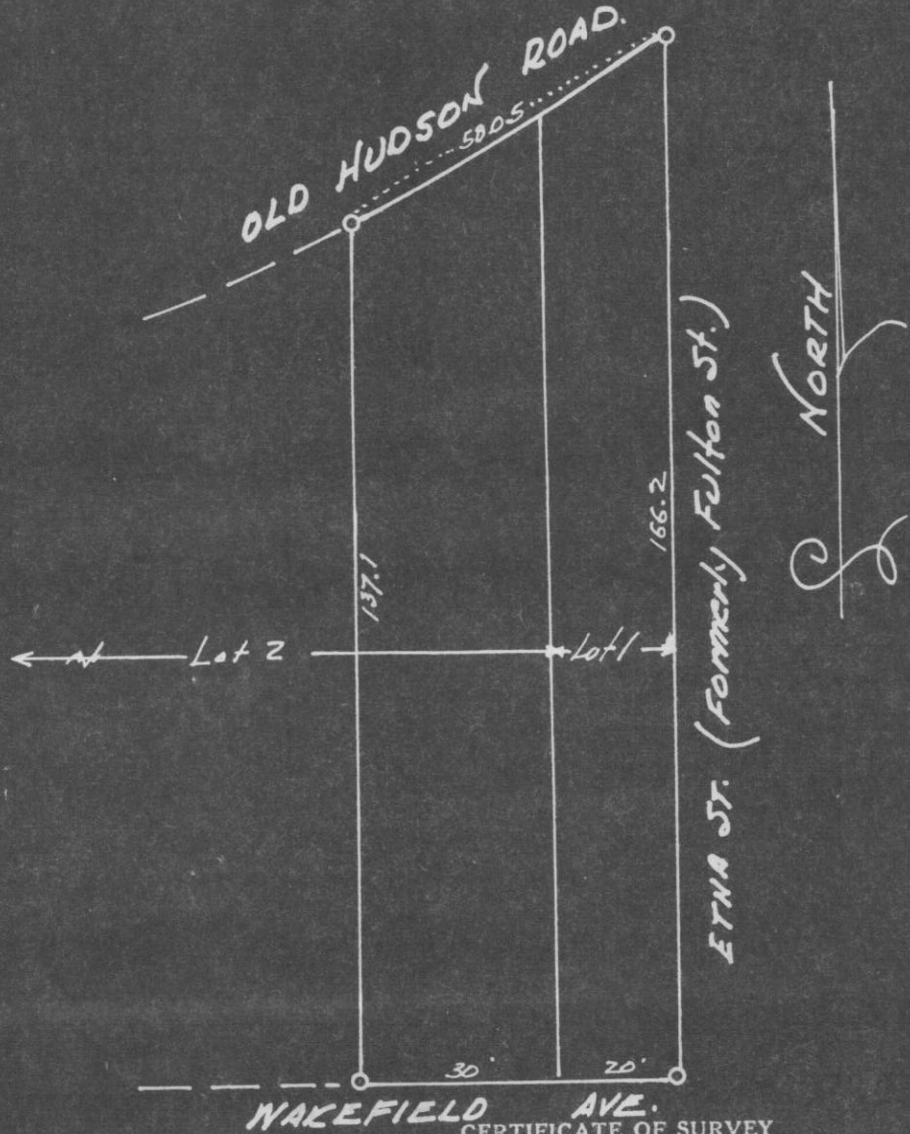

CERTIFICATE OF SURVEY


I hereby certify that on *May 17* 19 *48*

I surveyed the property described above and that the above plat is a correct representation of said survey.

*T. J. Welch*

#6433

6433

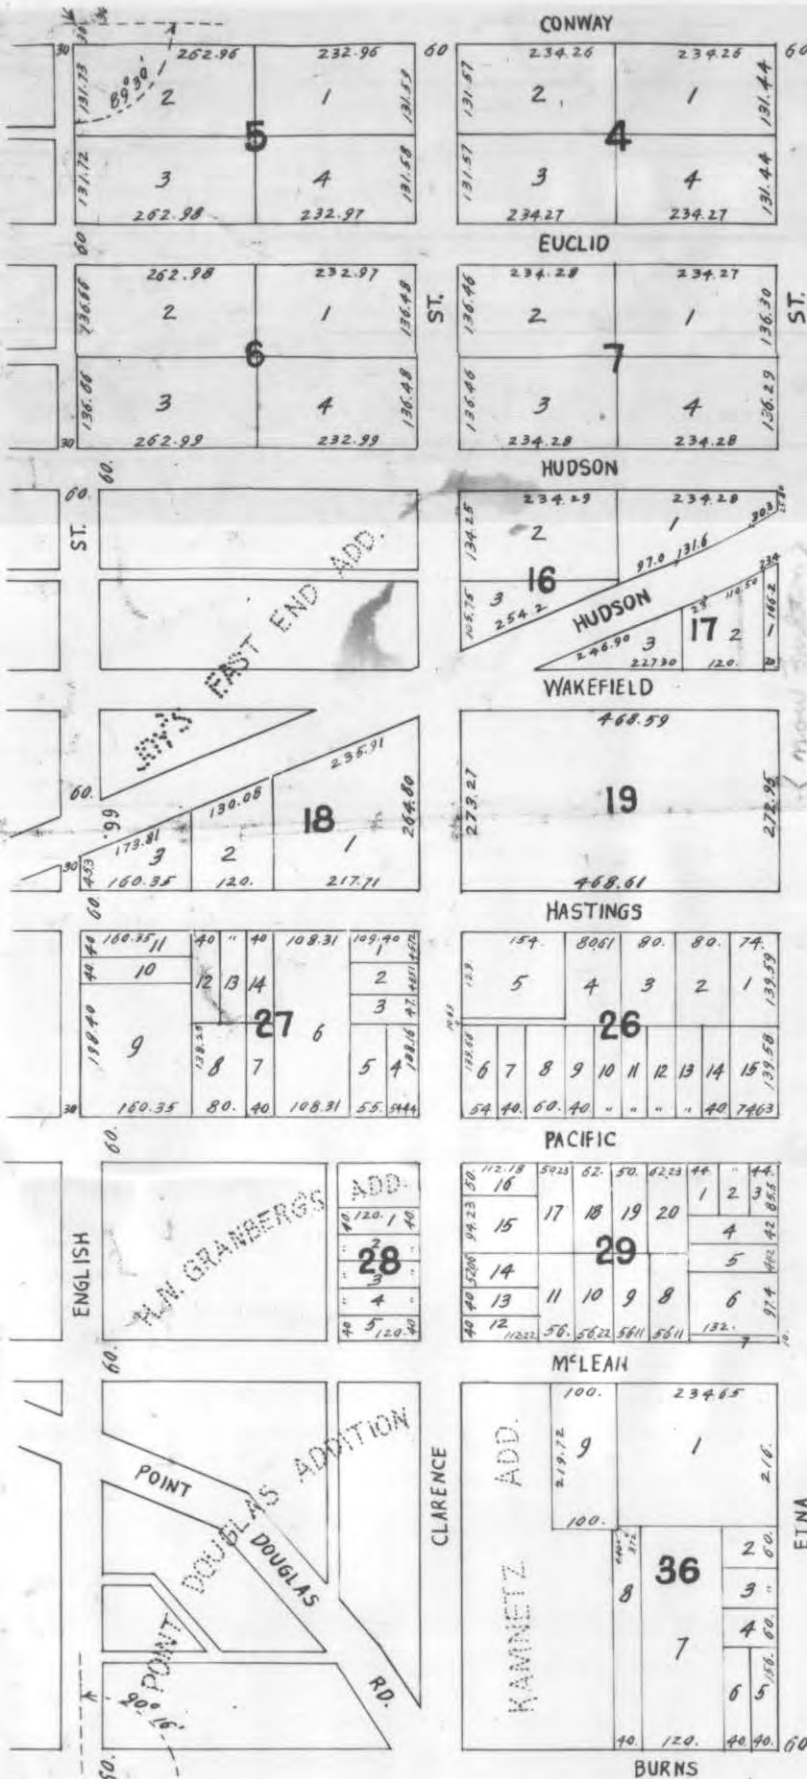

#6433