

MACKUBIN AND MARSHALL'S


SURVEY OF

LOTS 21 AND 22 BL 24

DEC 8-1907

VENS PEDERSEN
SURV.

- 911 -

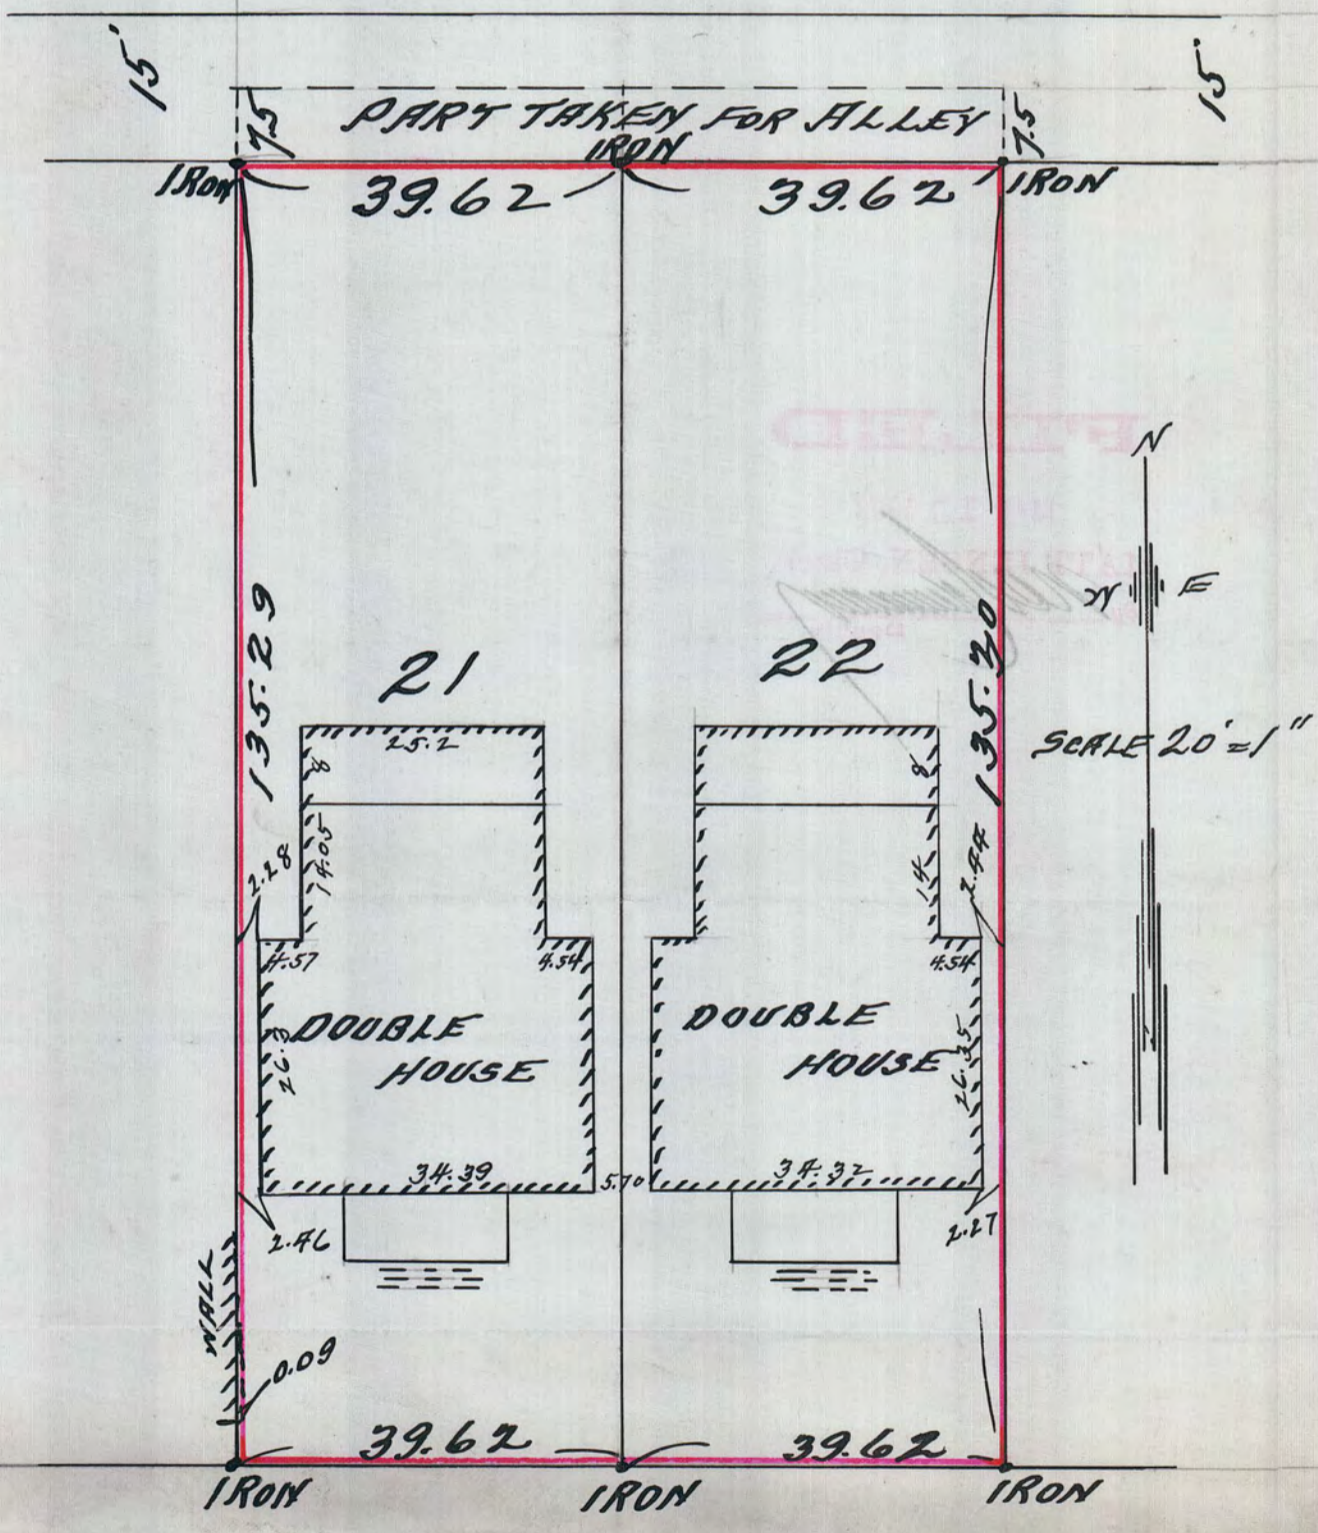

66'

CARROLL

AVE.

66'

#649