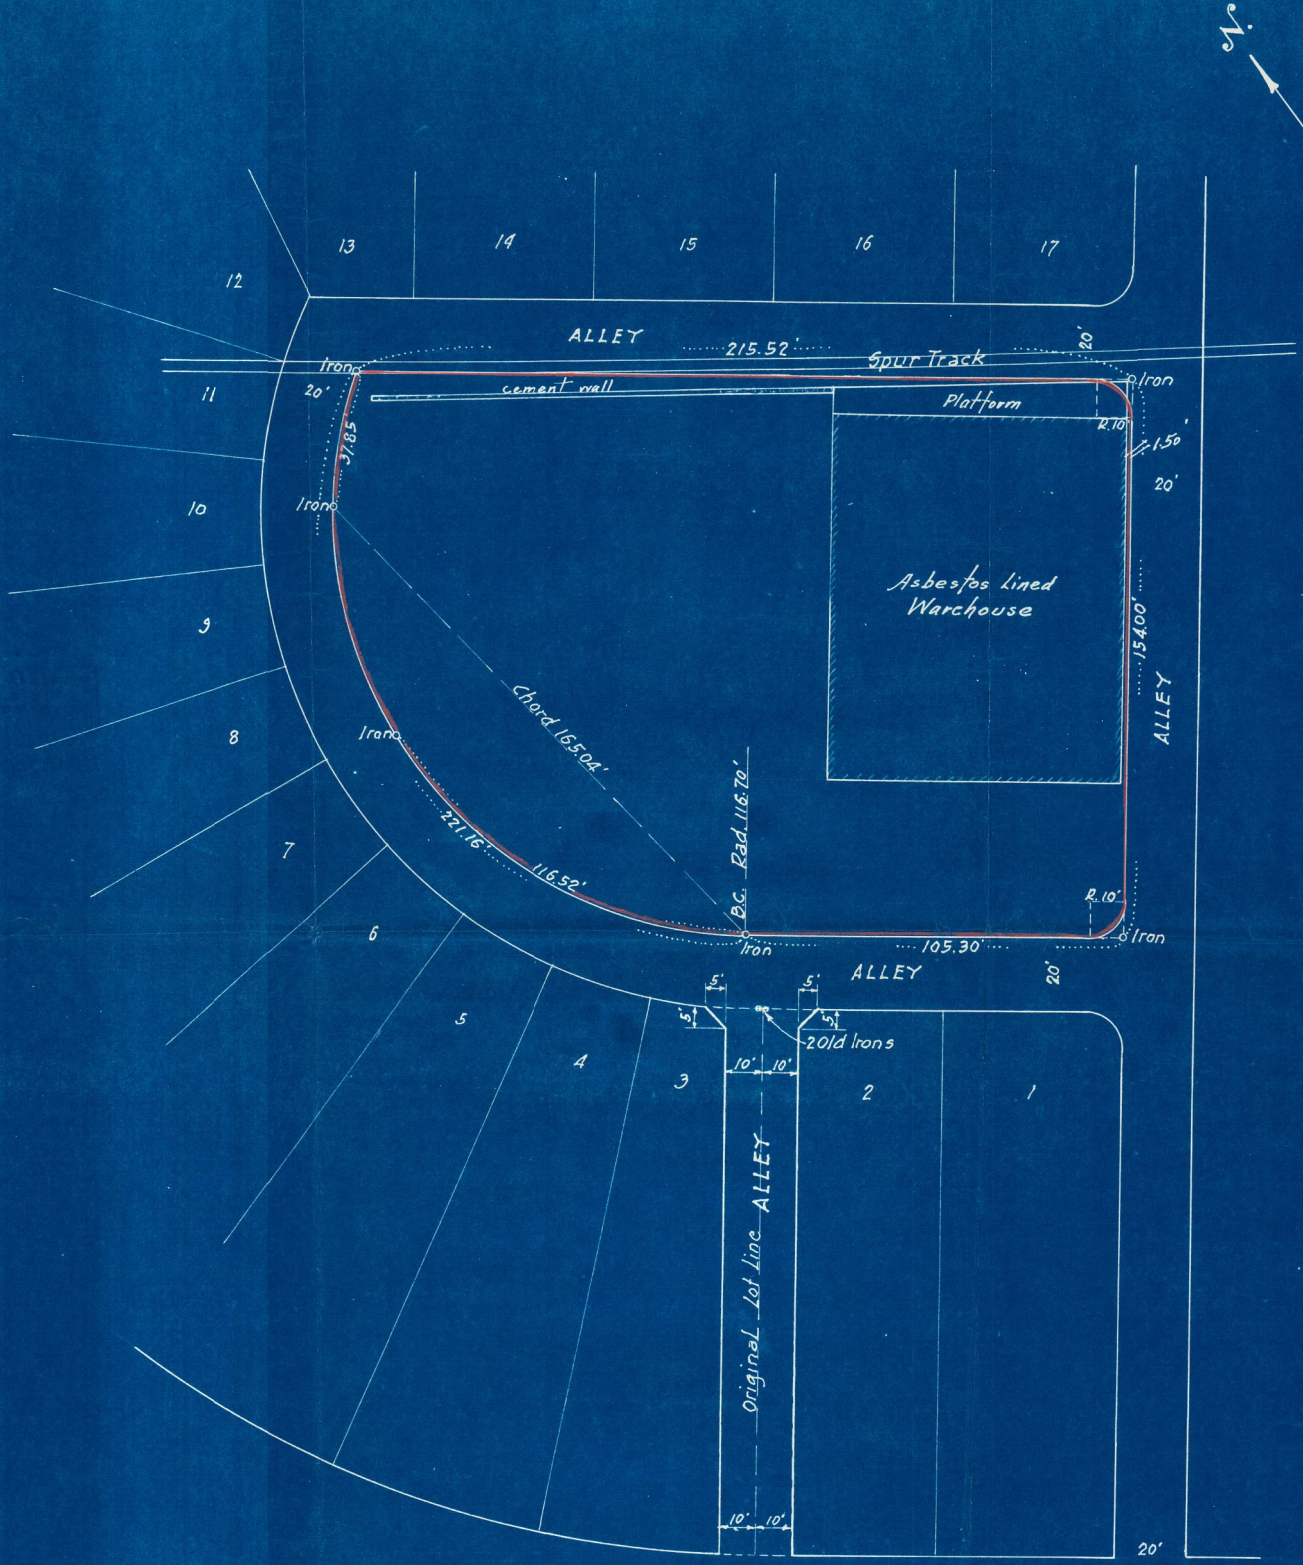

...tify that this map correctly
...the part enclosed by Alley in
...t. Anthony Park' according to the
...at thereof, as surveyed by me this
...ecember 1948; and the G.A. MacArthur Co.
...ilding shown on said part, and there
...achments except as indicated.
F.J. Bruesthorg. Civil Engr.

...nd Sworn to before me this 15th day of December 1948
...Notary Public, Ramsey County, Minn.
...on Expires Oct. 29, 1949

For G.A. Mac Arthur Co.

MAP OF SURVEY OF
PART OF BLOCK 69, ST. ANTHONY PARK
ST. PAUL, MINN.
Scale 1" = 30' Oct. 1, 1947.

F.J. Bruesthorg. Civil Eng...

#6497