


# CERTIFICATE of SURVEY

F. J. ARMSTRONG  
Civil Engineer and Surveyor  
ST. PAUL, MINN.

E. SIXTH ST.

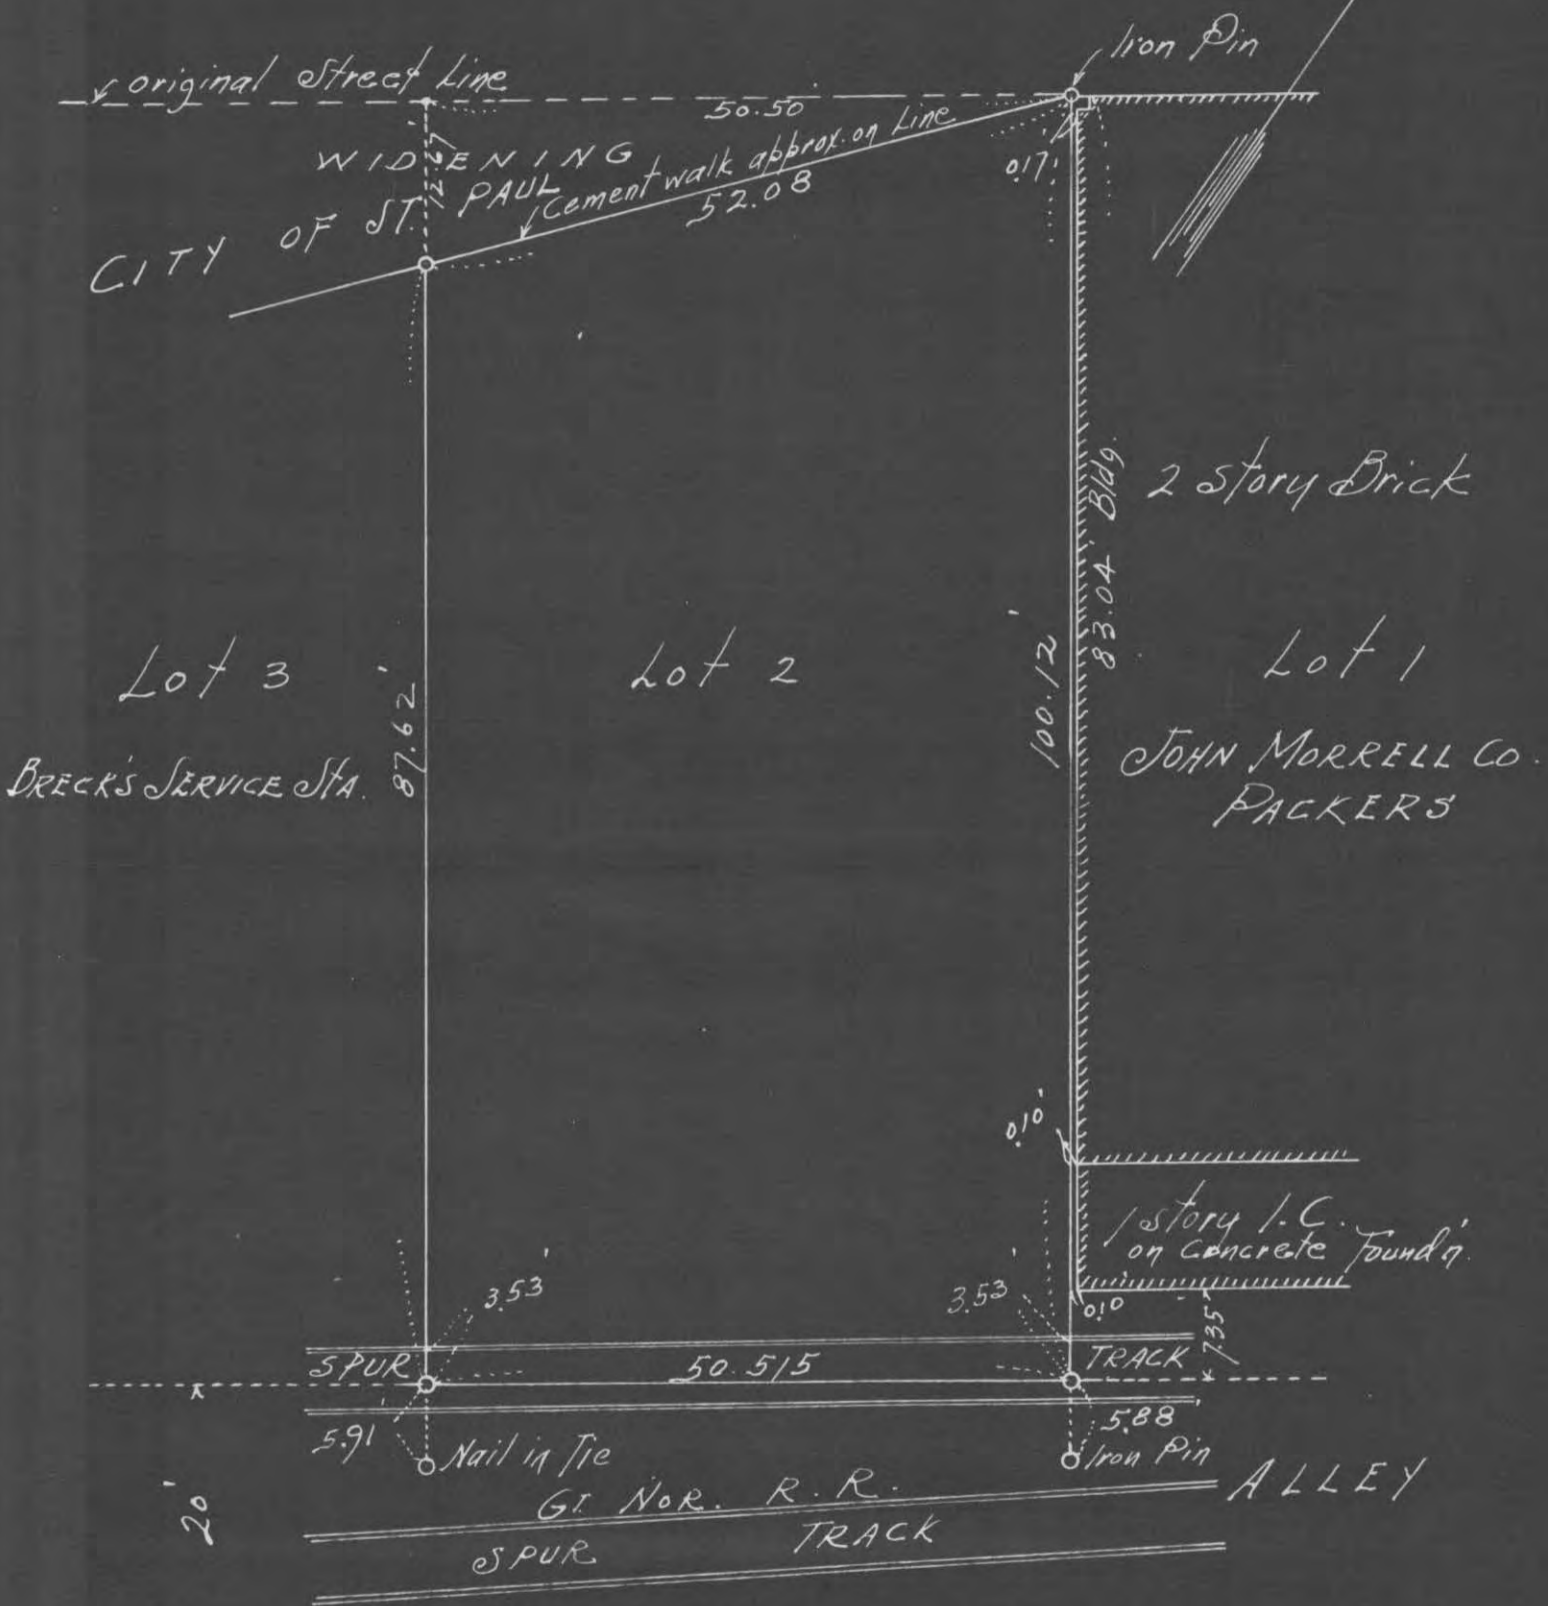

Scale 15 feet per inch

I HEREBY CERTIFY that on the 26<sup>th</sup> day of July, A. D. 1949

I made a survey of the following described property, to-wit: Lot Two (2) Block Forty-Four (44) Kittson's Addition to St. Paul except part conveyed to the City of St. Paul in 722 Deeds page 621 and the map hereon shown is a true and correct map of said survey and that the improvements thereon indicated are correctly shown.

Subscribed and sworn to before me this 25<sup>th</sup> day of July, 1949  
*Harold G. Beach*  
 Notary Public.

My Commission Expires Oct 29, 1949

*F. J. Armstrong* Civil Engineer.

#6670