


SCALE: 1 INCH 30 FEET

PLAT OF SURVEY

6674

OF PROPERTY OF _____

DESCRIBED AS FOLLOWS The Westerly fifty (50) ft. of lot 12, and the
Westerly fourty (40) ft. of lots 13 and 14, Block 10,
Roberts and Randalls Addition to St. Paul Minn.

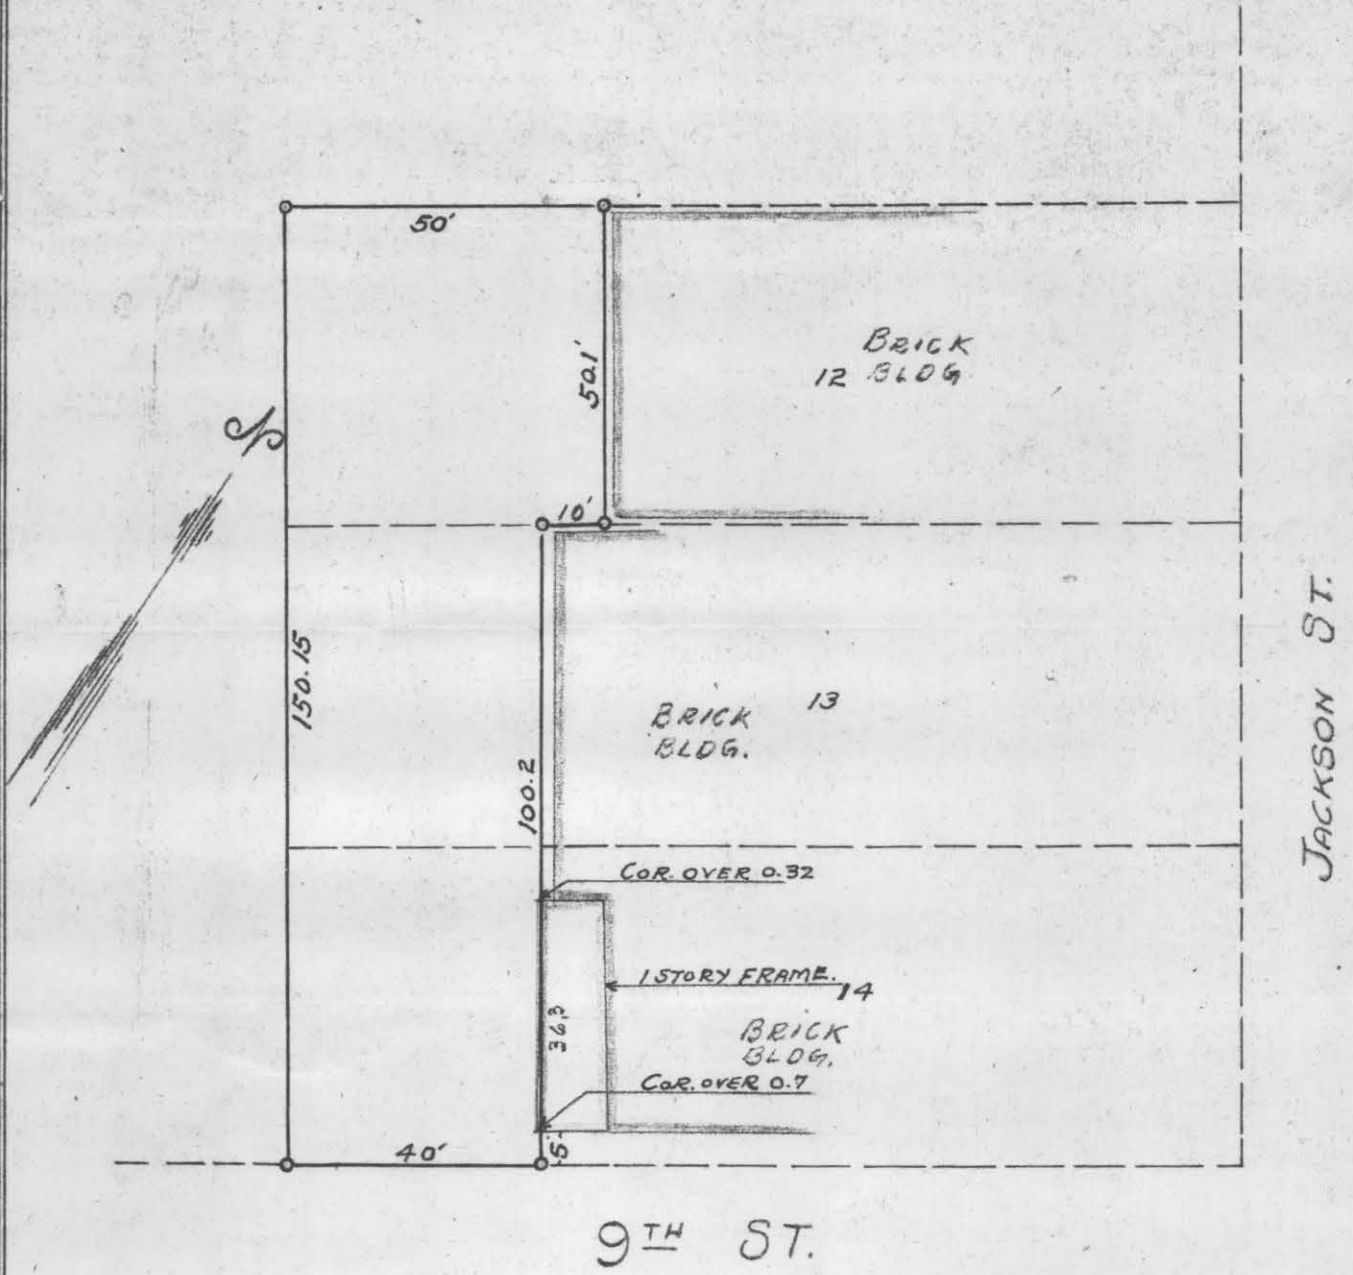

CERTIFICATE OF LOCATION OF BUILDING

I hereby certify that on _____ 19____
I made a survey of the location of the building(s) on the above
described property and that the location of said building(s)
is correctly shown on the above plat.

Don. O. Weber

CERTIFICATE OF SURVEY

I hereby certify that on AUG. 13TH 19 49
I surveyed the property described above and that the above
plat is a correct representation of said survey.

Don O. Weber

REGISTERED SURVEYOR, NO. 665

#6674