


# CERTIFICATE OF SURVEY

F. J. ARMSTRONG  
Civil Engineer and Surveyor  
ST. PAUL, MINN.

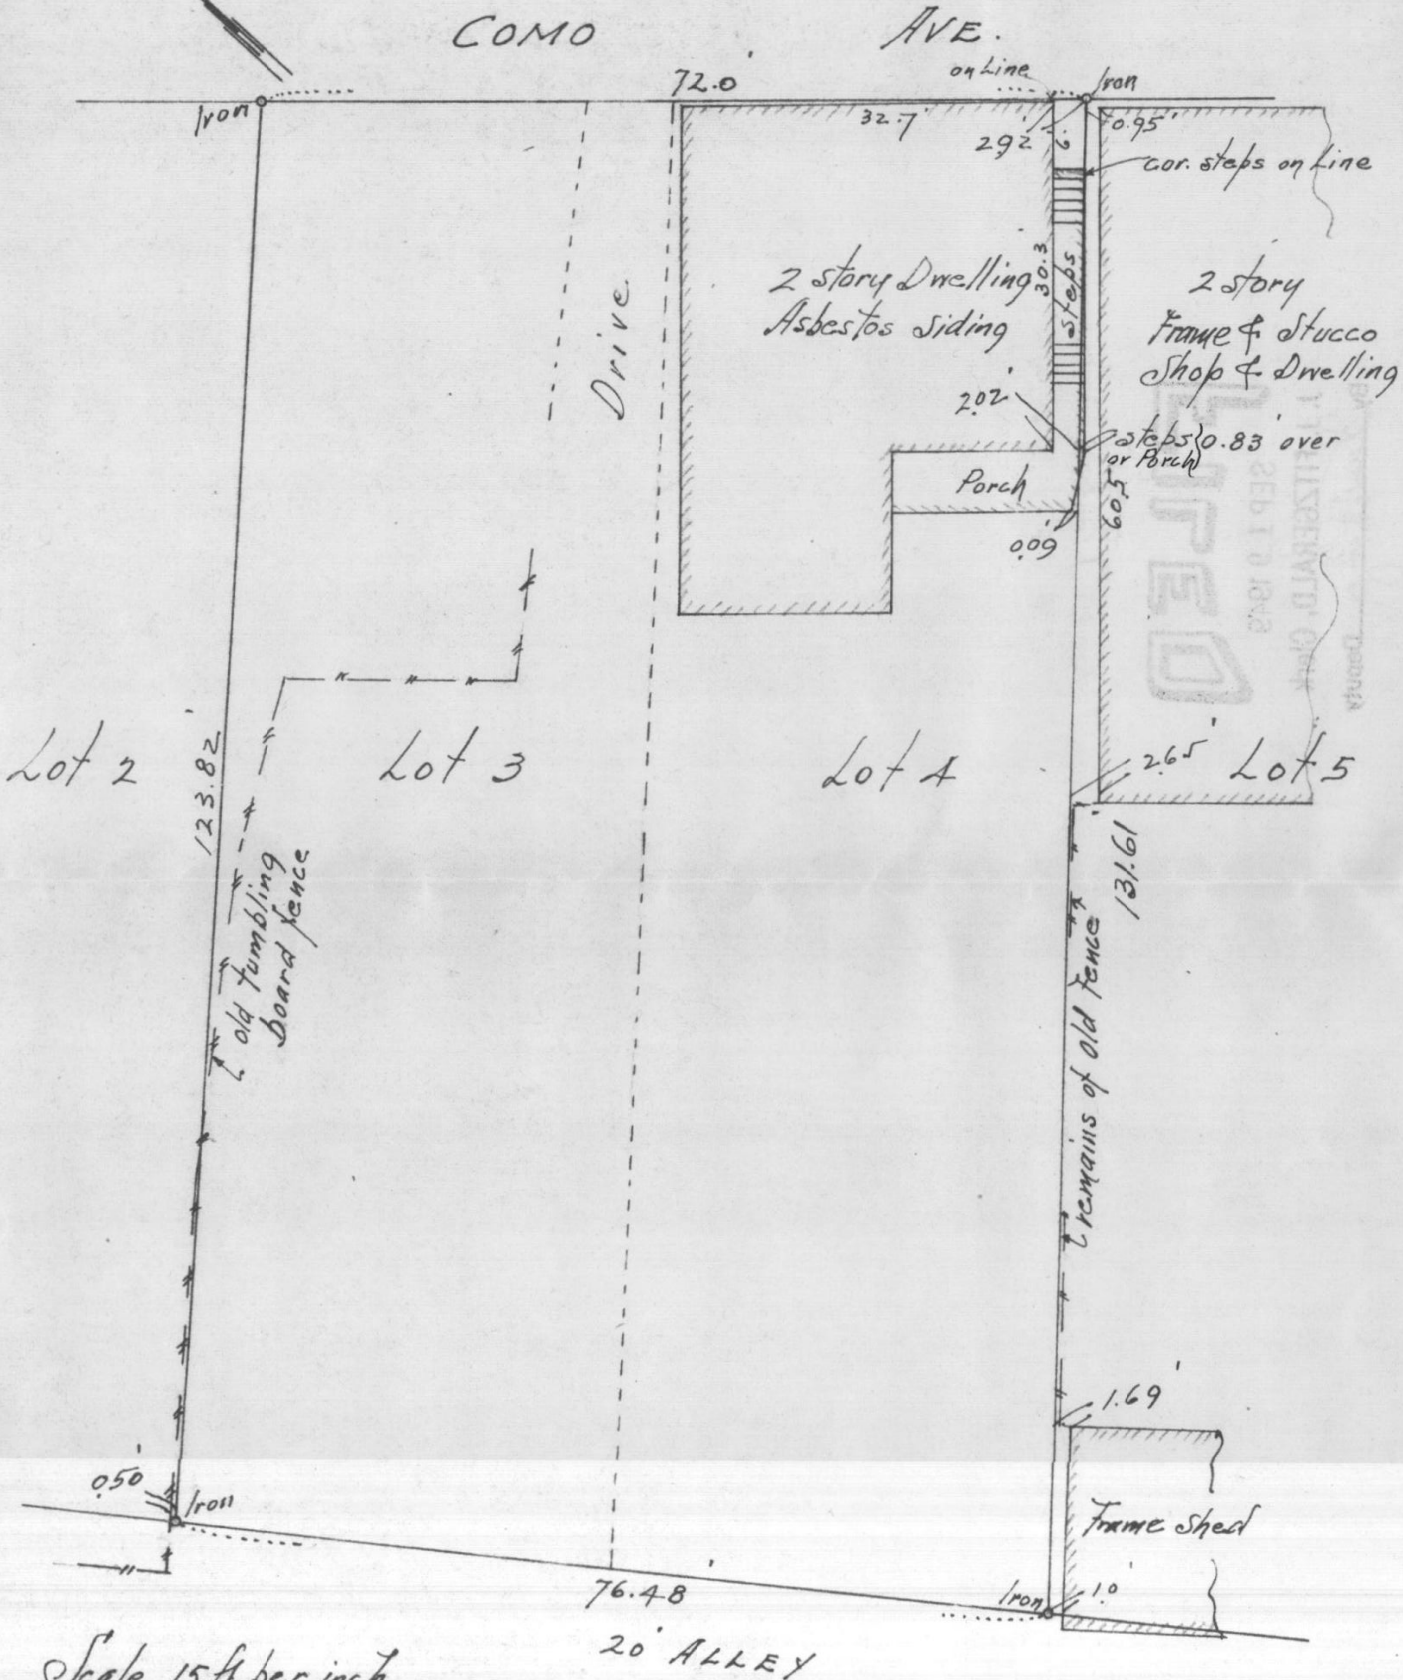

Scale 15 ft. per inch

I HEREBY CERTIFY that on the 8<sup>th</sup> day of September, A. D. 1949

I made a survey of the following described property, to-wit: Lots 3 and 4  
Block 2 Neurers Addition  
St. Paul, Minn.

and the map hereon shown is a true and correct map of said survey and that the improvements thereon indicated are correctly shown and there are no encroachments except as indicated

Subscribed and sworn to before me this  
12<sup>th</sup> day of Sept, 1949  
Lorena G. Bach  
Notary Public.