


CERTIFICATE of SURVEY

F. J. ARMSTRONG
Civil Engineer and Surveyor
ST. PAUL, MINN.

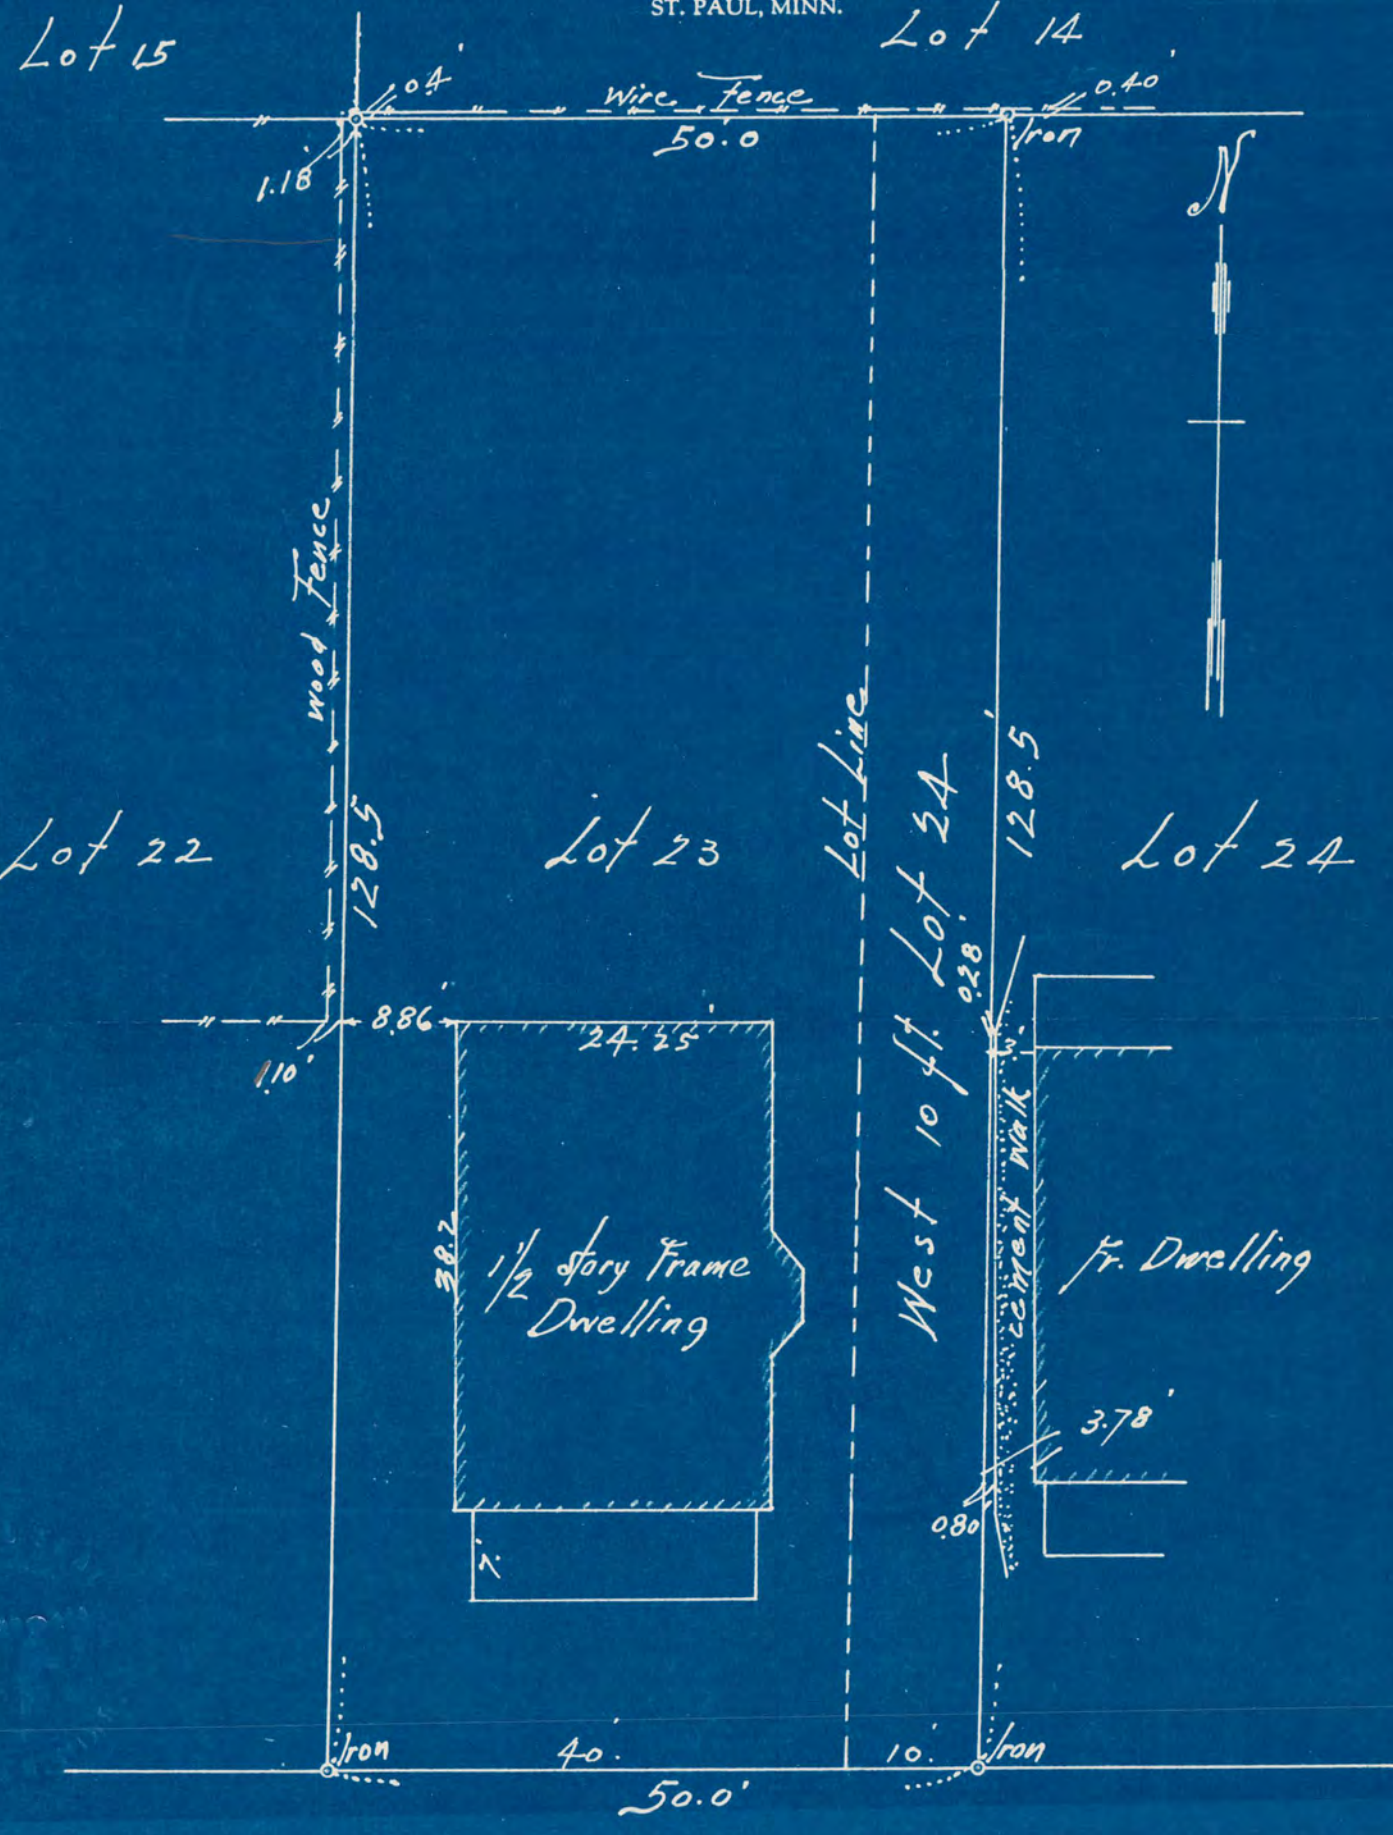

COMO AVE. W.

Scale 15 ft. per inch

I HEREBY CERTIFY that on the 6th day of April, A. D. 1951
I made a survey of the following described property, to-wit: Lot 23 and the West 10 feet of Lot 24 S. G. Harris Addition St. Paul, Minn.

Subscribed and sworn to before me this 28 day of MAY, 1951
George W. Armstrong
Notary Public.
My Commission Expires March 25, 1953

and the map hereon shown is a true and correct map of said survey and that the improvements thereon indicated are correctly shown.
F. J. Armstrong Civil Engineer.

#6689