


Court File 6750

CERTIFICATE of SURVEY

F. J. ARMSTRONG
Civil Engineer and Surveyor
ST. PAUL, MINN.

20 FT. ALLEY

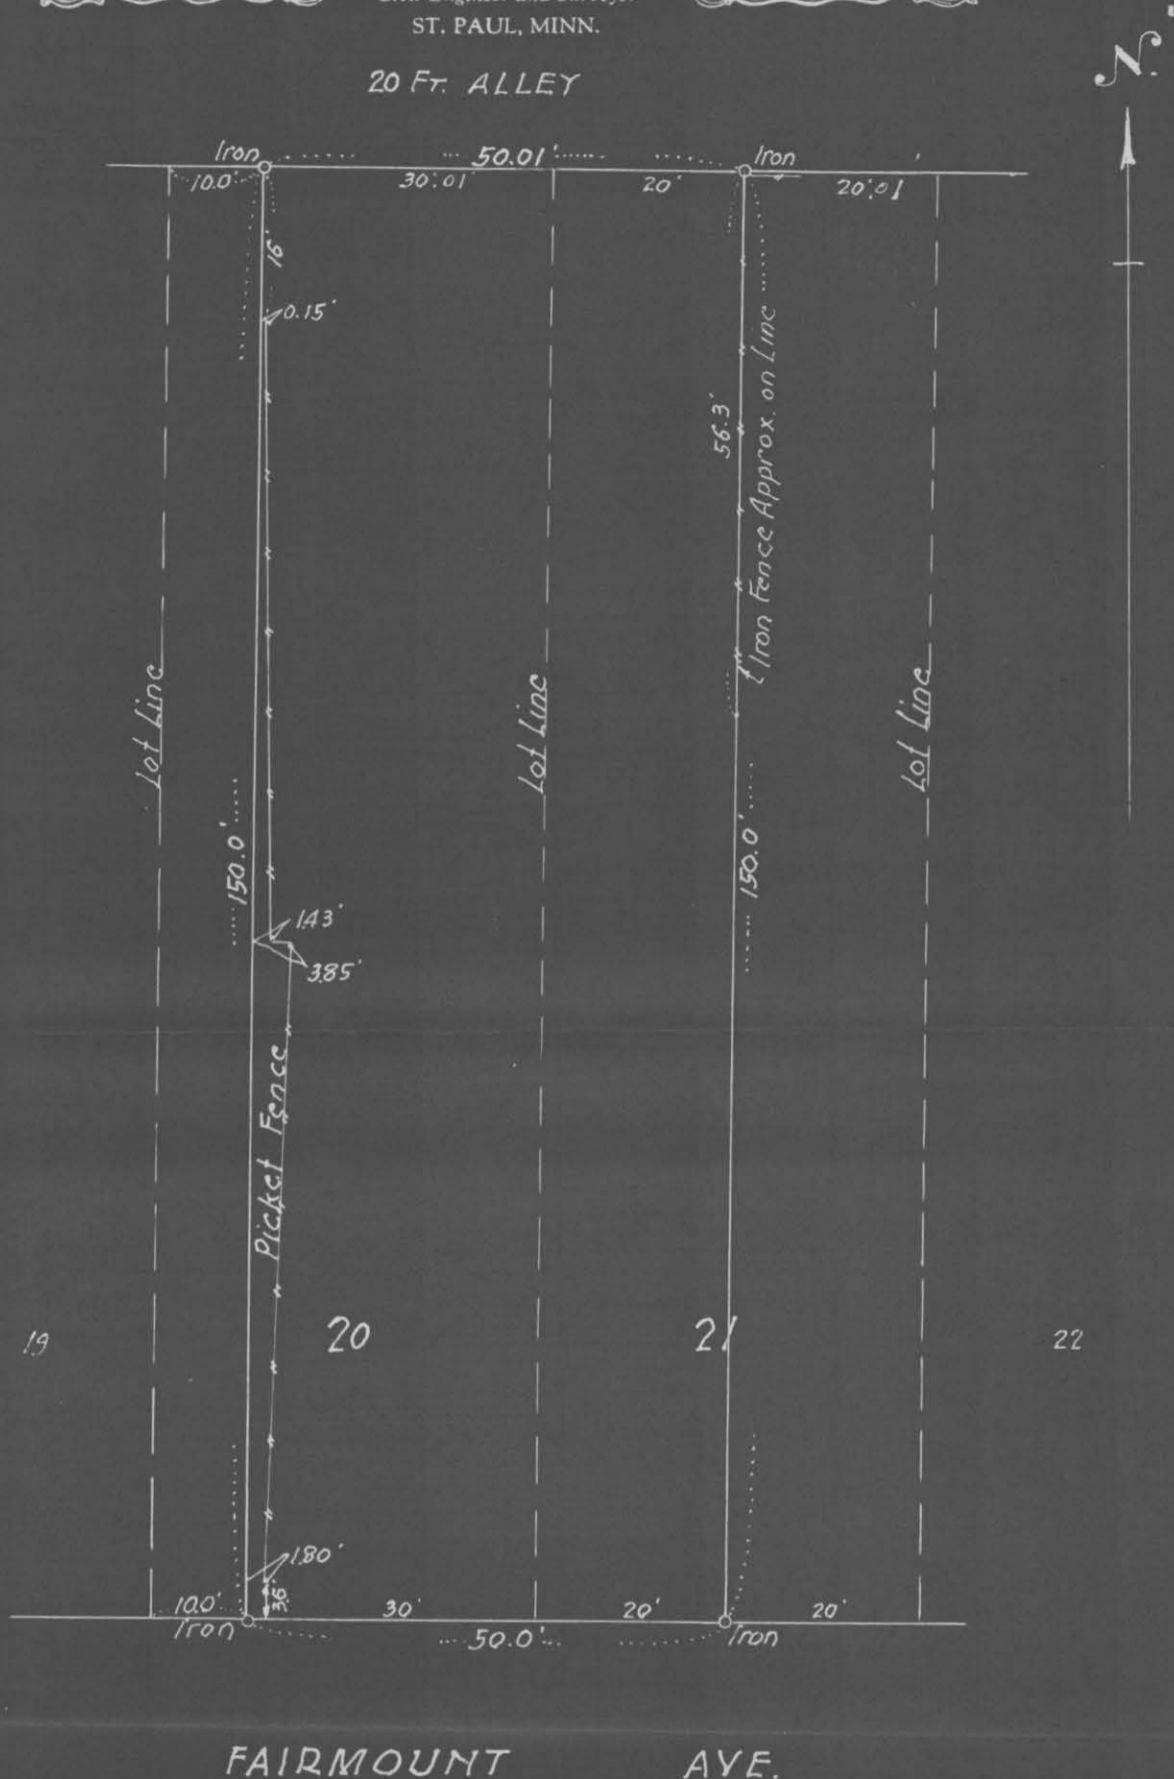

FAIRMOUNT AVE.

Scale 1" = 20'

I HEREBY CERTIFY that on the 12th day of May, A. D. 191949

I made a survey of the following described property, to-wit: West 20 Ft. of Lot 21 and Lot 20 except the West 10 Ft.; Block 15 Summit Park, St. Paul, Minn.

and the map hereon shown is a true and correct map of said survey and that the improvements thereon indicated are correctly shown.

F. J. Armstrong Civil Engineer.

Subscribed and sworn to before me this 12th day of May, 1949
Lorena C. Bach
Notary Public.

My Commission Expires 10-29-56

#6750