

**EMIL H. SCHULZ**

Registered Professional Engineer and Land Surveyor No. 93  
951 Wakefield Avenue

Tower 4024

Dated October 24, 1949.

St. Paul 6, Minnesota


SCALE 1 INCH = ~~100~~ <sup>30</sup> FEET

● Indicates Iron Monument.

□ Indicates Stone Monument.

**PLAT OF SURVEY**

*Lot 3, E. C. Long's Rearrangement of Part of Block 6, College  
Place Taylors Division.*

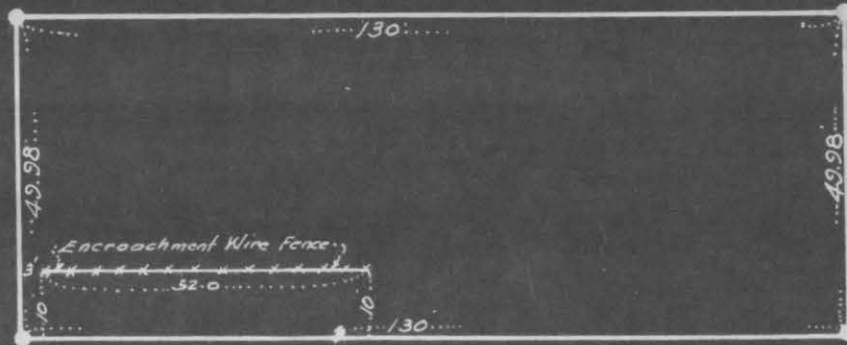

*SMELLING AVE. No.*

*Emil H. Schulz*

Emil H. Schulz

# 6760