

PLAT OF SURVEY

BY
R. C. WOLFGRAM, REGISTERED LAND SURVEYOR
ST. PAUL, MINNESOTA

Surveyed Feb., 16, 1950.

I hereby certify that this is a true and correct plat of a survey of the land shown and described hereon, and that monuments or markers indicated hereon have been placed as shown, and that any improvements or physical conditions indicated hereon are as shown.

Plat Scale - 1 in = 20 ft.

● Indicates Iron Mont.

R. C. Wolfgram

Description:—
Lot 4, Block 5, Brunson's Addition to the Town of St. Paul.



6773

ABSTRACT OF TITLE

MADE BY OFFICIAL OFFICE OF RAMSEY COUNTY


TO

No. 1

Lot 4, Block 5, Brunson's Addition to the Town of St. Paul in
the County of Ramsey and Territory of Minnesota

Premises described in caption are located in the SE 1/4 of NW 1/4
of Section Number 32 Township Number 29 North of
Range Number 22 West of the Fourth Principal Meridian.

SECTION

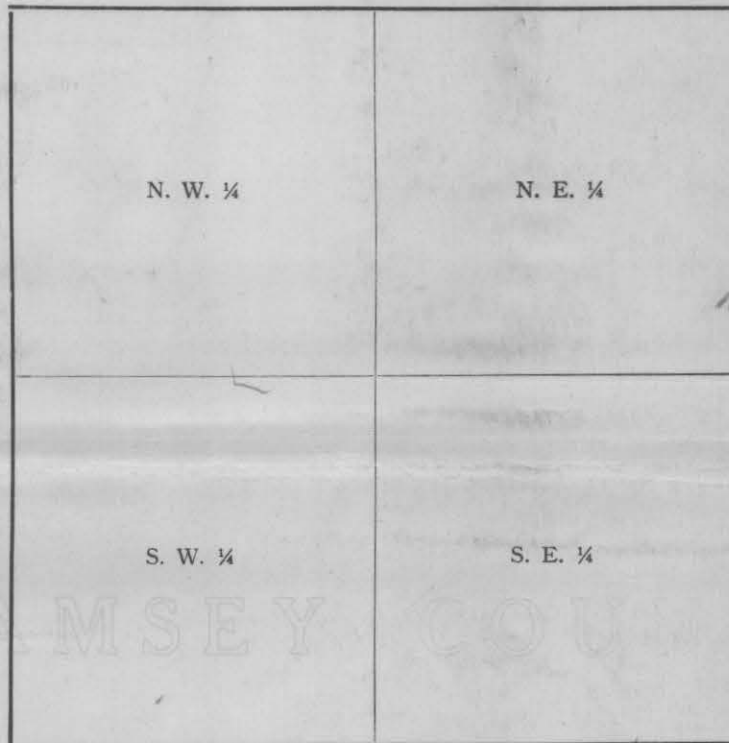

No. 2

Old Time Surveyor's Measure.

7 $\frac{92}{100}$ inches make 1 Link.

100 Links, or 66 feet, 1 Chain.

3 feet, 1 Yard.

5 $\frac{1}{2}$ yards or 16 $\frac{1}{2}$ feet, 1 Rod or Pole.

4 Rods, 1 Chain.

80 Chains (5,280) 1 Mile.

No. 3

RAMSEY COUNTY
MINNESOTA

1058490

6773