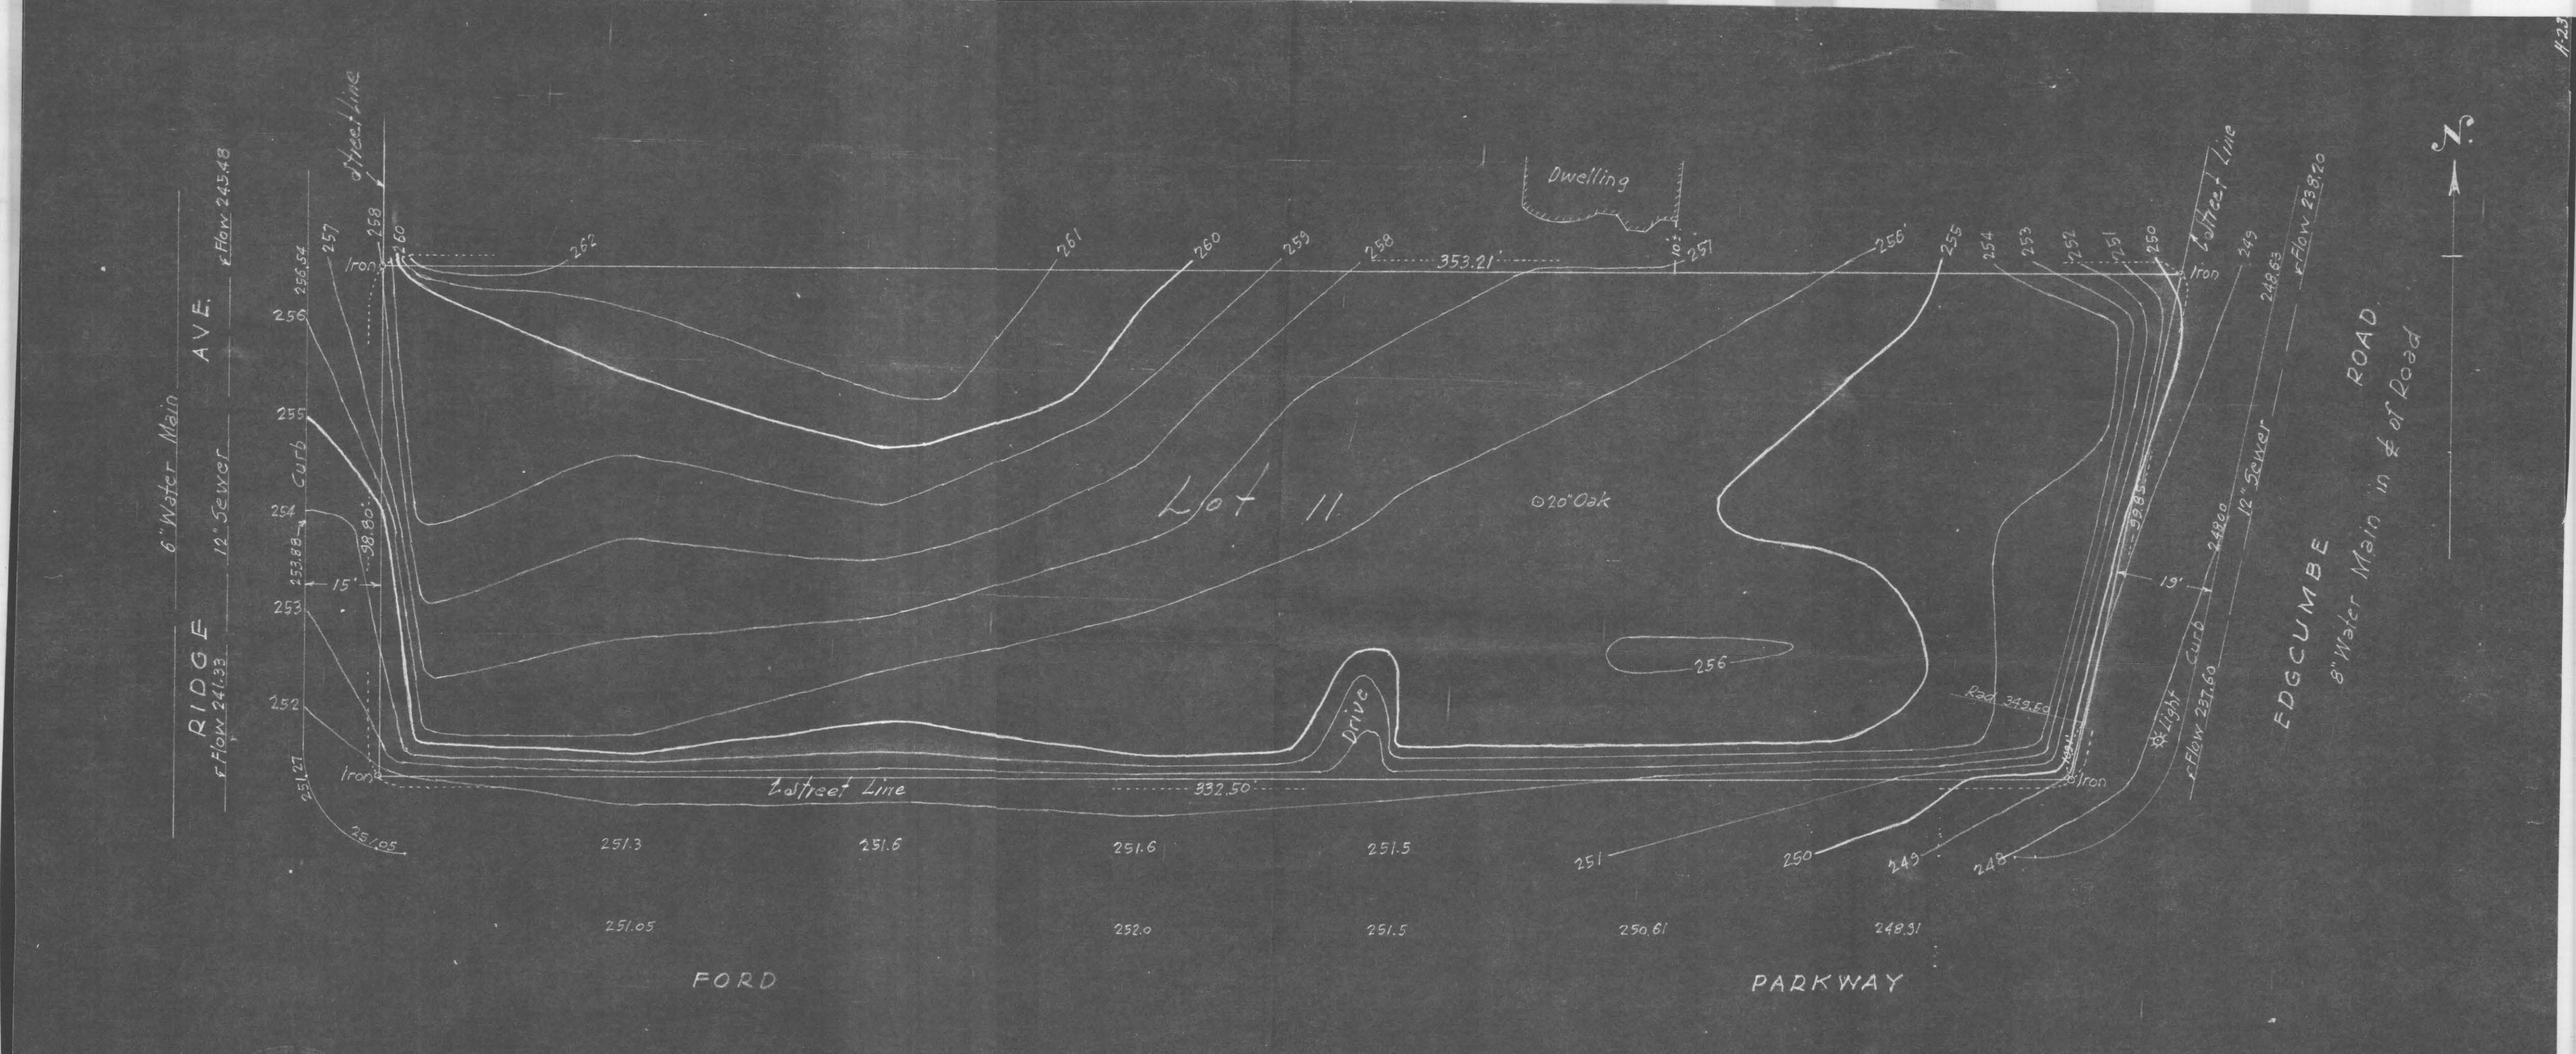

Subscribed and sworn to before me this 5th day of April A.D. 1950

Lorena C. Bank
Notary Public, Ramsey Co. Minn

My Commission Expires Oct 29 1956

I hereby certify that this map correctly represents Lot 11 Block 9 West End Edgcumbe, as surveyed by me April 5th 1950, and there are no encroachments onto said property.

Dated This 5th day of April 1950

F. J. Armstrong. Civil Engr.

MAP OF SURVEY AND LEVELS
LOT 11 BL. 9 WEST END EDGCUMBE
ST. PAUL, MINN.

Scale 1" = 20' April 5th 1950

F. J. Armstrong. Civil Engr.

#6823