


CERTIFICATE of SURVEY

F. J. ARMSTRONG
Civil Engineer and Surveyor
ST. PAUL, MINN.

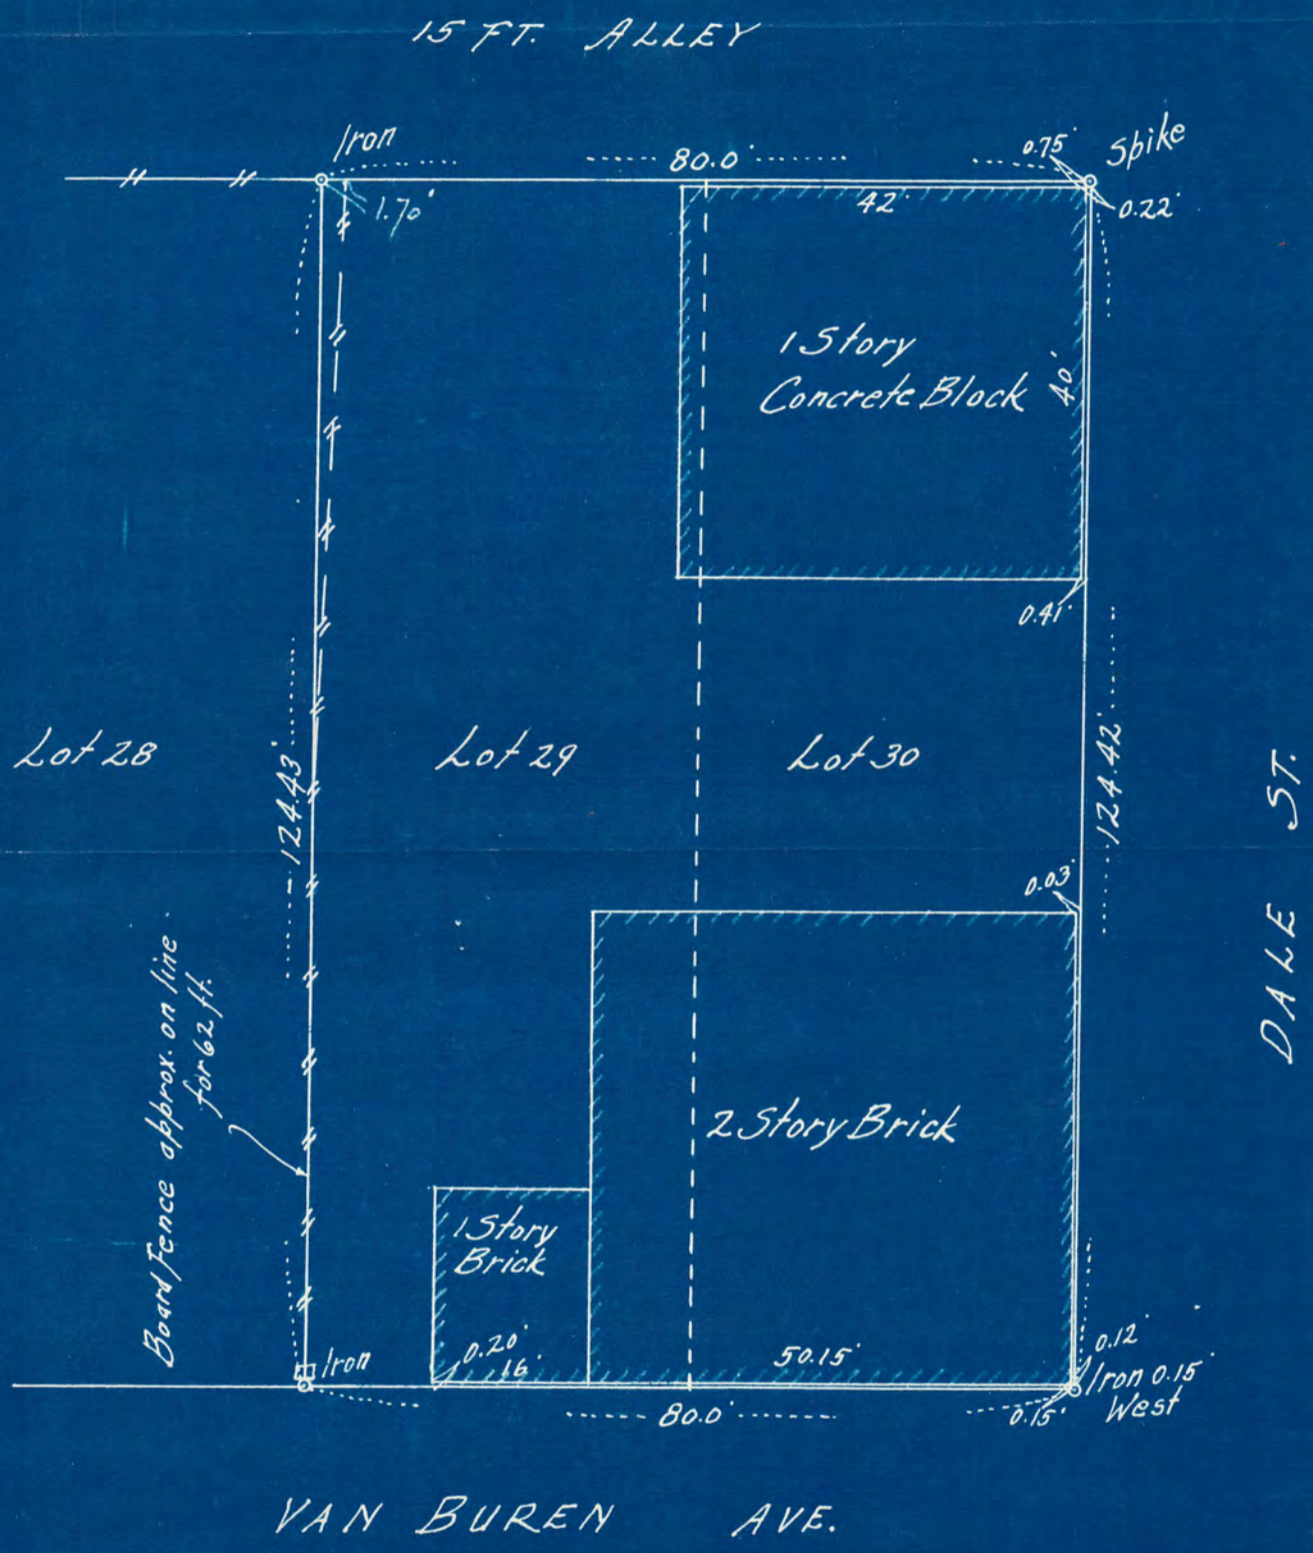

Scale: 20 ft. per inch

I HEREBY CERTIFY that on the 9th day of May, A. D. 1950
 I made a survey of the following described property, to-wit: Lots 29 & 30 Block 1
Syndicate No 4 Add.
St. Paul, Minnesota
 and the map hereon shown is a true and correct map of said survey and that the improvements thereon indicated are correctly shown.

F. J. Armstrong Civil Engineer.

Subscribed and sworn to before me this
 _____ day of _____, 19____

 Notary Public.
 My Commission Expires _____

6847