


# CERTIFICATE of SURVEY

F. J. ARMSTRONG  
Civil Engineer and Surveyor  
ST. PAUL, MINN.

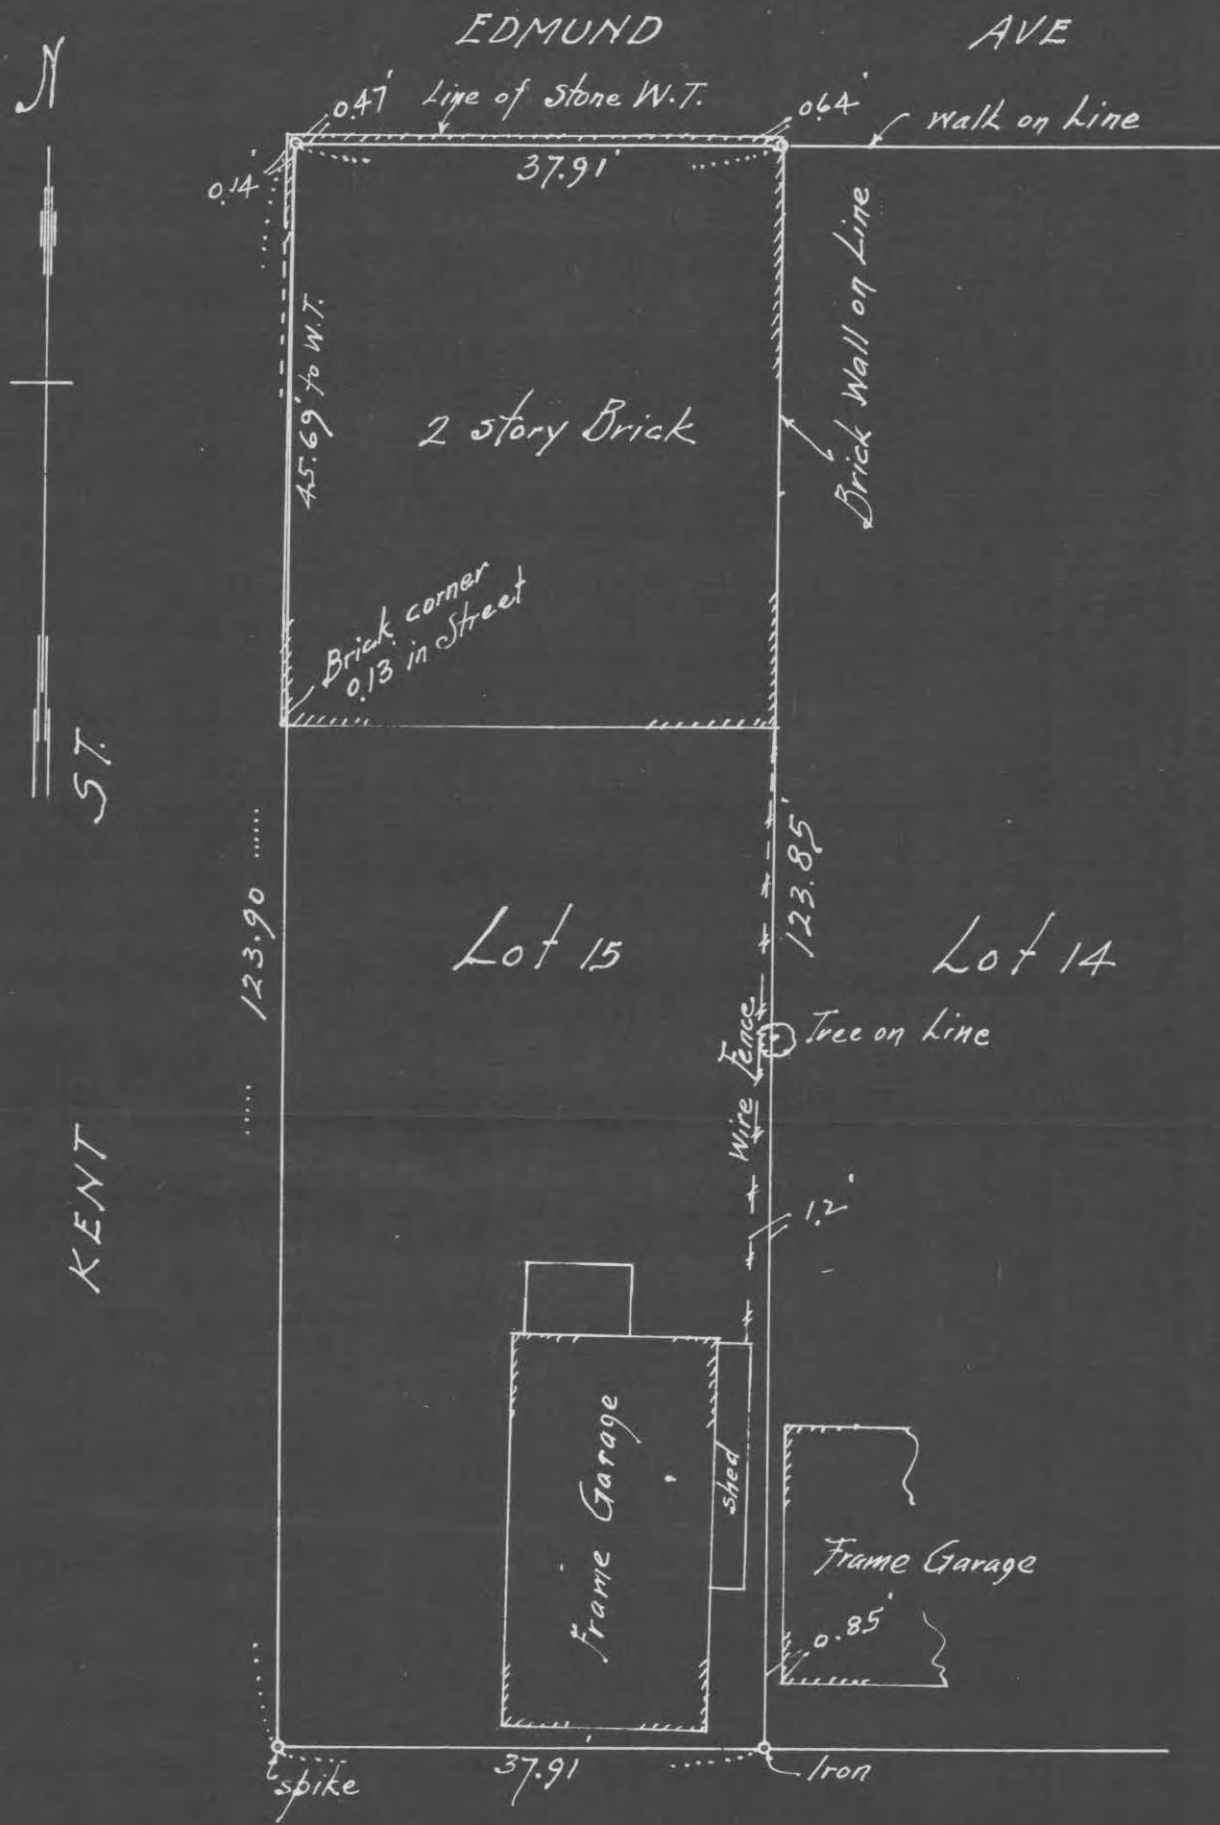

Scale 1.5 ft. per inch

I HEREBY CERTIFY that on the 1st day of May, A. D. 1950

I made a survey of the following described property, to-wit: Lot 15 Block 2  
H. M. Ranney's Sub. of Block 11 Stinson's Division

Subscribed and sworn to before me this  
..... day of ....., 19.....

Notary Public.

and the map hereon shown is a true and correct map of said survey and that the improvements thereon indicated are correctly shown.....

My Commission Expires.....

*F. J. Armstrong* Civil Engineer.

#6848