


# CERTIFICATE of SURVEY

F. J. ARMSTRONG  
Civil Engineer and Surveyor  
ST. PAUL, MINN.

Scale 20 ft. per inch

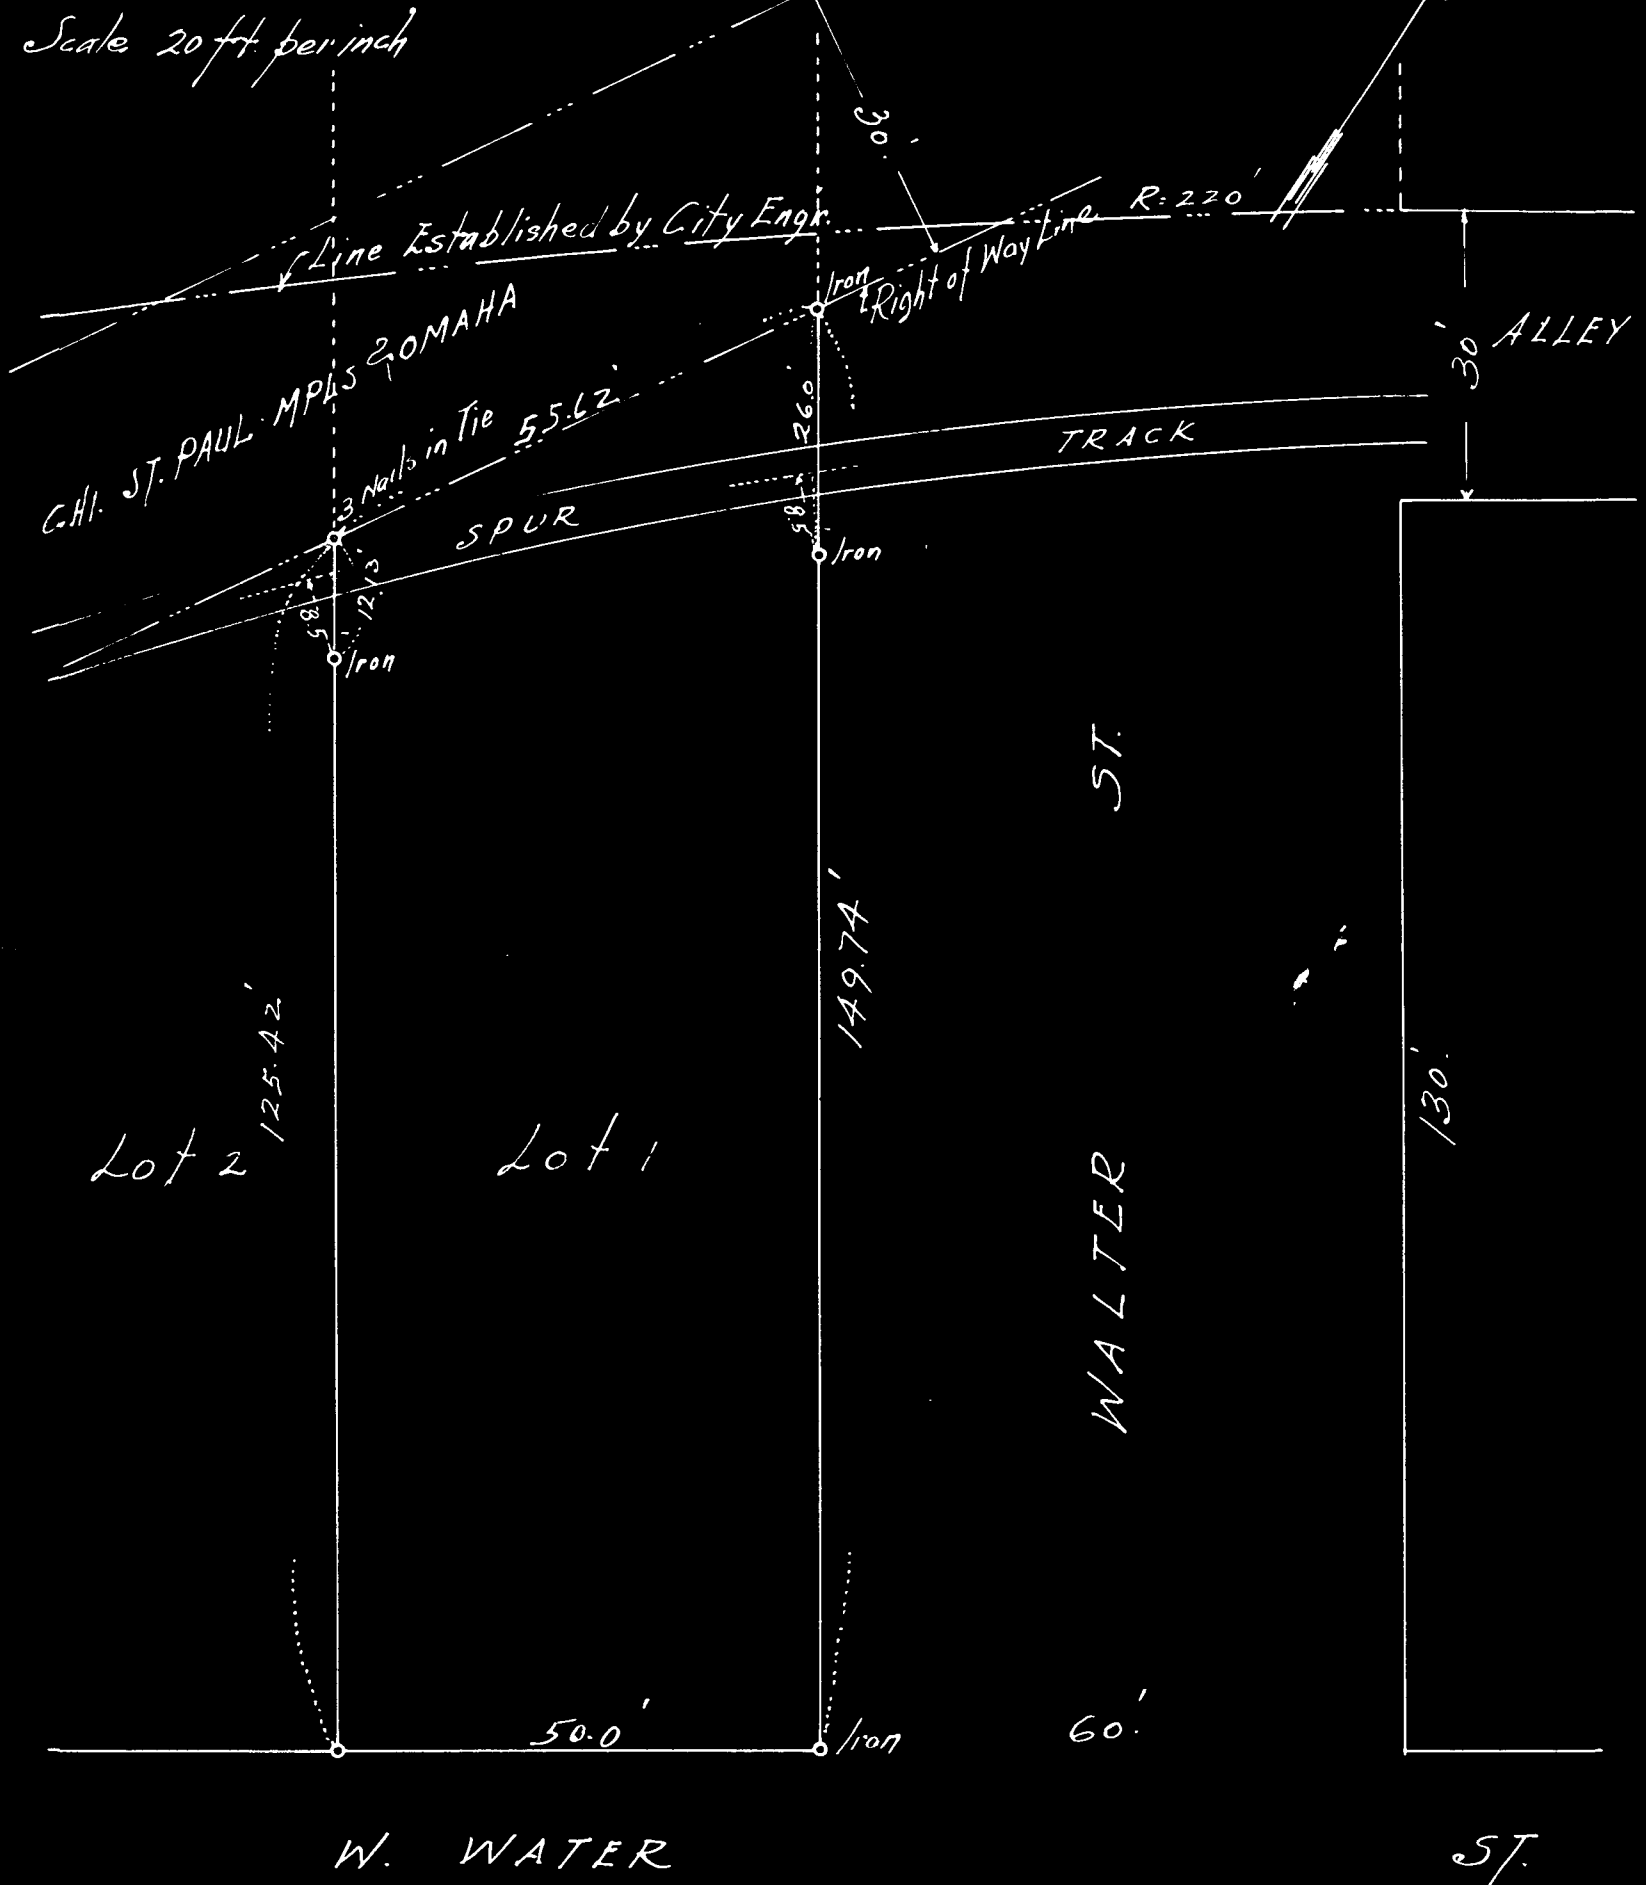

W. WATER

ST.

I HEREBY CERTIFY that on the 13<sup>th</sup> day of July, A. D. 1950

I made a survey of the following described property, to-wit: All that part of Lot 1 Block 188 Robertson's Addition to West St. Paul lying southerly of the Chi-St. Paul Mpls & Omaha R.R. Right of Way.

and the map hereon shown is a true and correct map of said survey and that the improvements thereon indicated are correctly shown and there are no encroachments.

Subscribed and sworn to before me this  
..... day of..... 19.....

Notary Public.

My Commission Expires.....

*F. J. Armstrong* Civil Engineer.

#6882