

PLAT OF SURVEY

DESCRIPTION - The West 25 feet of the East 75 feet of Lots 4 & 5 and the South 1/2 of the West 25 feet of the East 75 feet of Lot 3, Block 107 West St Paul Proper


SCALE 1 INCH = 20 FEET

O INDICATES IRON.

W. F. BRETTSCHEIDER - REG. SURVEYOR

1160 CHARLES AVE. ST. PAUL, MINN.

TEL. DA. 5304

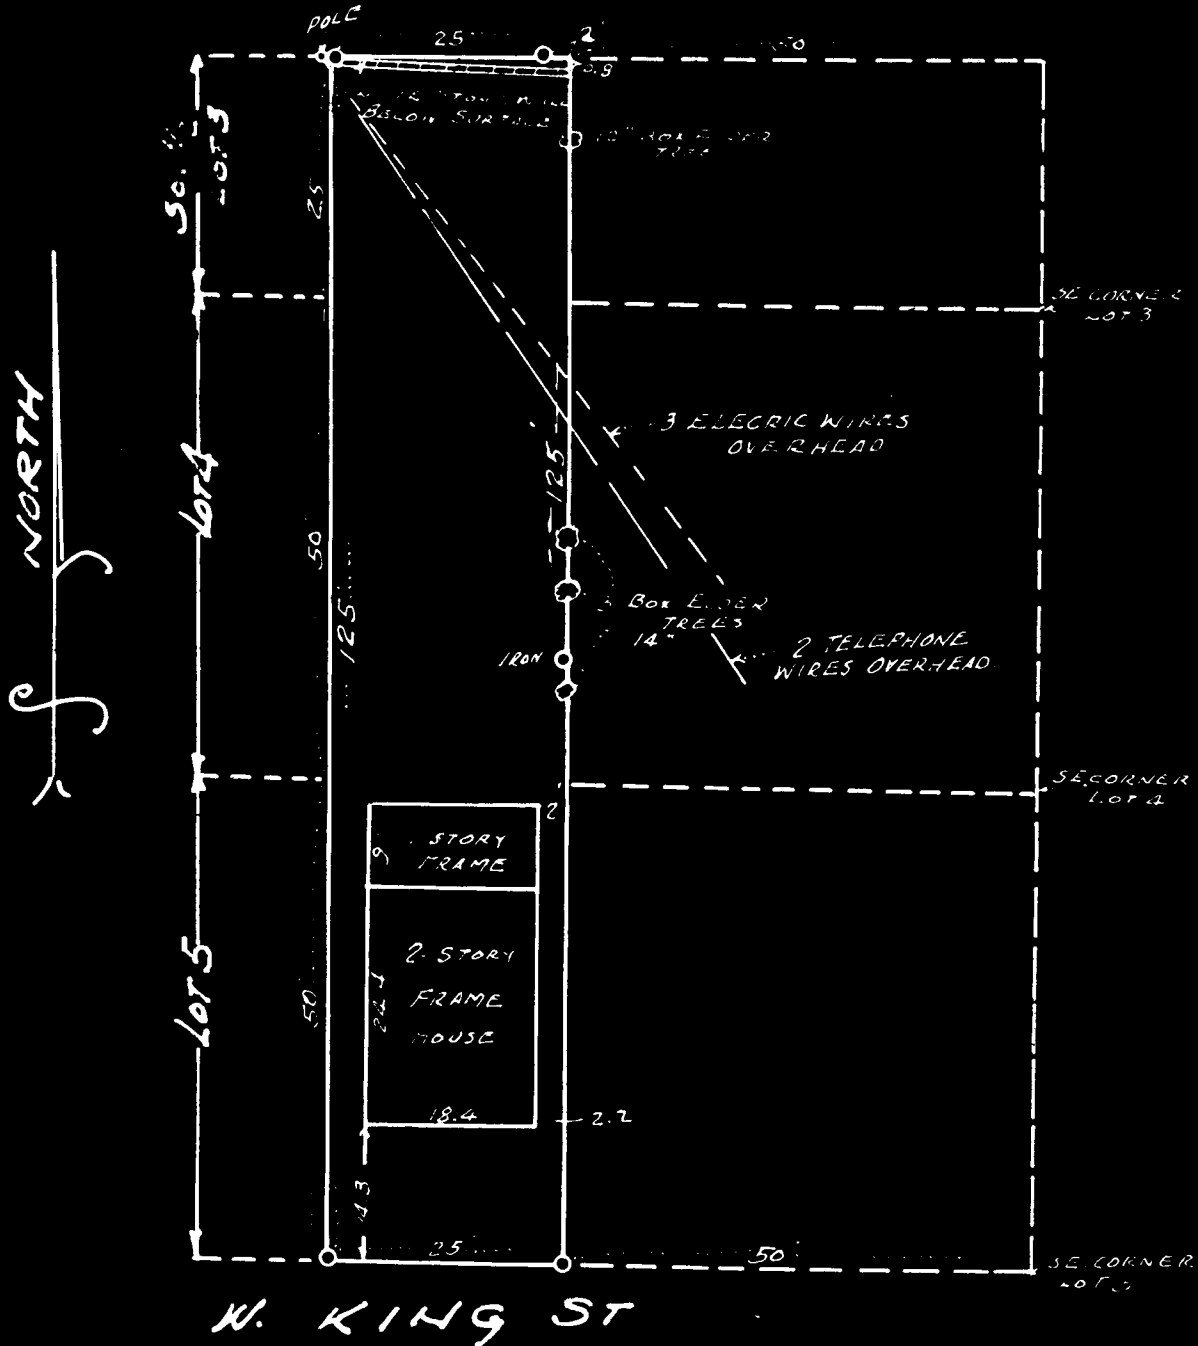

NOTE
THERE ARE NO ENCROACHMENTS
ON THE ABOVE DESCRIBED PROPERTY
EXCEPT AS SHOWN.

CERTIFICATE OF SURVEY

I hereby certify that on JULY 3 1957
I surveyed the property described above and that the same is
justly claimed by the person(s) named above.

W. F. Brett Schneider

#6895