PLAT OF SURVEY

o Indicates Iron
Scale 1" = 50'

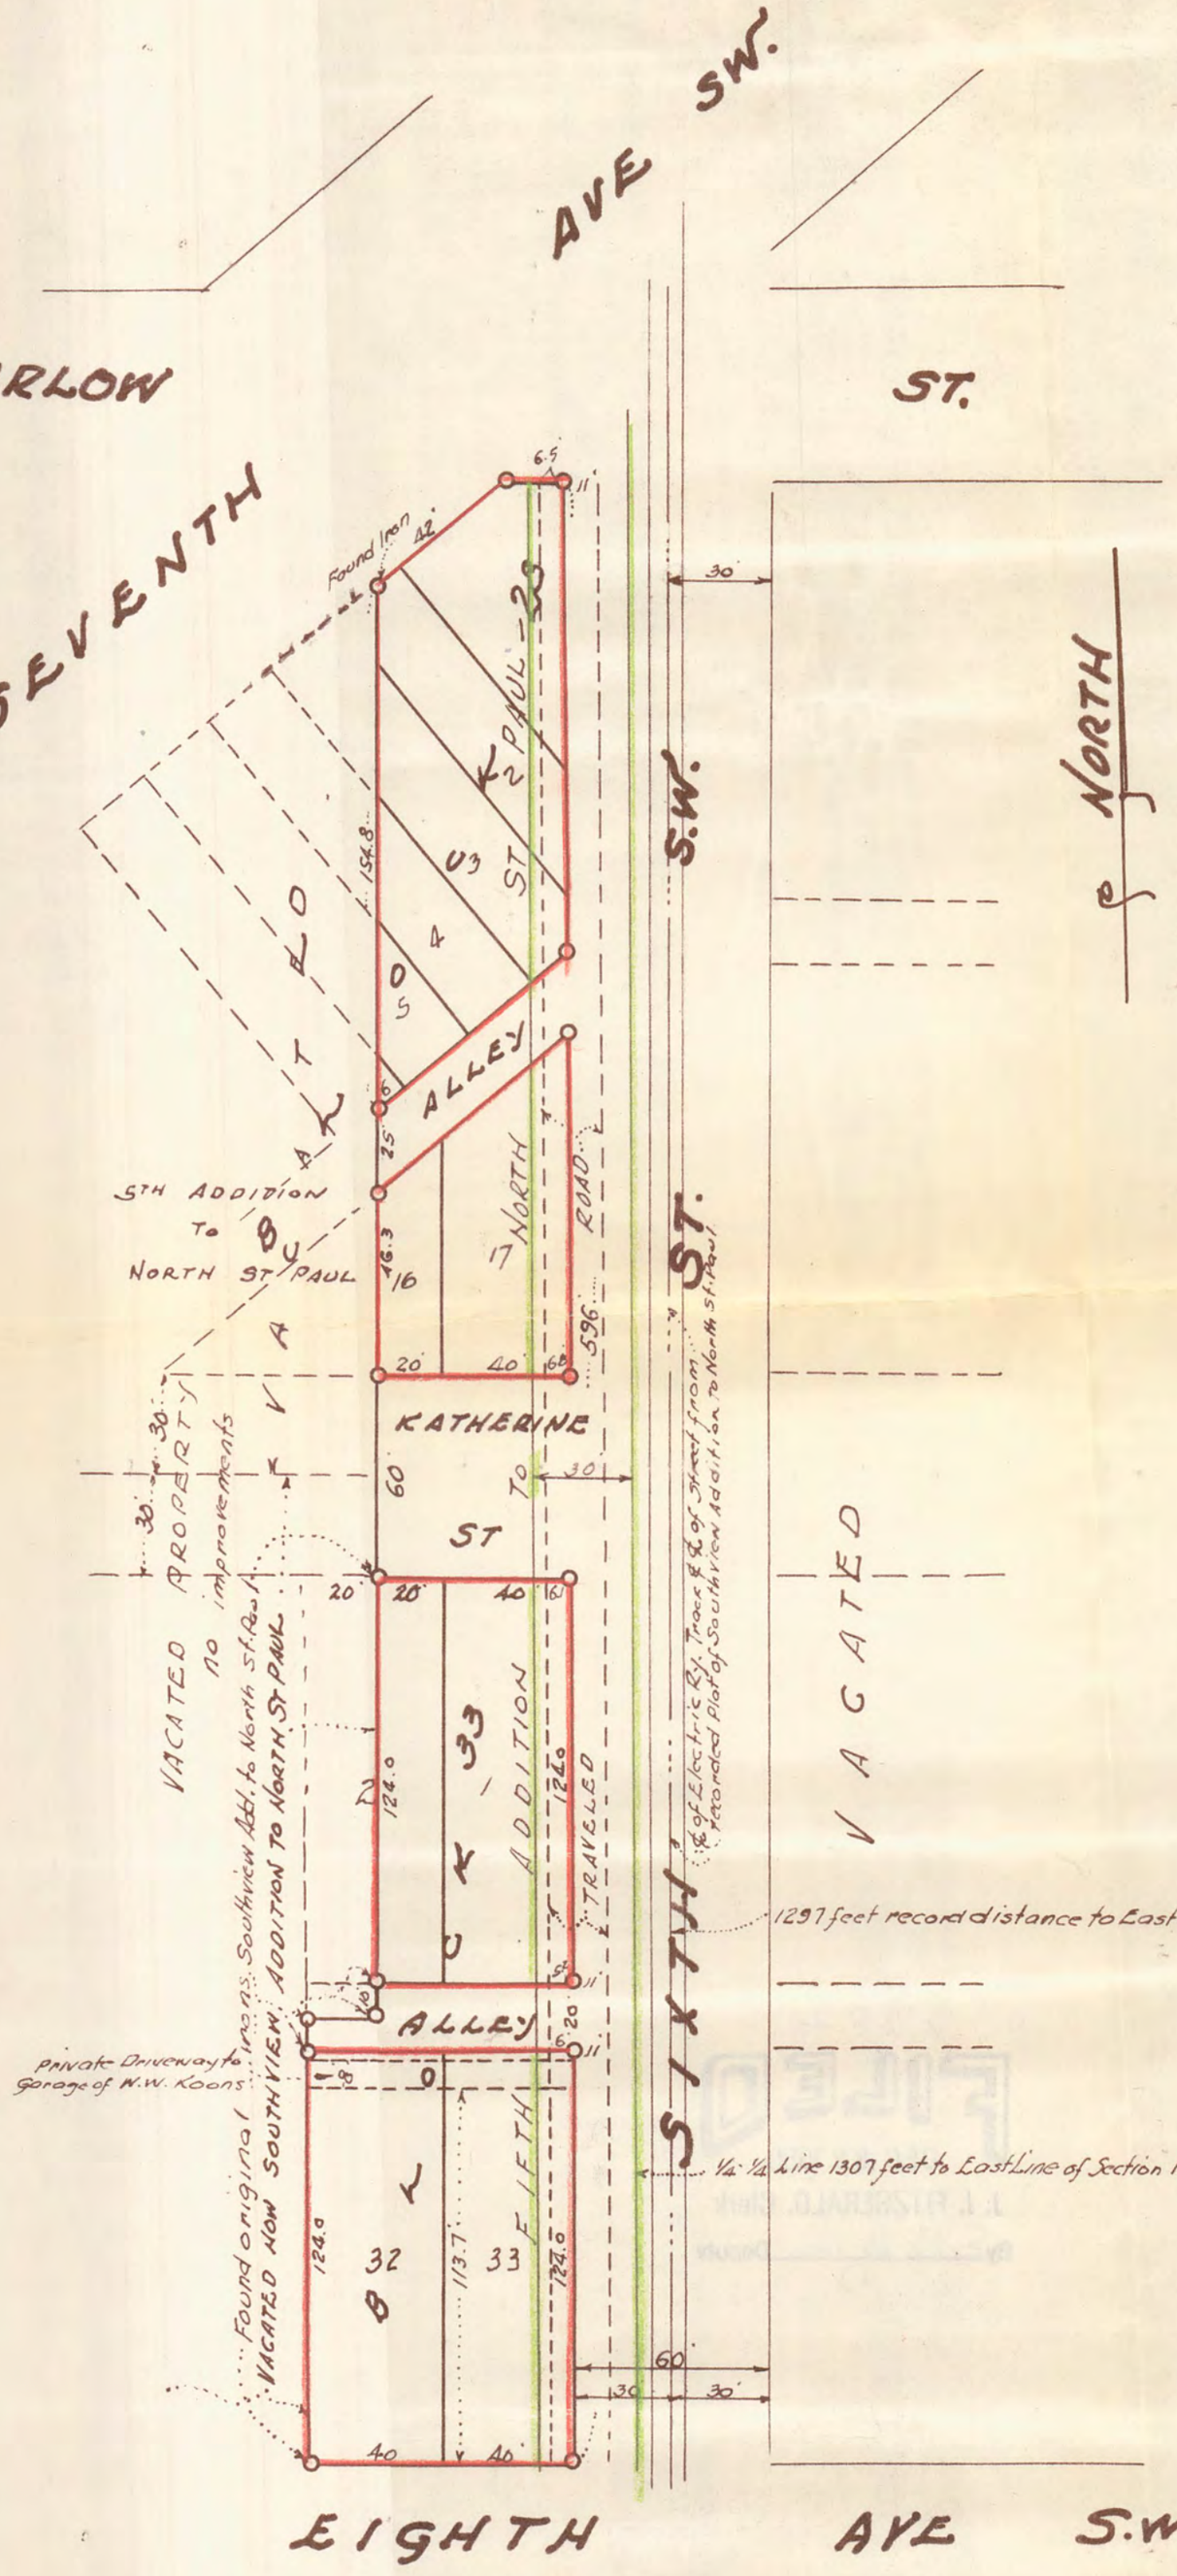

State of Minnesota }
County of Ramsey } S.S.

T.J. Welch being duly sworn despose and says that he is a duly registered and practicing surveyor in the City of St. Paul and County of Ramsey, Minnesota, that on July 8, 1950, he made a survey of the East 1/2 of Lot 2 and all of Lots 1-32 & 33, Block 33, and Lot 1, Block 28, and that part of Lots 2-3-4-5 & 6 in the East 60 feet of Block 28 also Lot 17 & the East 20 feet of Lot 16, Block 28 all in Fifth Addition to North St. Paul. There are no encroachments on the above described property except as shown.

T. J. Welch

Subscribed and sworn to before me this 20th day of November 1950

Raymond J. Cockriel

Notary Public Ramsey County, Minn.
My commission expires. April 15 1952

April 15-1952.

#6902.