


6940

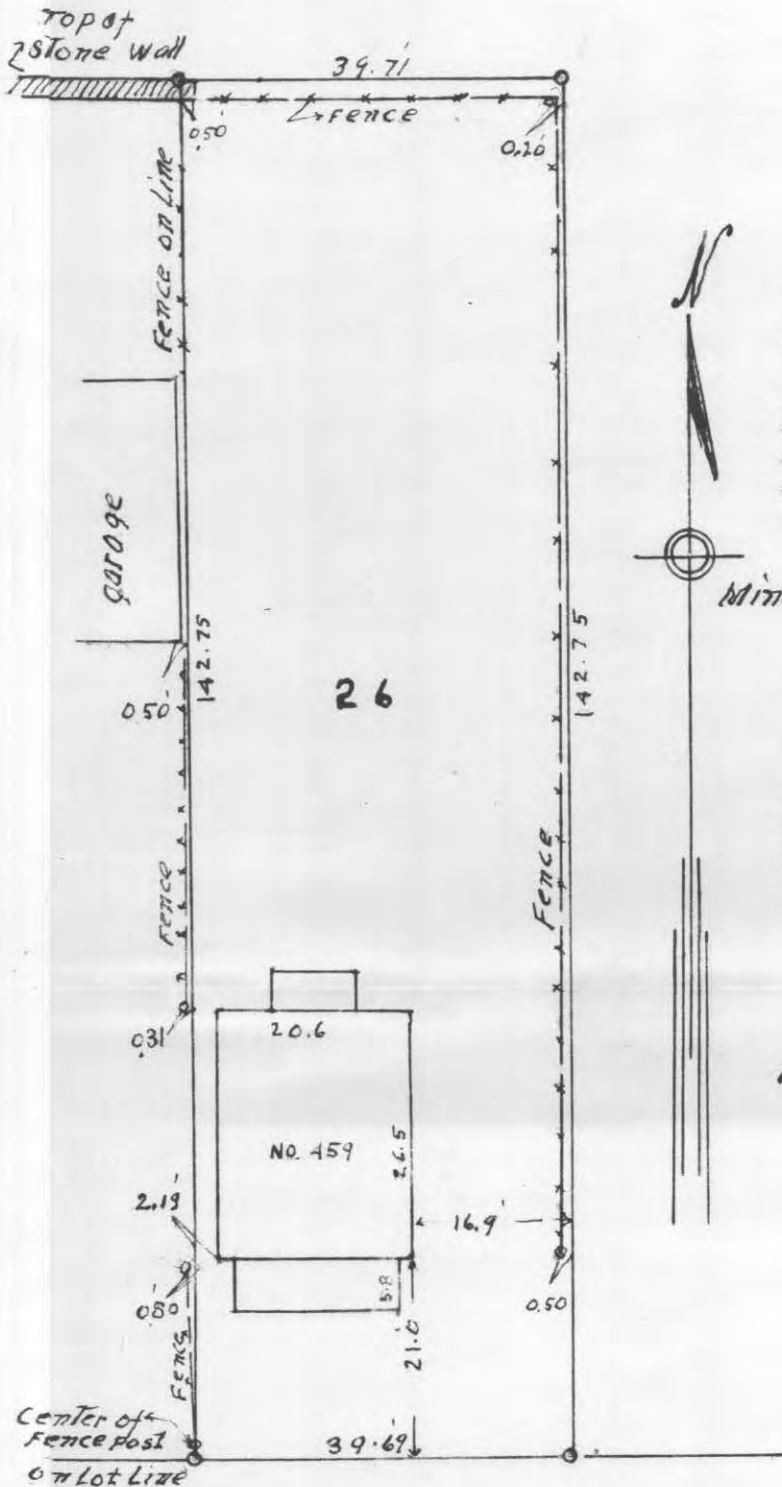

September 19 - 1950

I hereby certify to having surveyed Lot 26, Block 17 Mackubin and Marshall's Addition to St. Paul and that this plat is a correct representation of such survey and that the buildings and fences occupying and adjacent to said Lot are correctly shown hereon.

Charles F. Murray

Minn. Registered Civil Engineer and Land Surveyor
No 379

State of Minnesota }
County of Ramsey } ss

on this 20 day of September 1950 before me the undersigned personally appeared Charles Murray to me well known who being duly sworn acknowledged that he executed the foregoing certificate as his own free act and deed.

John J. Kenna

Notary Public, Ramsey County, Minnesota
My Commission expires October 17th, 1954

JOHN J. KENNA, JR.
Notary Public, Ramsey County, Minn.
My Commission Expires Oct. 17, 1954

scale - 1 inch = 20 ft.

o Indicates Iron Stake

CARROLL AVE.

6940