


# CERTIFICATE of SURVEY

F. J. ARMSTRONG  
Civil Engineer and Surveyor  
ST. PAUL, MINN.

OHIO ST.

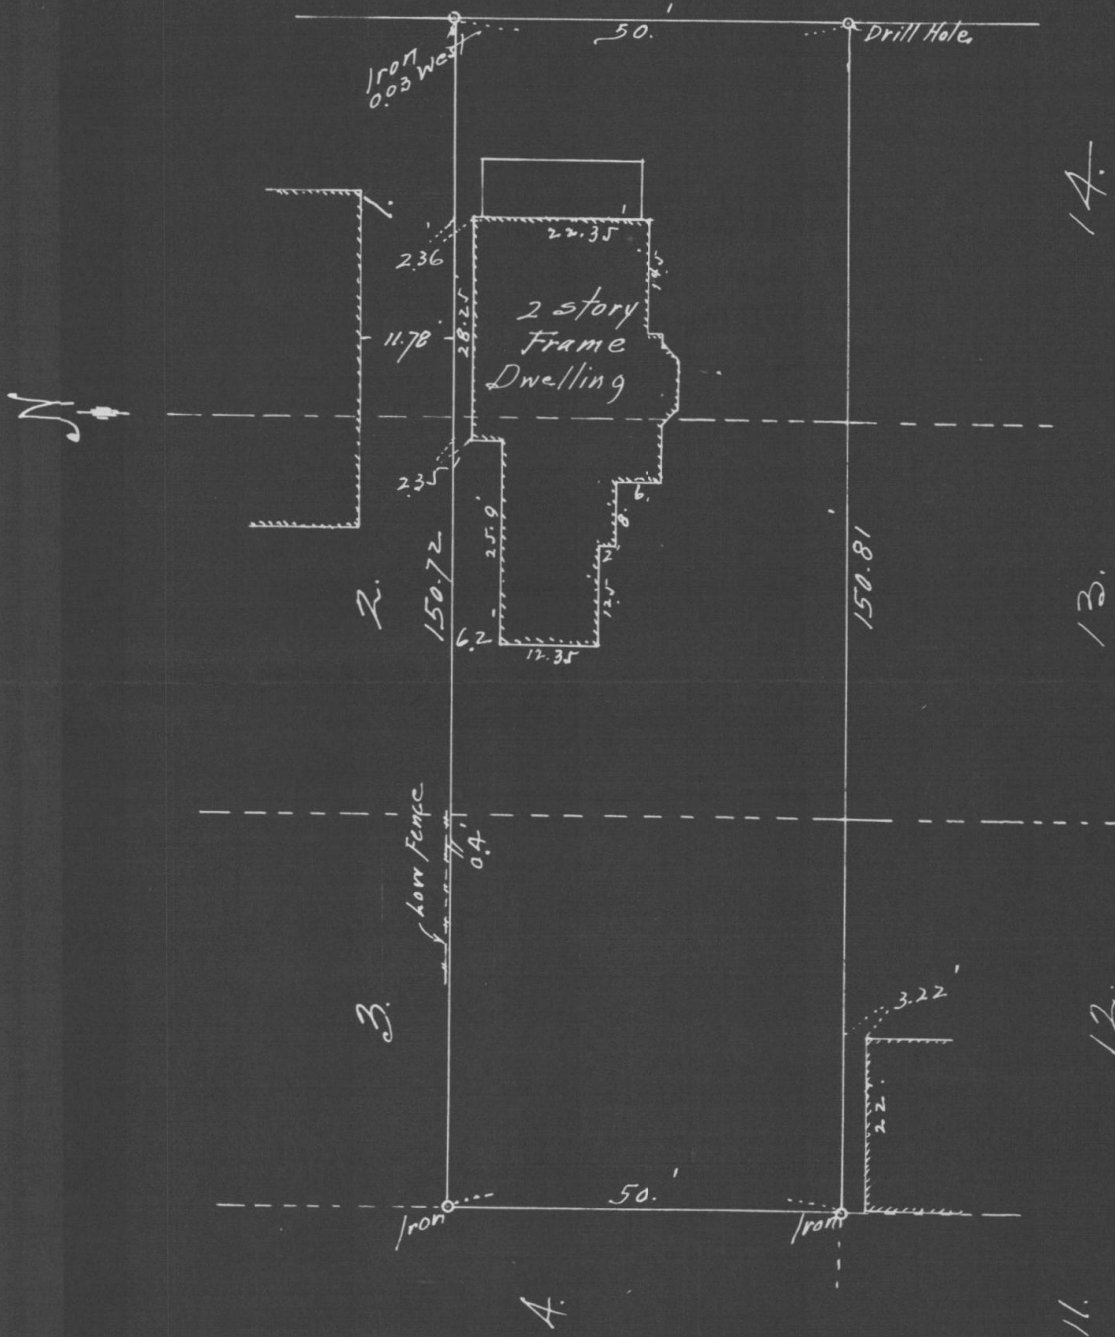

Scale 20 ft. per inch

I HEREBY CERTIFY that on the 11<sup>th</sup> day of October, A. D. 1959  
I made a survey of the following described property, to-wit: The South 1/3 of lots  
1-2 & 3 Block 101 Banning & Oliver's Addition  
to West St. Paul; and there are no encroachments  
and the map hereon shown is a true and correct map of said survey and that the improvements thereon  
indicated are correctly shown.

*F. J. Armstrong*  
Civil Engineer.

Subscribed and sworn to before me this  
..... day of ..... 19.....  
Notary Public.  
My Commission Expires.....

#1993