


CERTIFICATE of SURVEY

F. J. ARMSTRONG
Civil Engineer and Surveyor
ST. PAUL, MINN.

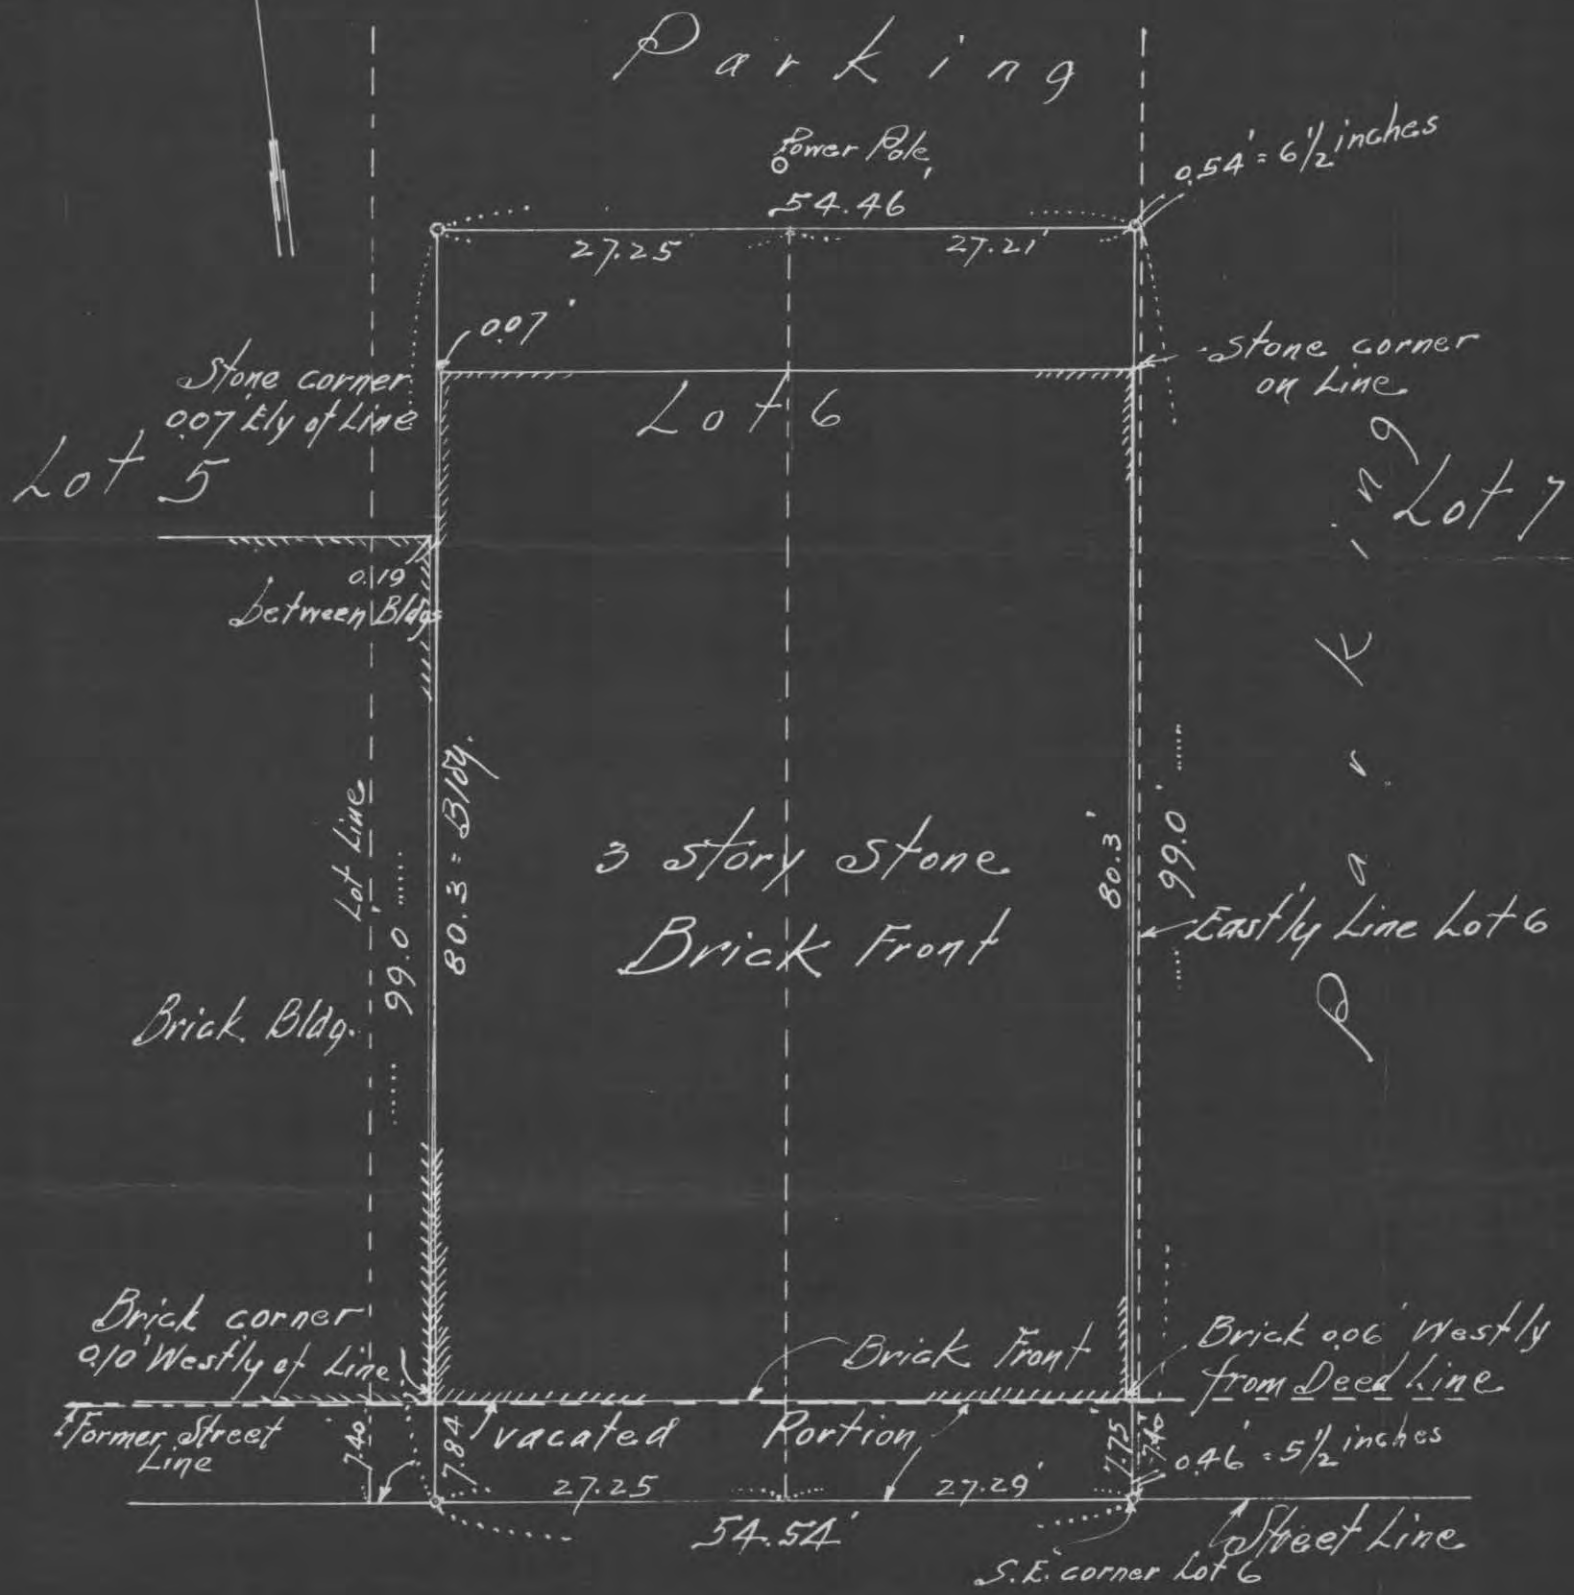

W. KELLOGG BLVD.
W. THIRD ST.

Scale 15 ft. per inch

I HEREBY CERTIFY that on the 14th day of December A. D. 1950
I made a survey of the following described property, to-wit: Part of Lot 6 Block 17
Rice and Irvines Addition to St. Paul

Subscribed and sworn to before me this
..... day of, 19.....

and the map hereon shown is a true and correct map of said survey and that the improvements thereon
indicated are correctly shown.

My Commission Expires.....

F. J. Armstrong Civil Engineer.