


7031

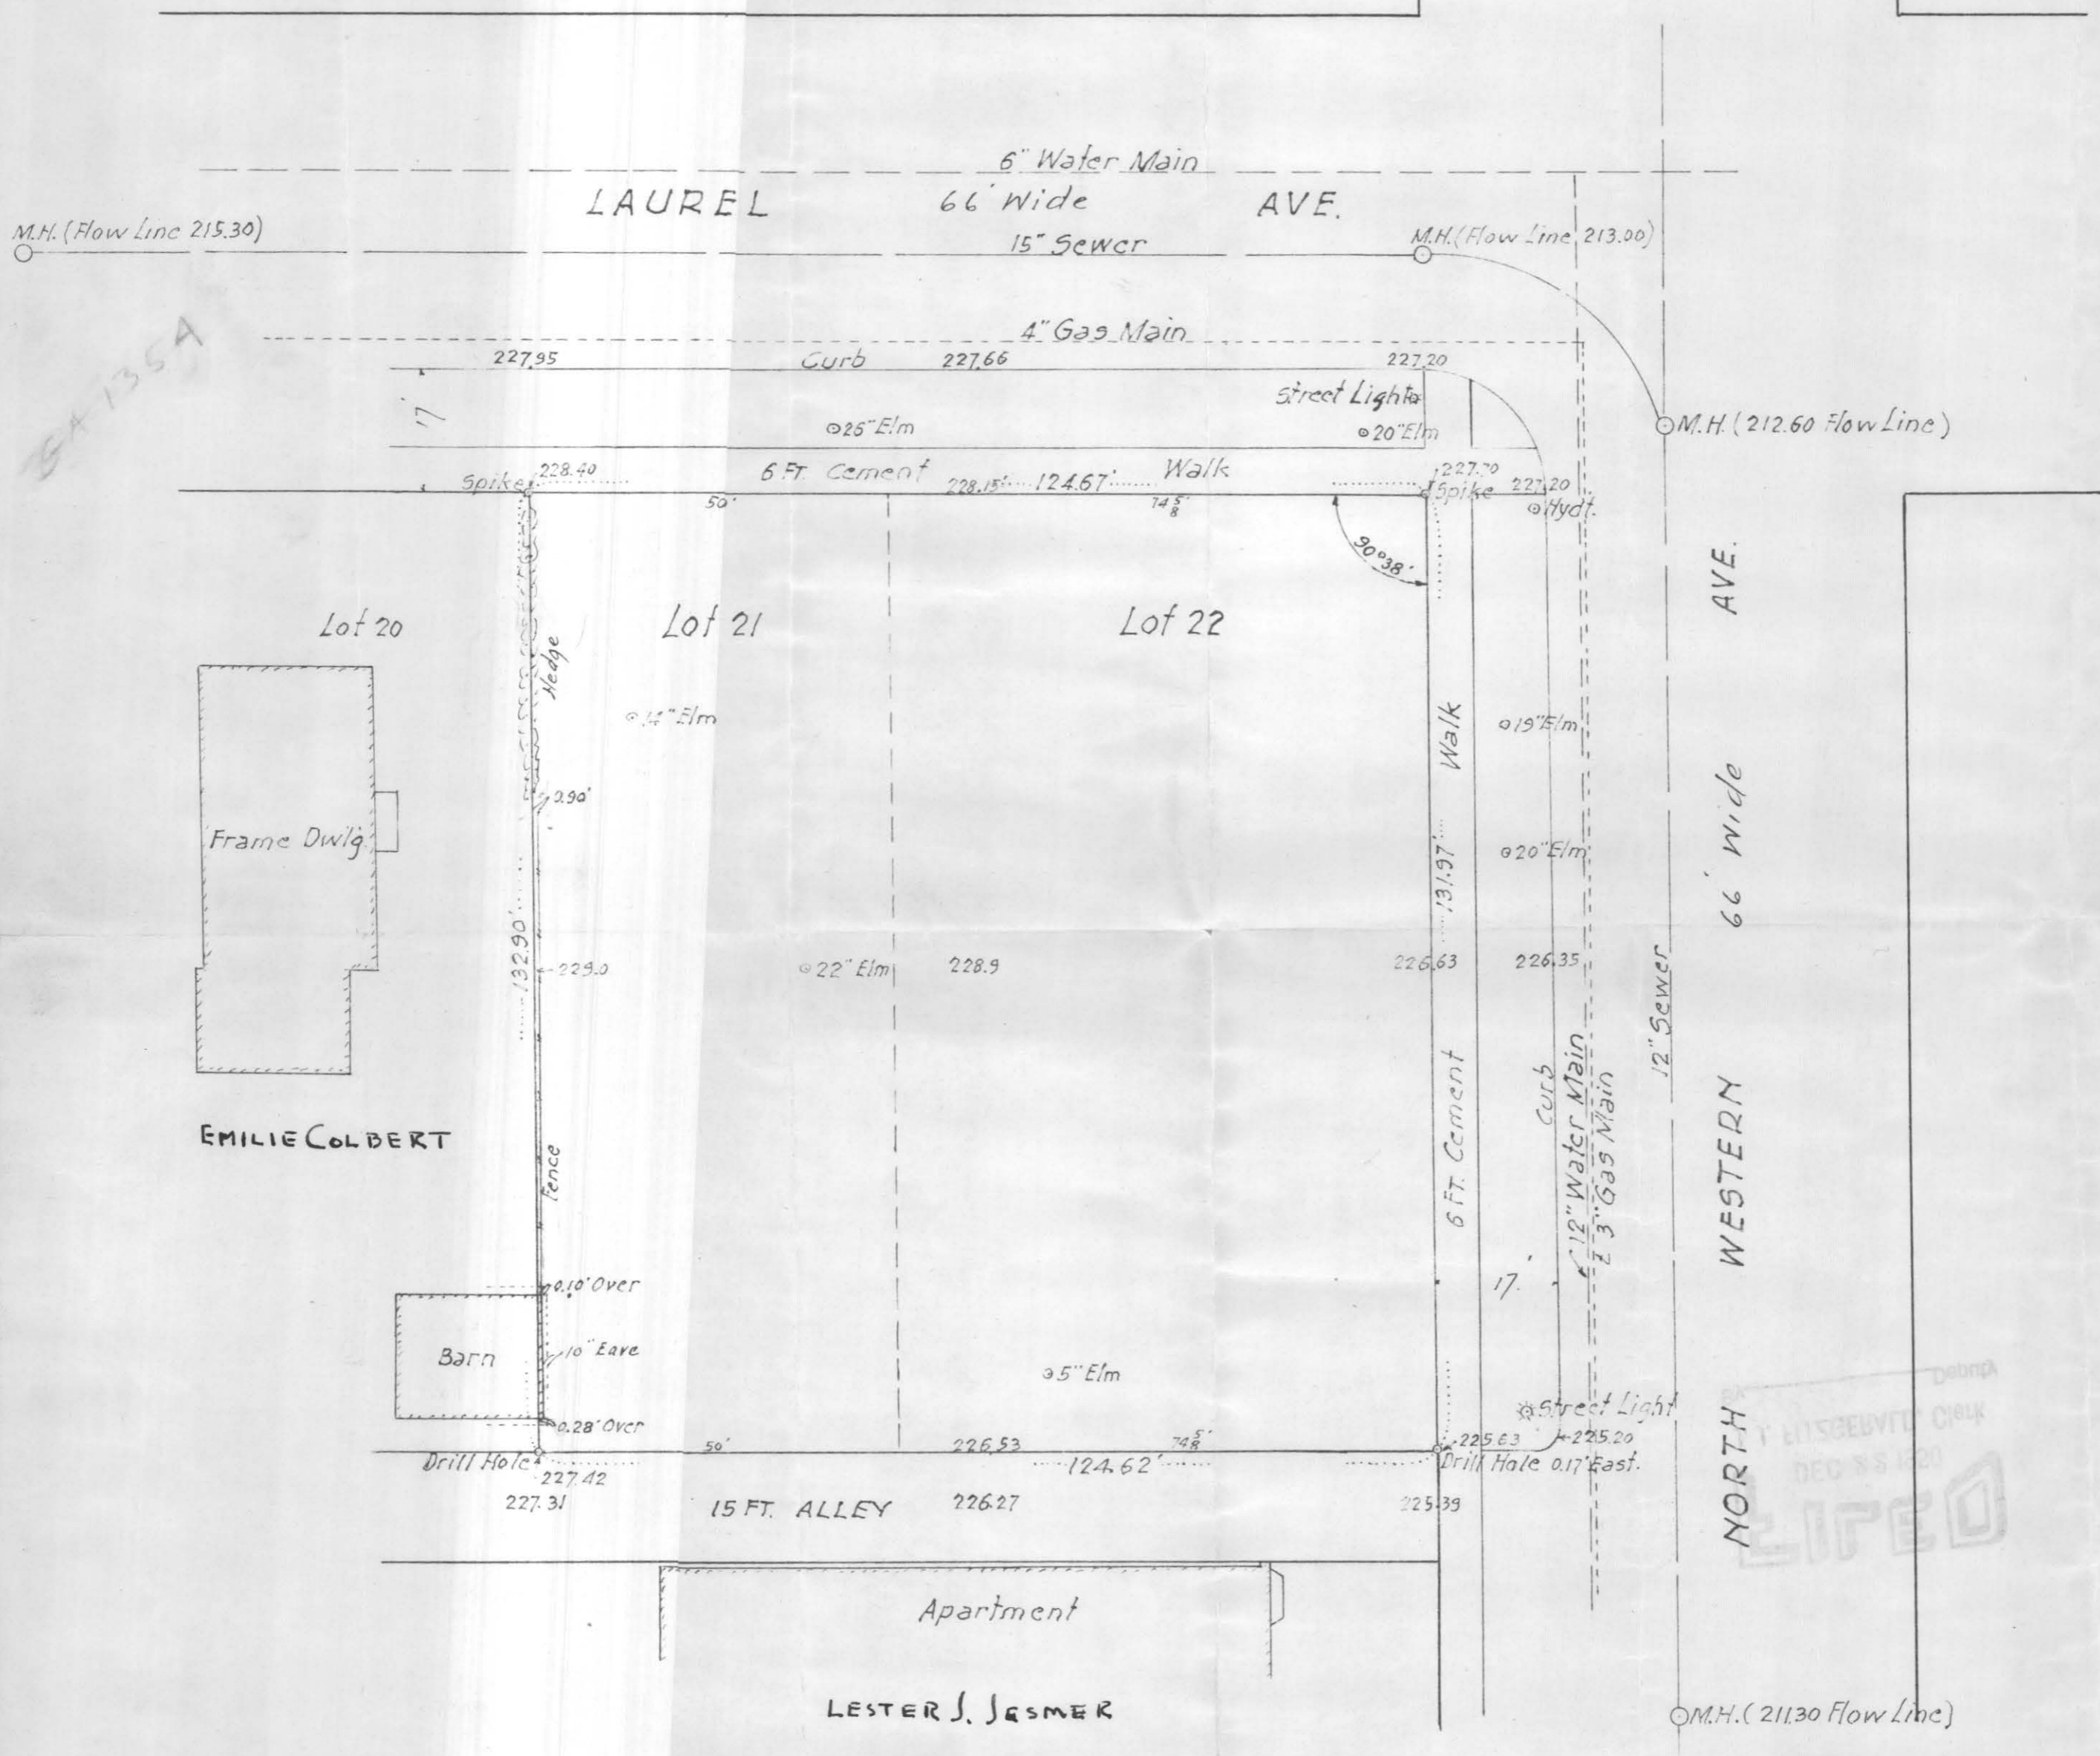

EX-135A

Lot 20
 Frame Dwlg
 EMILIE COLBERT

Barn
 Drill Hole
 227.31

LESTER J. JESMER

NORTH WESTERN AVE. 66' Wide

PLAT OF SURVEY OF LOTS 21 AND 22 BLOCK 12
 WOODLAND PARK ADD. TO CITY OF ST. PAUL.
 Scale 1" = 20'

Jan. 31st 1950.
 F. J. Armstrong
 Civil Engr.

7031