


CERTIFICATE of SURVEY

F. J. ARMSTRONG
Civil Engineer and Surveyor
ST. PAUL, MINN.

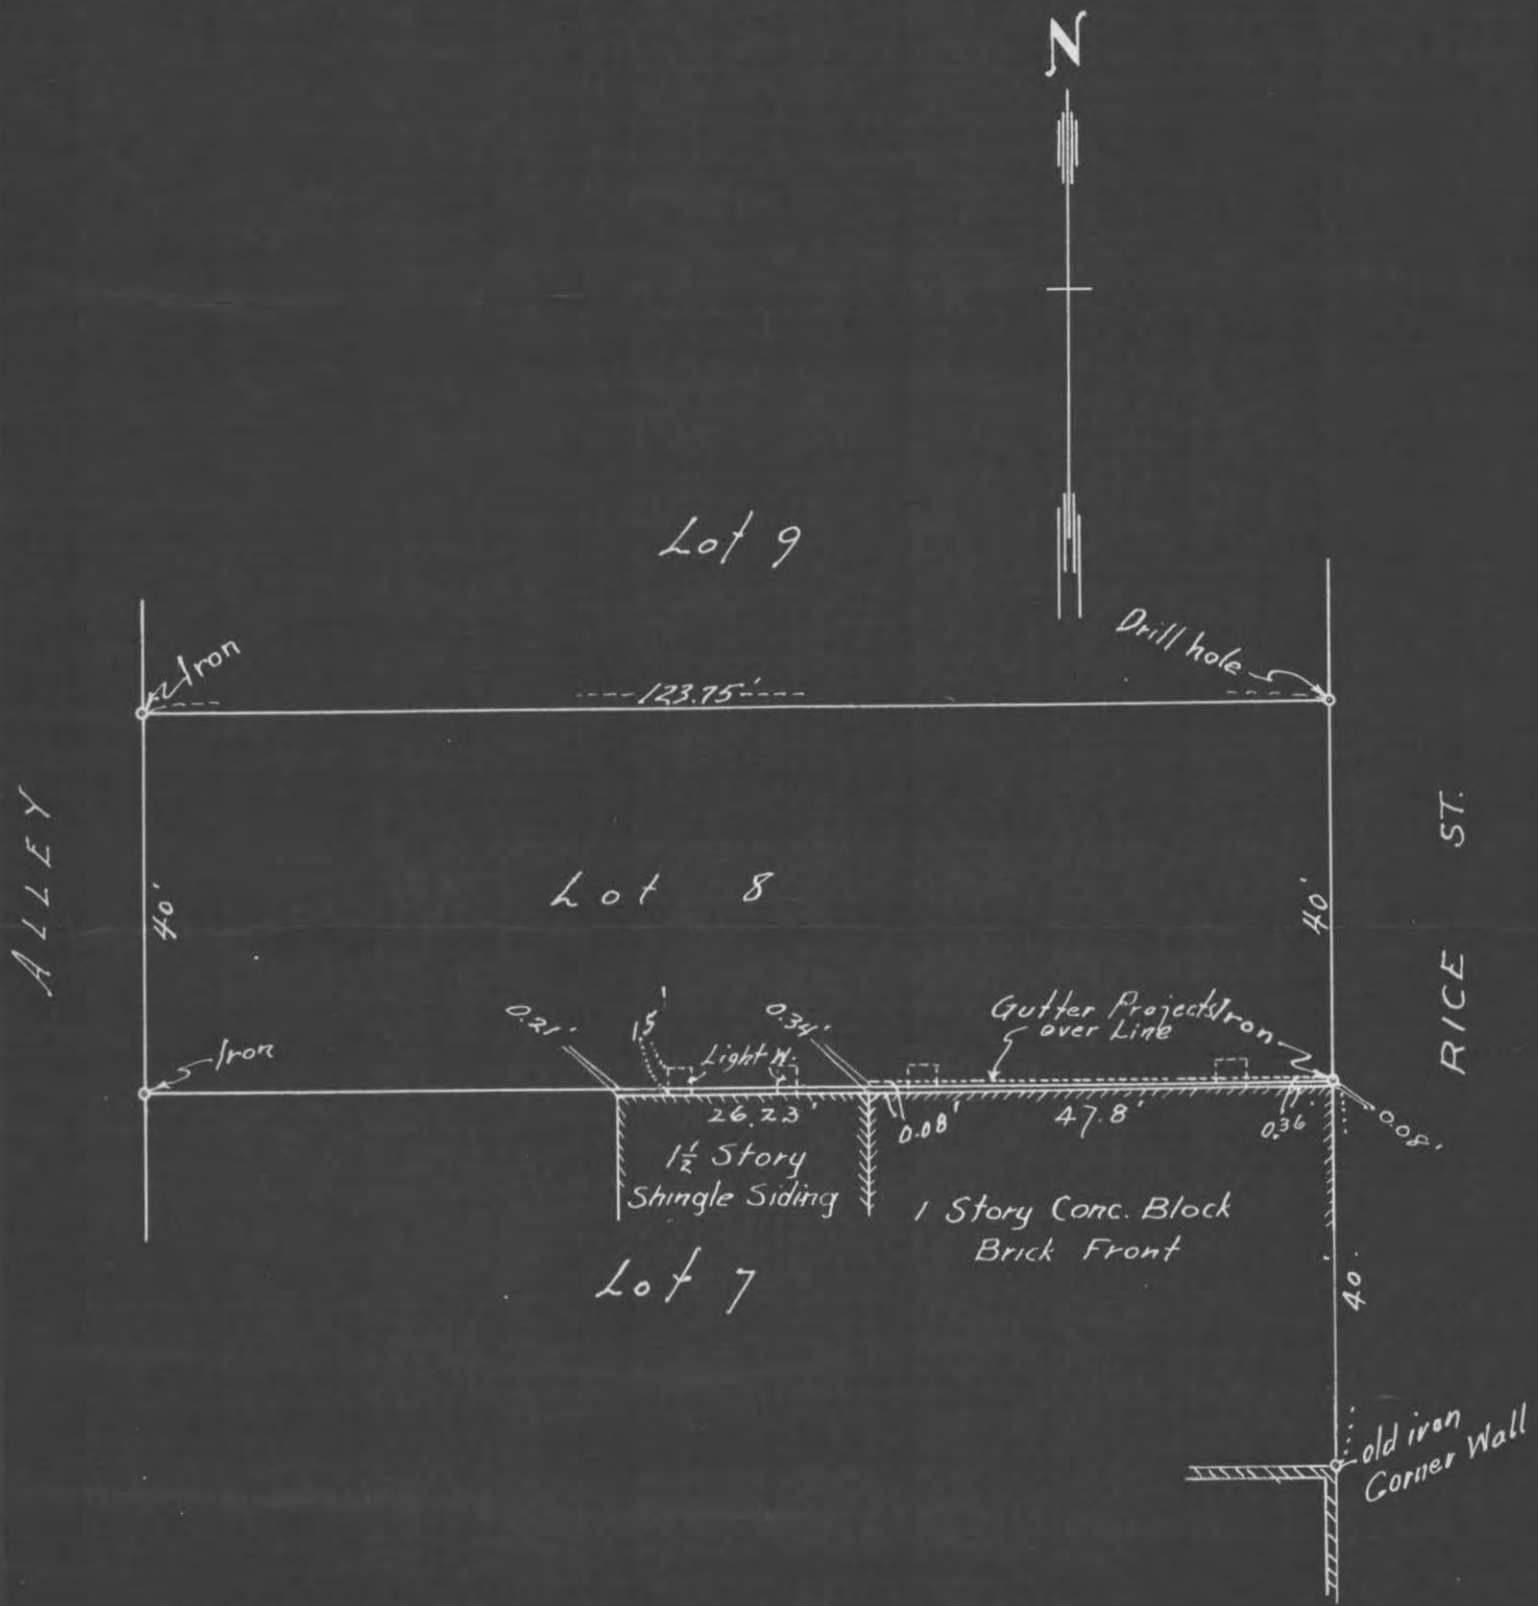

Scale 1" = 20'

I HEREBY CERTIFY that on the 31st day of October, A. D. 1950

I made a survey of the following described property, to-wit: Lot 8, Block 2
Weides Addition + Rearrangement of Paists Out Lots
St. Paul Minn

and the map hereon shown is a true and correct map of said survey and that the improvements thereon indicated are correctly shown and there are no encroachments except as indicated

F. J. Armstrong Civil Engineer.

Subscribed and sworn to before me this
31st day of October, 1950
Notary Public.

My Commission Expires

7066