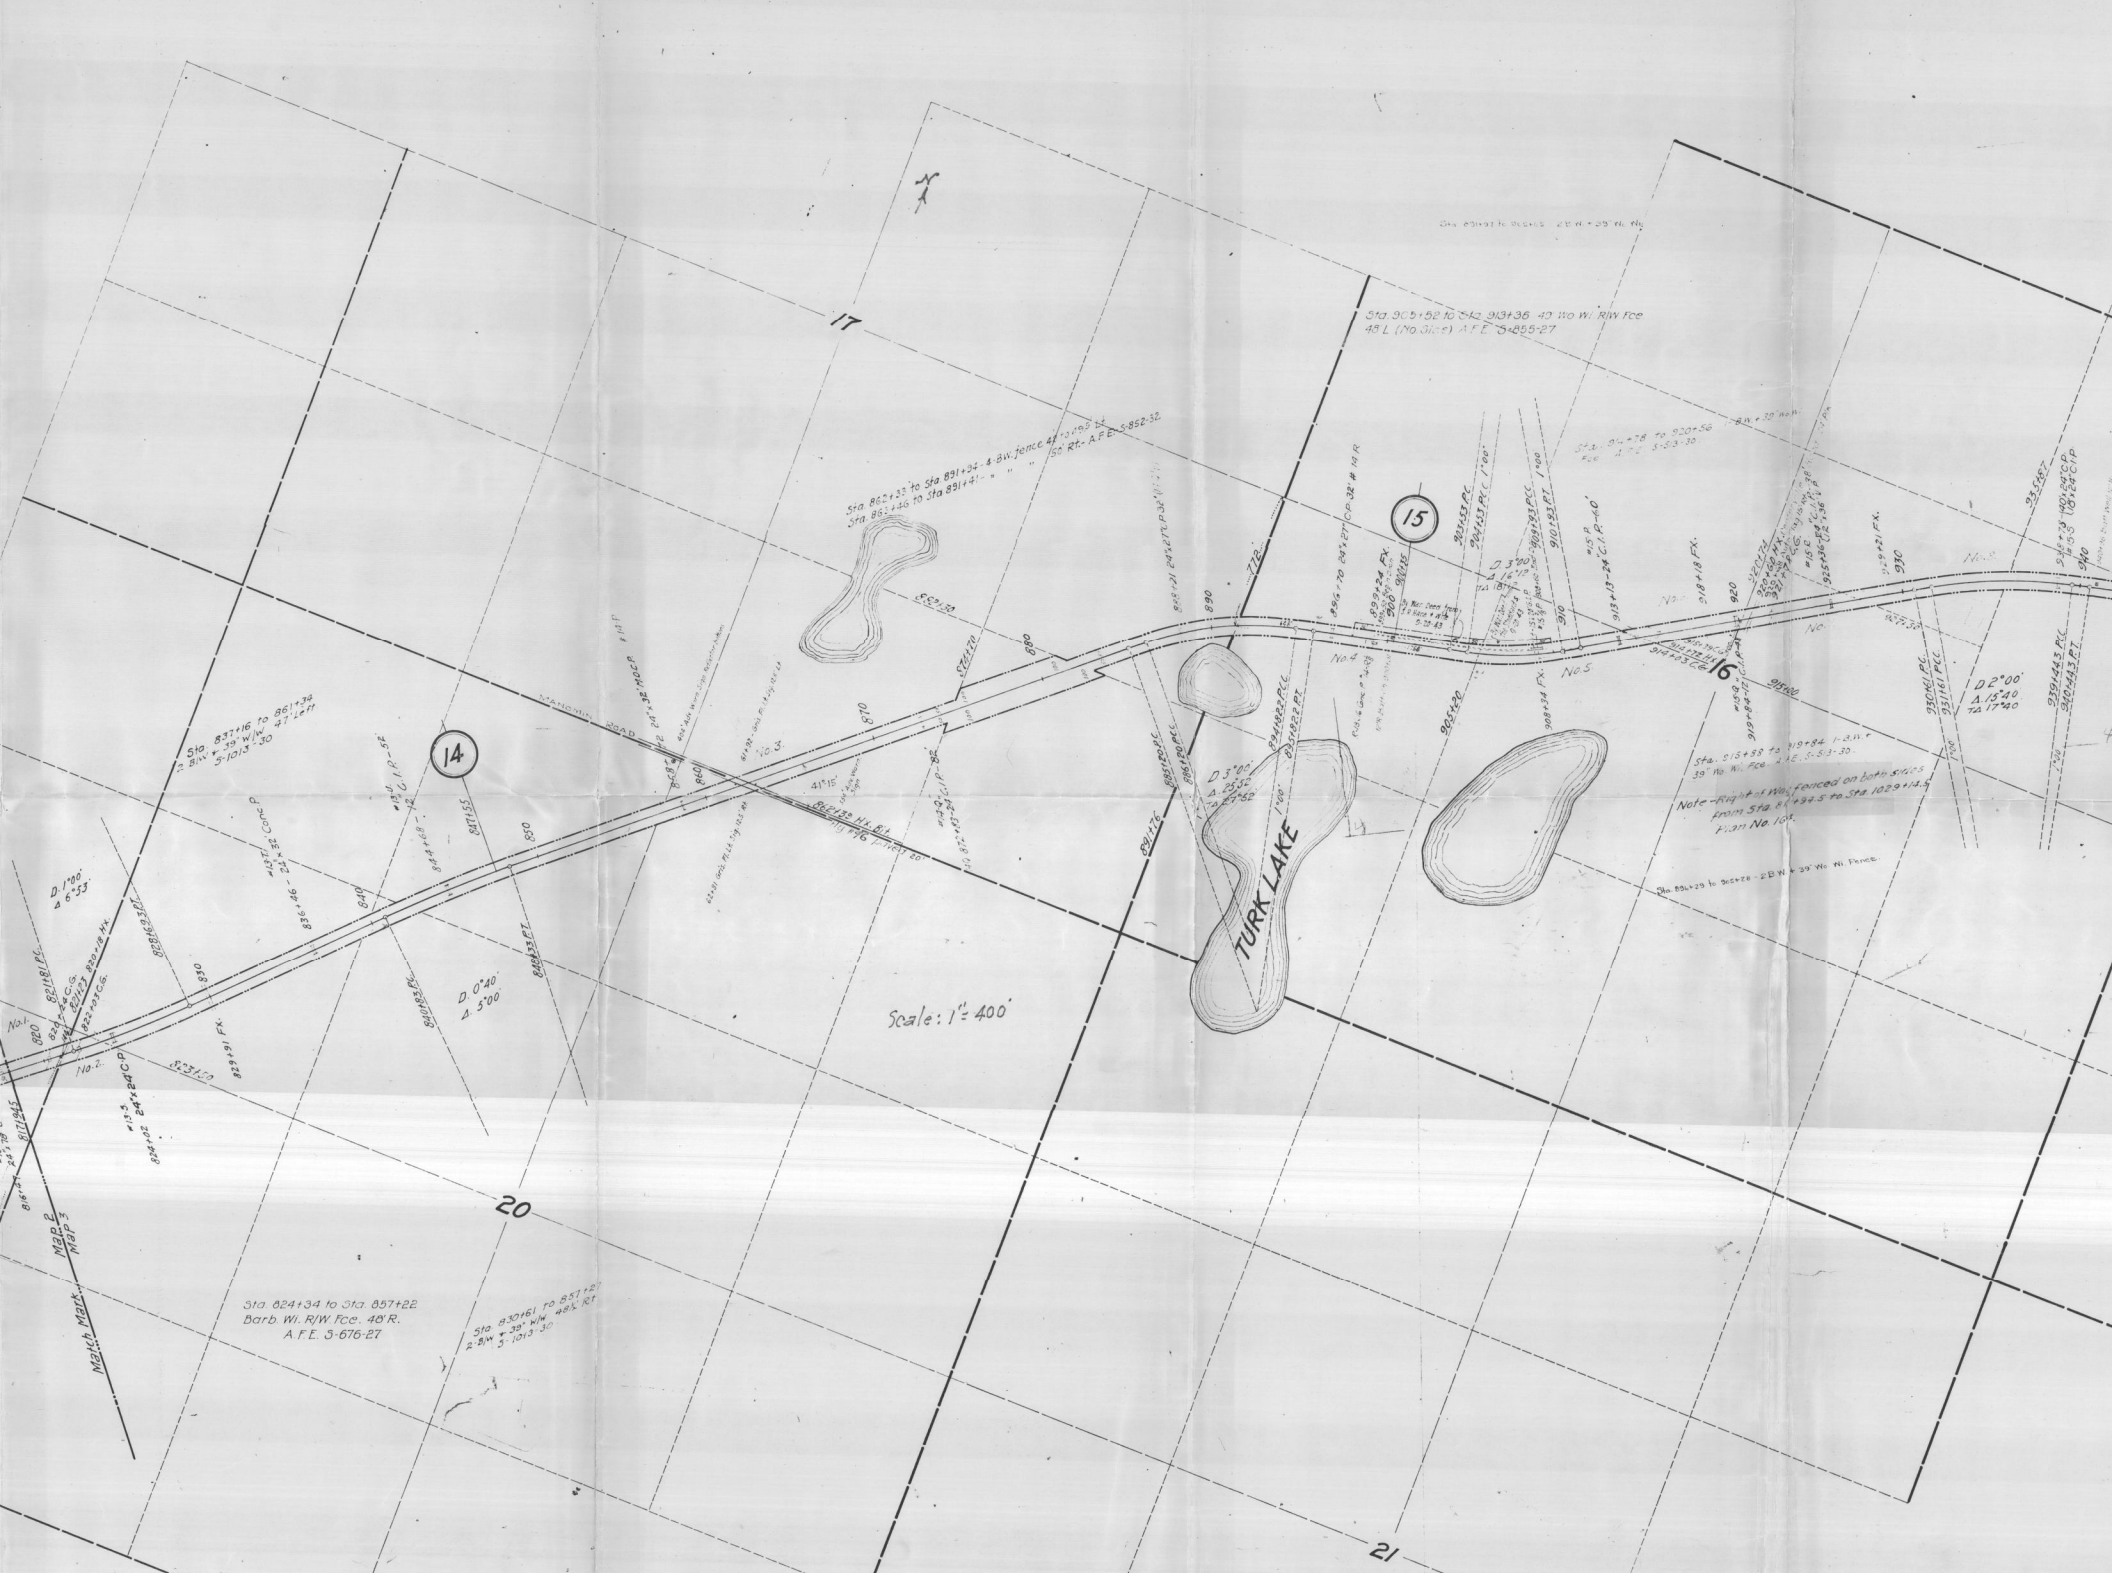
TURK LAKE
Scale: 1" = 400'
17
16
15
14
20
21
Sta. 824+34 to Sta. 857+22
Barb. Wi. R/W Fce. 48' R.
A.F.E. S-676-27
Sta. 830+61 to 857+27
2 Bw + 39" W/W
3-1013-30
Sta. 837+16 to 861+38
2 Bw + 39" W/W
3-1013-30
Sta. 862+33 to Sta 891+24 - 4 Bw. fence 47' R.
Sta. 861+40 to Sta 891+41 - " " " 50' Rt. - A.F.E. S-852-32
Sta. 905+52 to Sta. 913+36 49' Wo Wi. R/W Fce
48' L (No. Side) A.F.E. S-855-27
Sta. 914+78 to 920+56
Fce. A.F.E. S-53-30
Sta. 915+88 to 919+84 1-8 W.F.
39" Wo Wi. Fce. A.F.E. S-53-30
Note - Right of Way fenced on both sides
from Sta. 915+94.5 to Sta. 1029+14.5
Plan No. 164.
Sta. 854+29 to 902+28 - 2 B.W. + 39" Wo Wi. Fence
Match Mark
Map 2
Map 3
No. 1
No. 2
No. 3
No. 4
No. 5
No. 6
No. 7
No. 8
D 1°00'
Δ 6°53'
D 0°40'
Δ 5°00'
D 3°00'
Δ 25°55'
Ta 237'52"
D 3°00'
Δ 16°12'
Ta 148'42"
D 2°00'
Δ 15°40'
Ta 137'40"