OFFICE OF
MILNER W. CARLEY
ENGINEER - SURVEYOR

SURVEY OF

Except the East 30 ft., lot 5, Blk. 3, Elfelt Bernheimer and Arnolds' Addition

AND

Except University Avenue, the East 21 ft. of the West 27.62 ft. of Lot 5, Blk. 3, Chamber's Addition.

November 1949 Scale 1" - 50'

o indicates iron

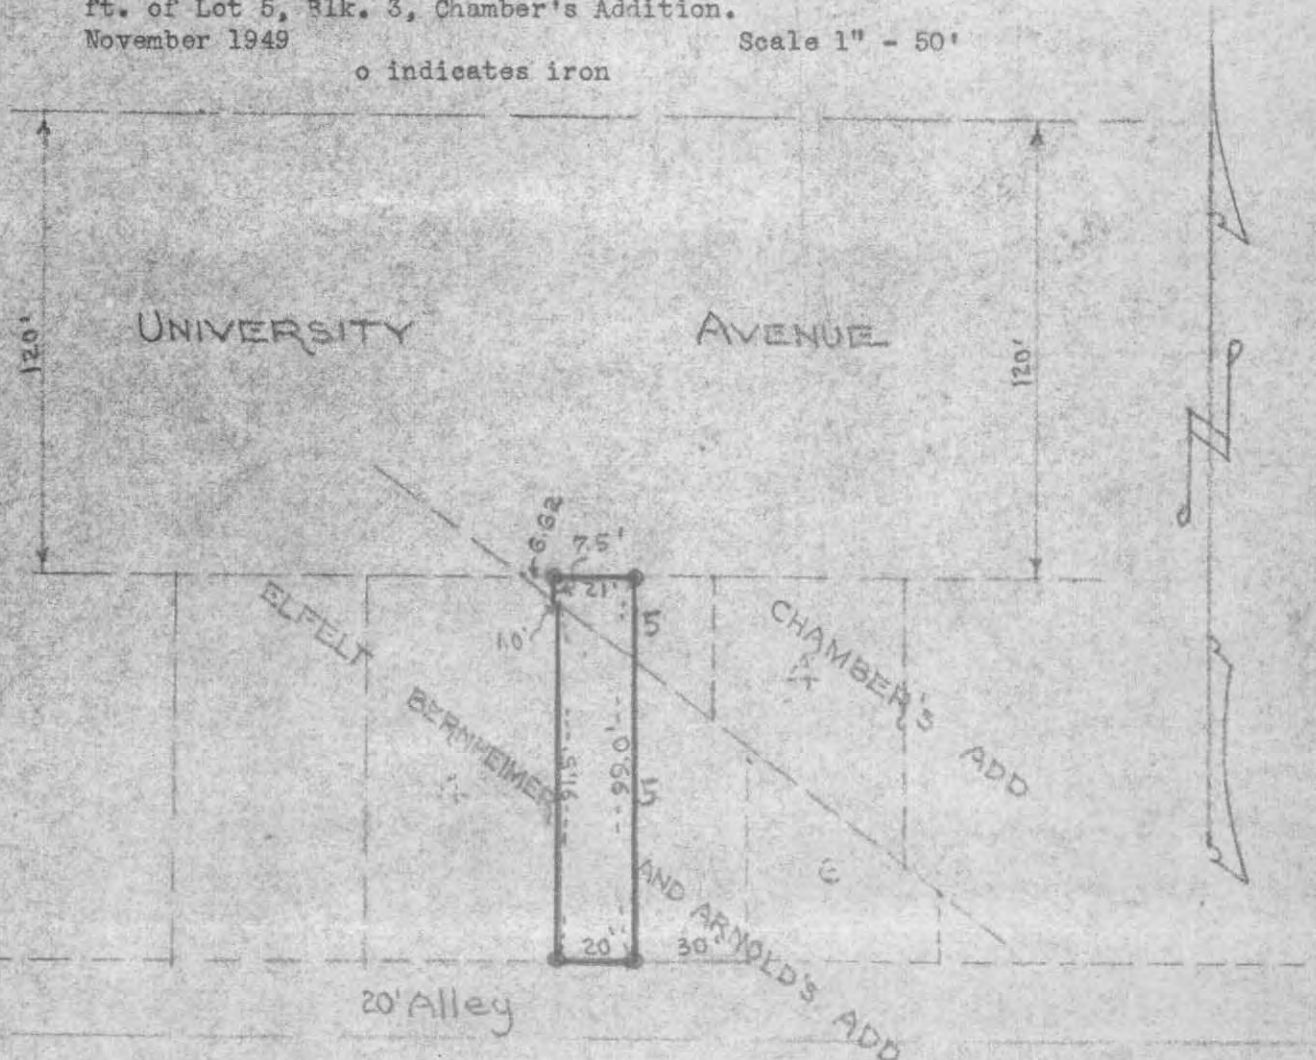

I hereby certify that this survey, plan, or report was prepared by me or under my direct supervision and that I am a duly Registered Land Surveyor under the laws of the State of Minnesota.

Milner W. Carley

Date 3/22/51 Reg. No. 855

Milner W. Carley
REGISTERED SURVEYOR NO. 855

#7142 739